


PARENT PARCEL: 18-00-029-000-105

CHILD PARCEL: 18-00-029-000-135, -136

STARTING POINT: INTERSECTION OF CENTERLINE OF HERITAGE DR & PATRIOT DR

16-03509

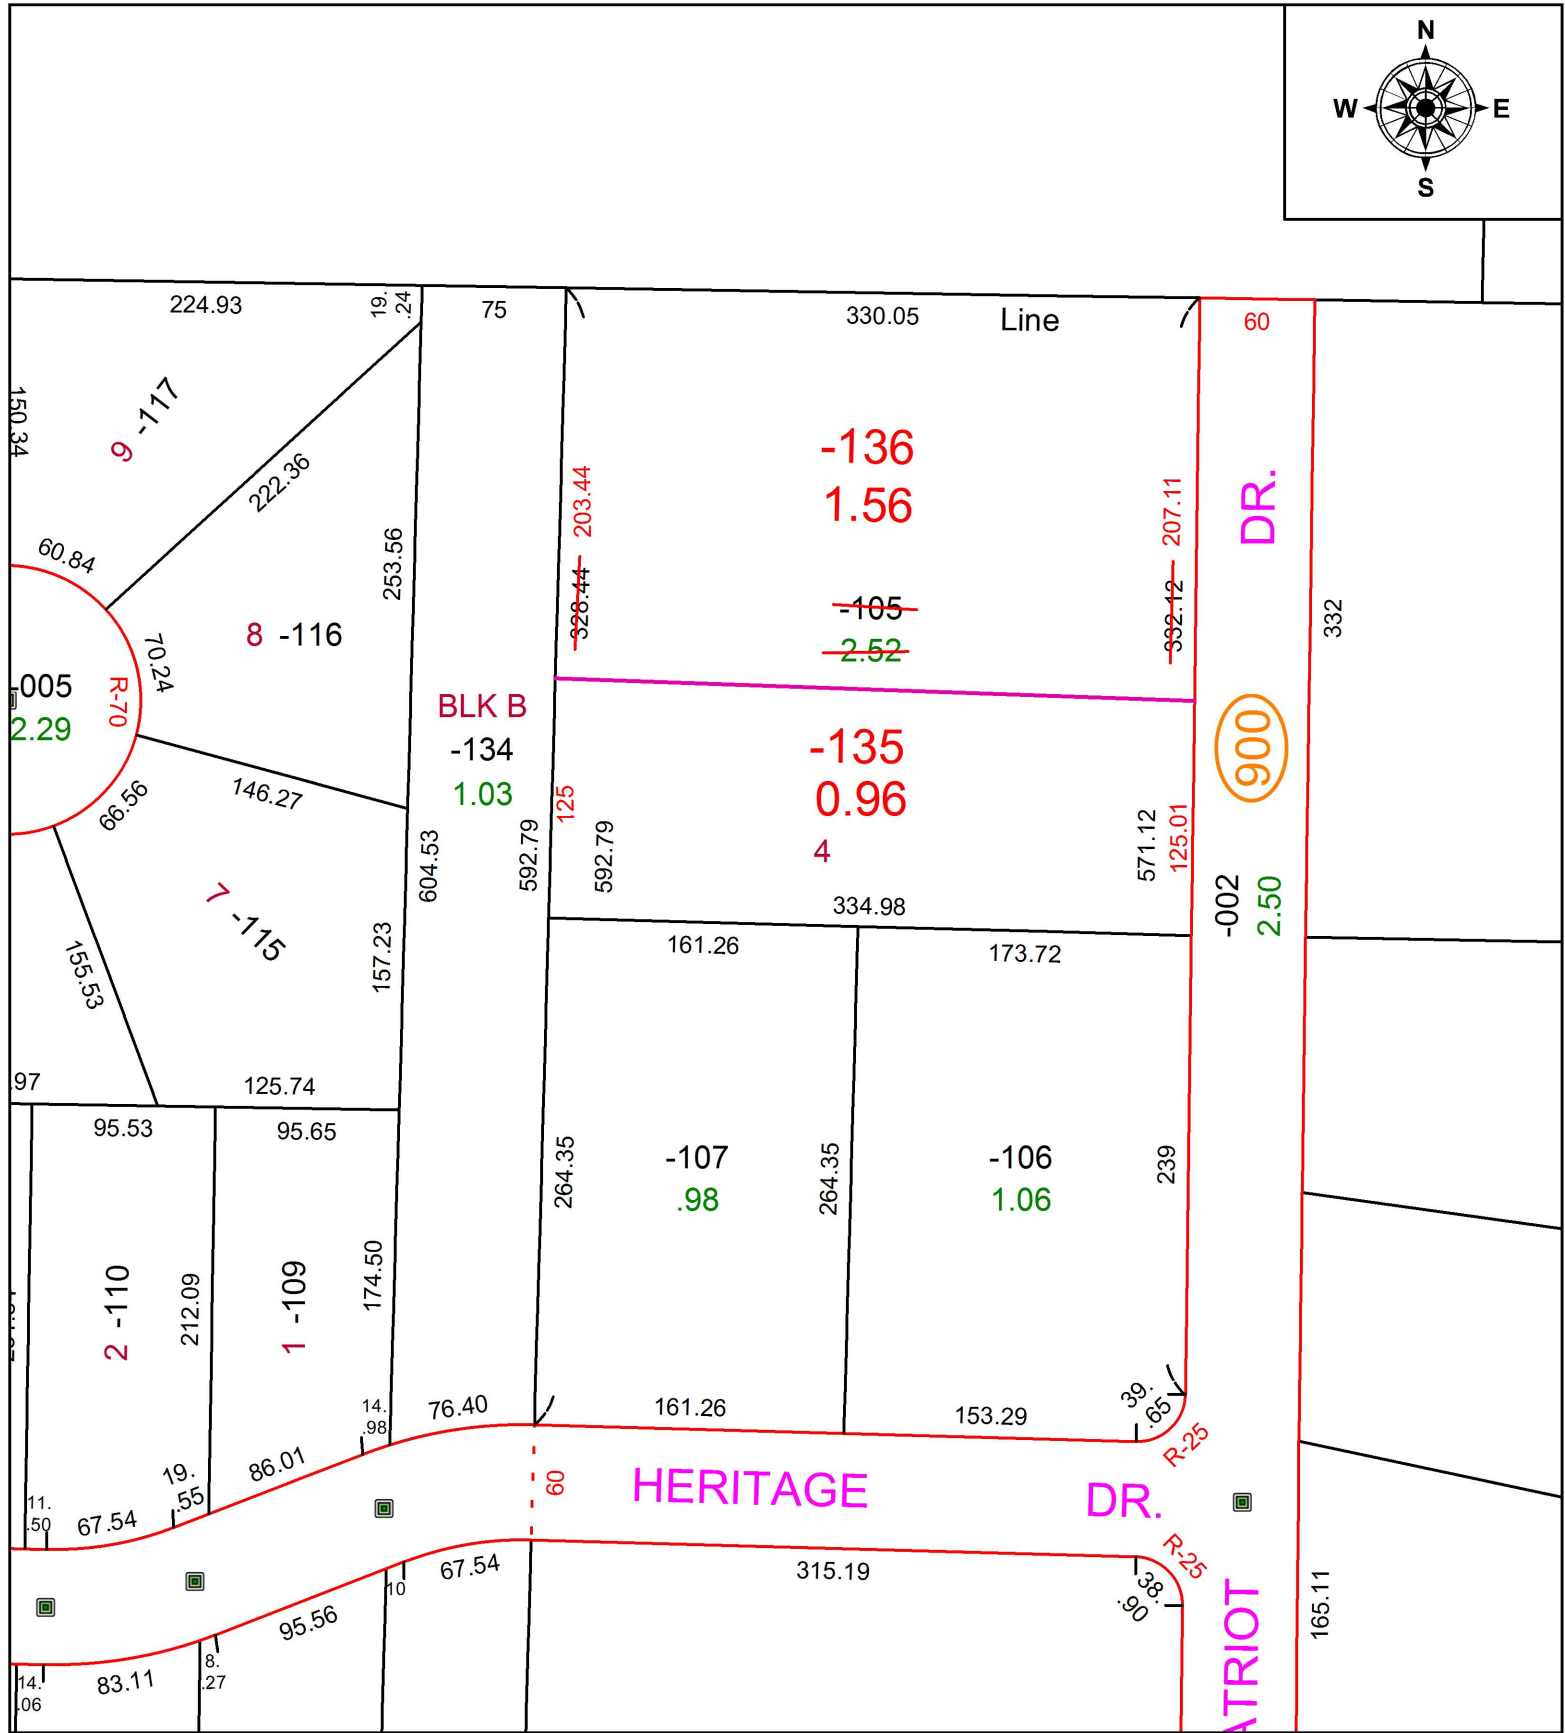

SPLITS/DEEDS PROCESSED
LORAIN COUNTY TAX MAP DEPARTMENT
226 MIDDLE AVE. ELYRIA, OH

SURVEYED BY: AMY KELLY
CLOSURE: 1:187669
MAP PAGE(S): 18-00-029
APPROVED BY: JAH DATE: 04-21-2016
SCALE: 1 in = 100 ft PRIOR INSTRUMENT: 20060166235