

PARENT PARCEL: 04-00-013-000-570, -566



CHILD PARCEL: 04-00-013-000-573 THRU -575

STARTING POINT: CENTERLINE OF RIEGELSBERGER RD & O.L.13

16-03510



200

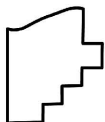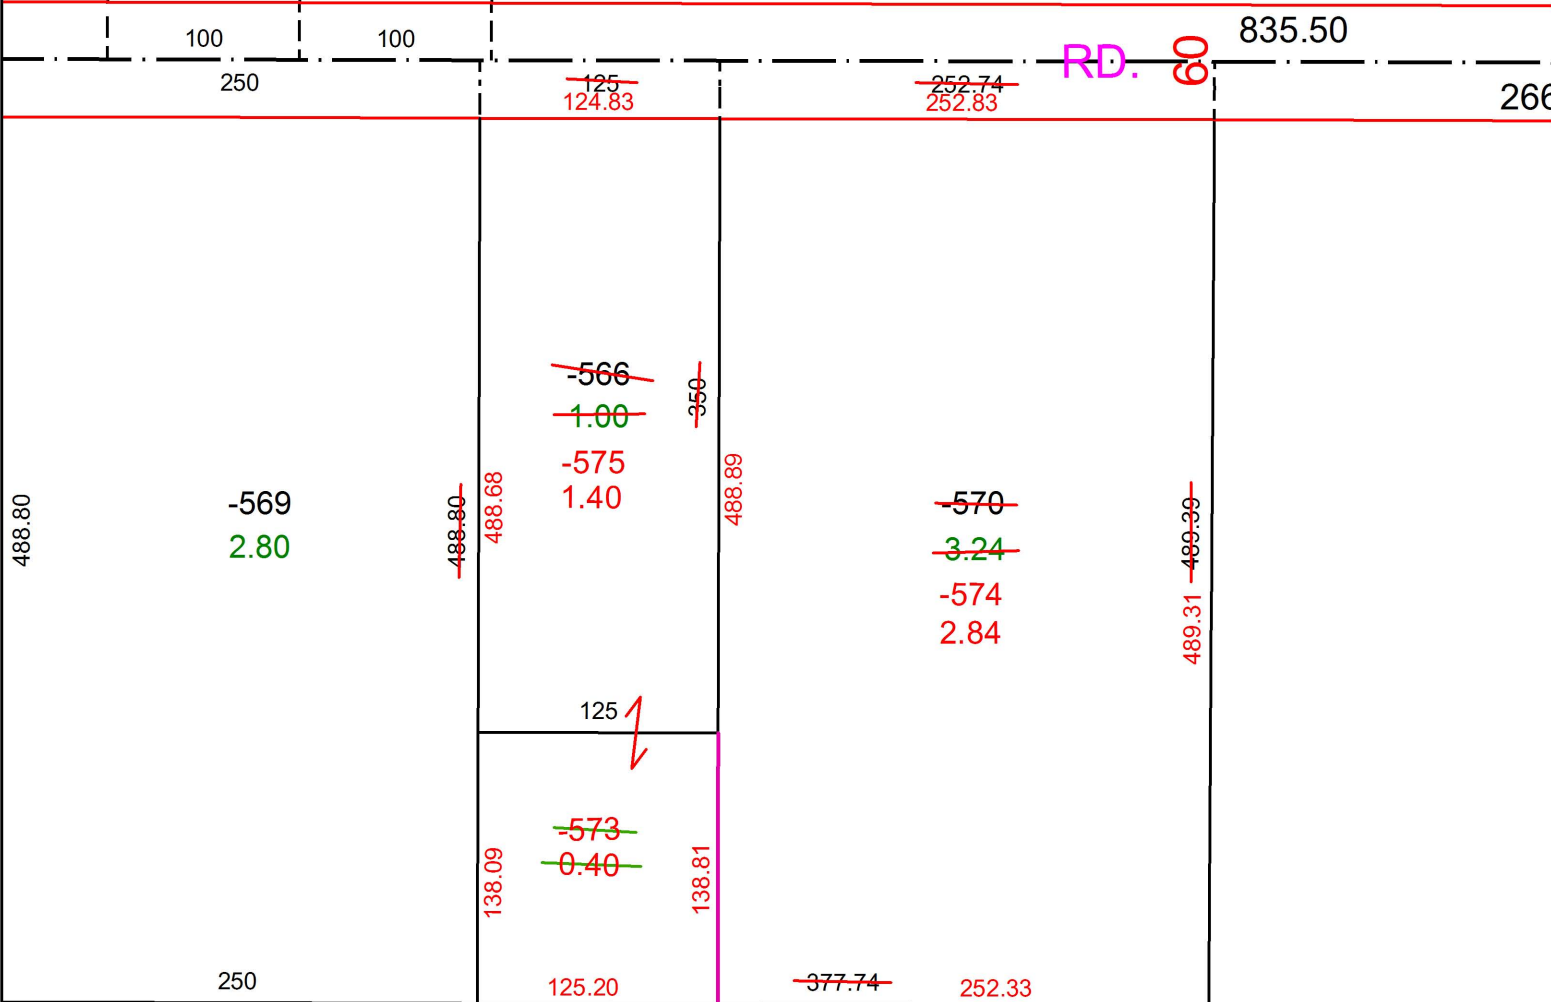

**SPLITS/DEEDS PROCESSED**  
 LORAIN COUNTY TAX MAP DEPARTMENT  
 226 MIDDLE AVE. ELYRIA, OH

SURVEYED BY: MICHAEL SPELLACY  
 CLOSURE: 1:175209  
 MAP PAGE(S): 04-00-13  
 APPROVED BY: JAH DATE: 4/28/2016  
 SCALE: 1 in = 100 ft PRIOR INSTRUMENT: 20080250993