

PARENT PARCEL: 15-00-098-108-282

CHILD PARCEL: 15-00-098-108-287, -288

STARTING POINT: NORTHWESTERLY CORNER OF SUBLOT 457 IN PHEASANT RUN VILL. PH 1

16-03512




885

373.03

Pt. 17.47

900

RD.

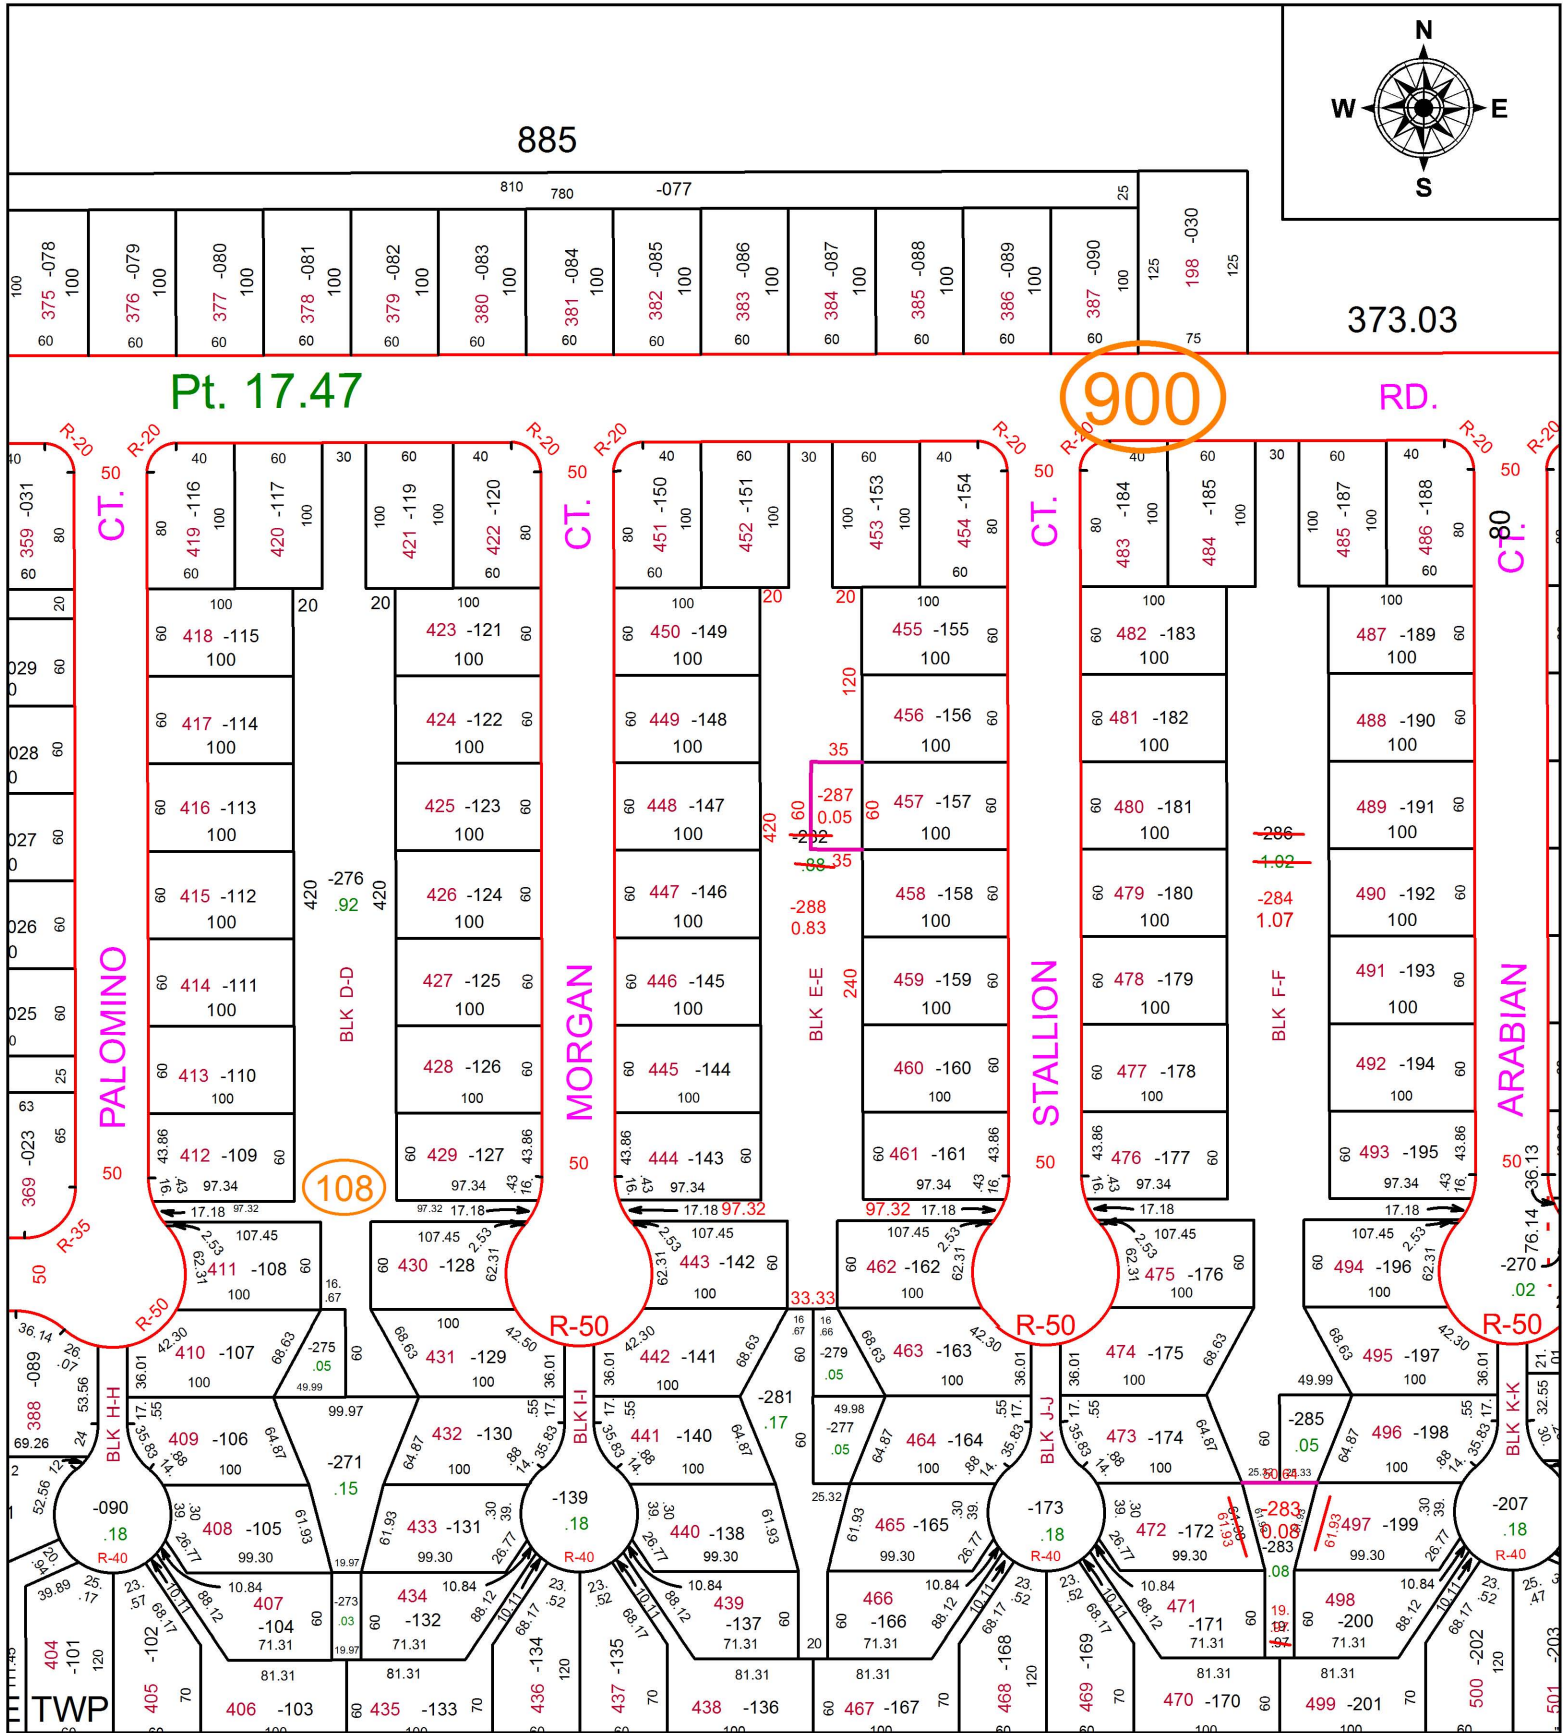

**SPLITS/DEEDS PROCESSED**

LORAIN COUNTY TAX MAP DEPARTMENT  
226 MIDDLE AVE. ELYRIA, OH

SURVEYED BY: THOMAS SIMON

CLOSURE: 1:-2147483648

MAP PAGE(S): 15-00-098

APPROVED BY: JAH DATE: 4/27/2016

SCALE: 1 in = 132 ft PRIOR INSTRUMENT: 20150554268