


PARENT PARCEL: _____

CHILD PARCEL: 01-00-016-116-022, 01-00-016-117-131

STARTING POINT: _____



16-03514-V

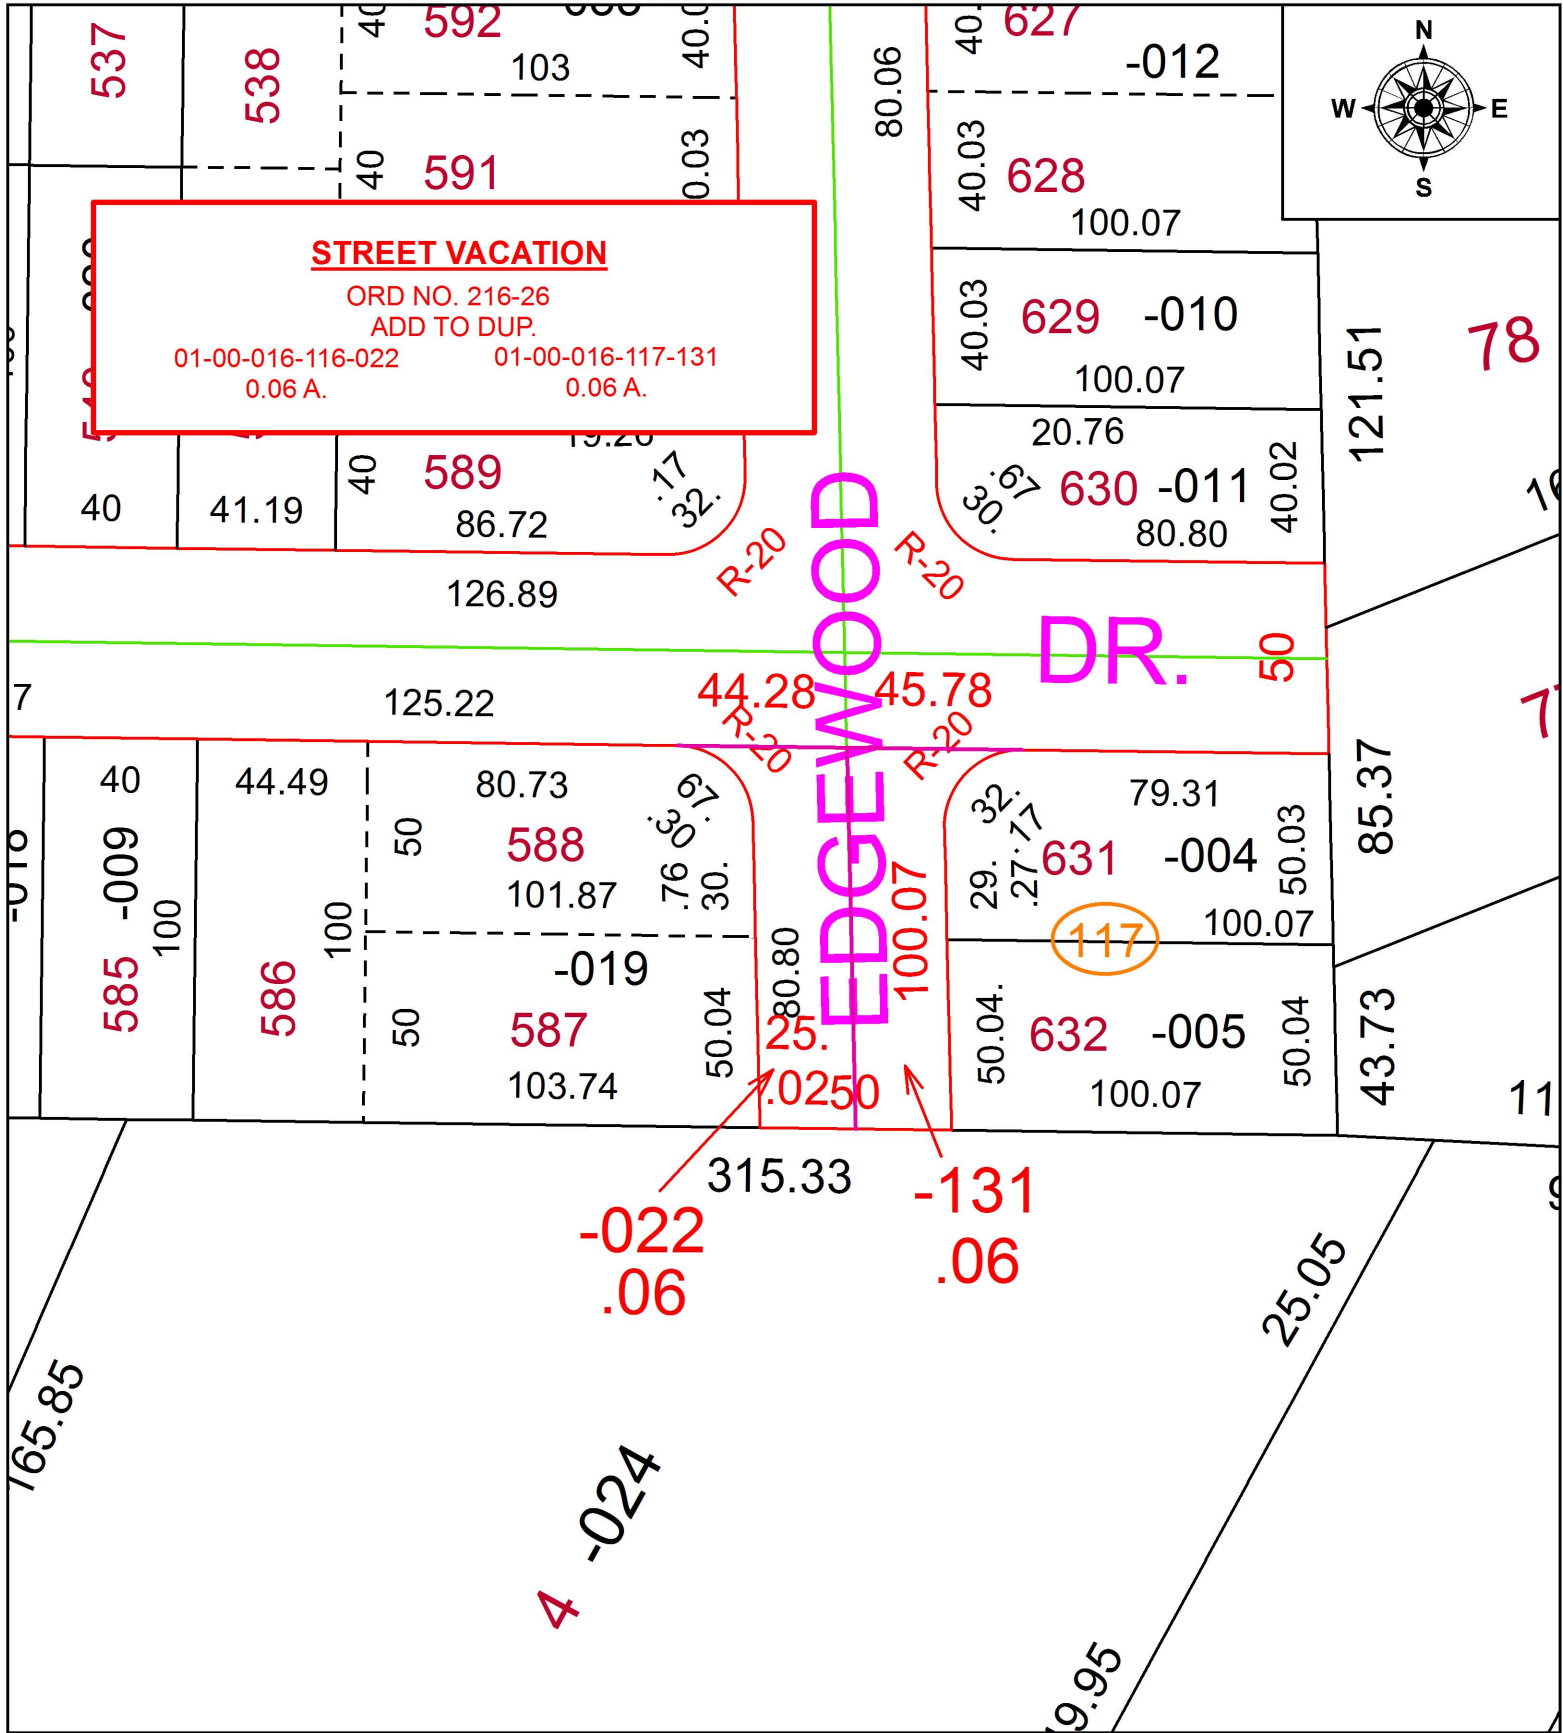

STREET VACATION

ORD NO. 216-26
 ADD TO DUP.
 01-00-016-116-022 01-00-016-117-131
 0.06 A. 0.06 A.

EDGEWOOD DR.

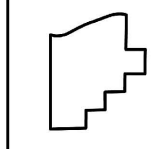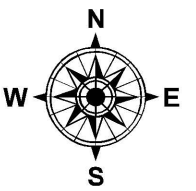

SPLITS/DEEDS PROCESSED
 LORAIN COUNTY TAX MAP DEPARTMENT
 226 MIDDLE AVE. ELYRIA, OH

SURVEYED BY: THOMAS M. SNEZEK
 CLOSURE: 1: 40,233
 MAP PAGE(S): 1-00-016-A
 APPROVED BY: RRM DATE: 9-8-16
 SCALE: 1" = 50' PRIOR INSTRUMENT: ORD NO.216-26