



PARENT PARCEL: 01-00-001-102-009
CHILD PARCEL: 01-00-001-102-042, -043
STARTING POINT: CORNER OF S/L 9 IN ELBERTA BEACH SUBD

16-03516

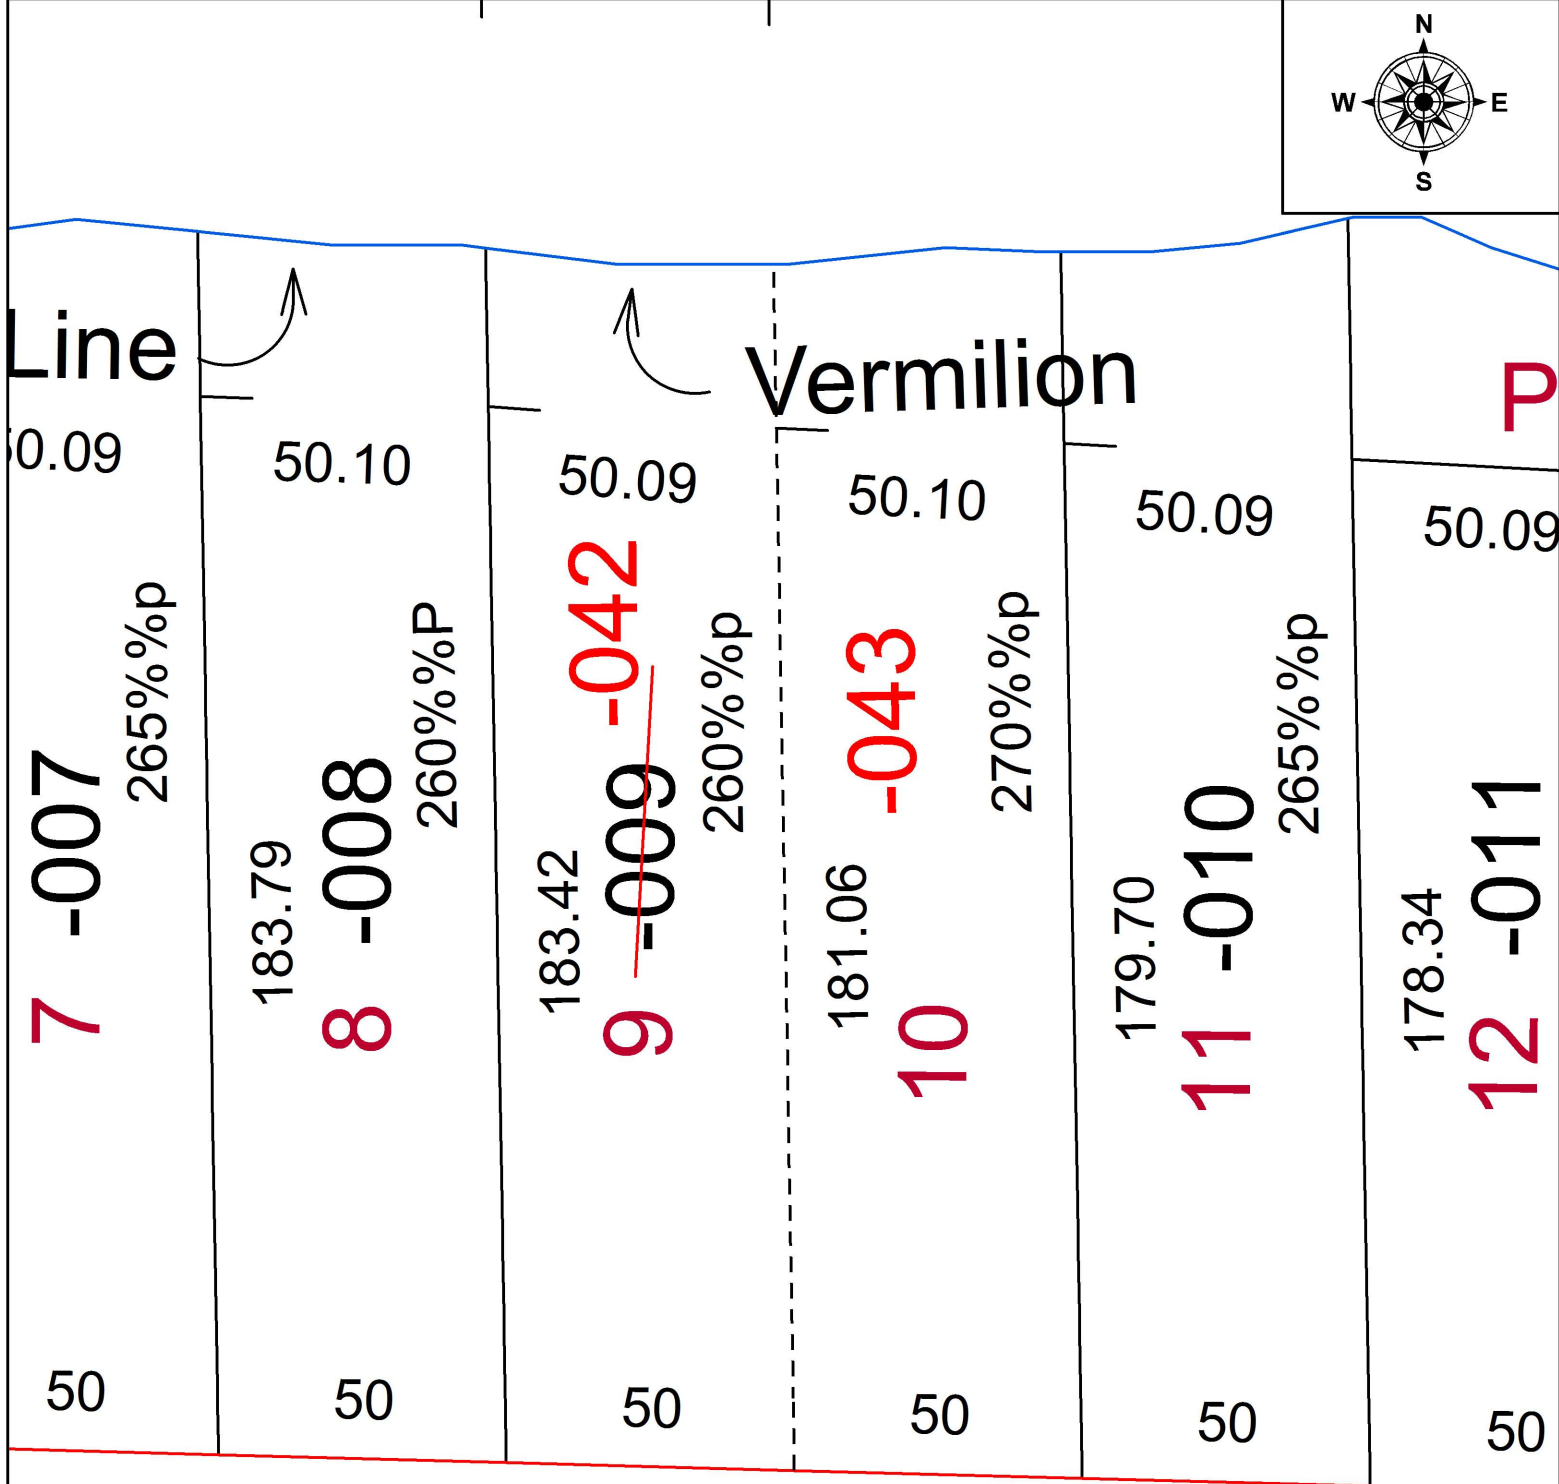

DR. 60 100 60 EDGEWA

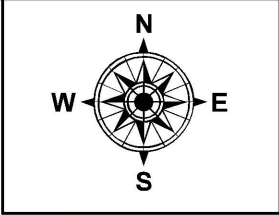

SPLITS/DEEDS PROCESSED
LORAIN COUNTY TAX MAP DEPARTMENT
226 MIDDLE AVE. ELYRIA, OH

SURVEYED BY: PATRICK MCGANNON
CLOSURE: 1: 33,000
MAP PAGE(S): 01-00-001
APPROVED BY: JAH DATE: 5/9/2016
SCALE: 1 in = 33 ft PRIOR INSTRUMENT: PLAT VOL 10 PG 13