

PARENT PARCEL: 19-02-001-000-005




CHILD PARCEL: 19-02-001-000-011, -012

STARTING POINT: CENTERLINE OF JONES RD & O.L. 1

16-03517

TRACT 3

TRACT 2

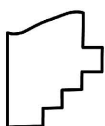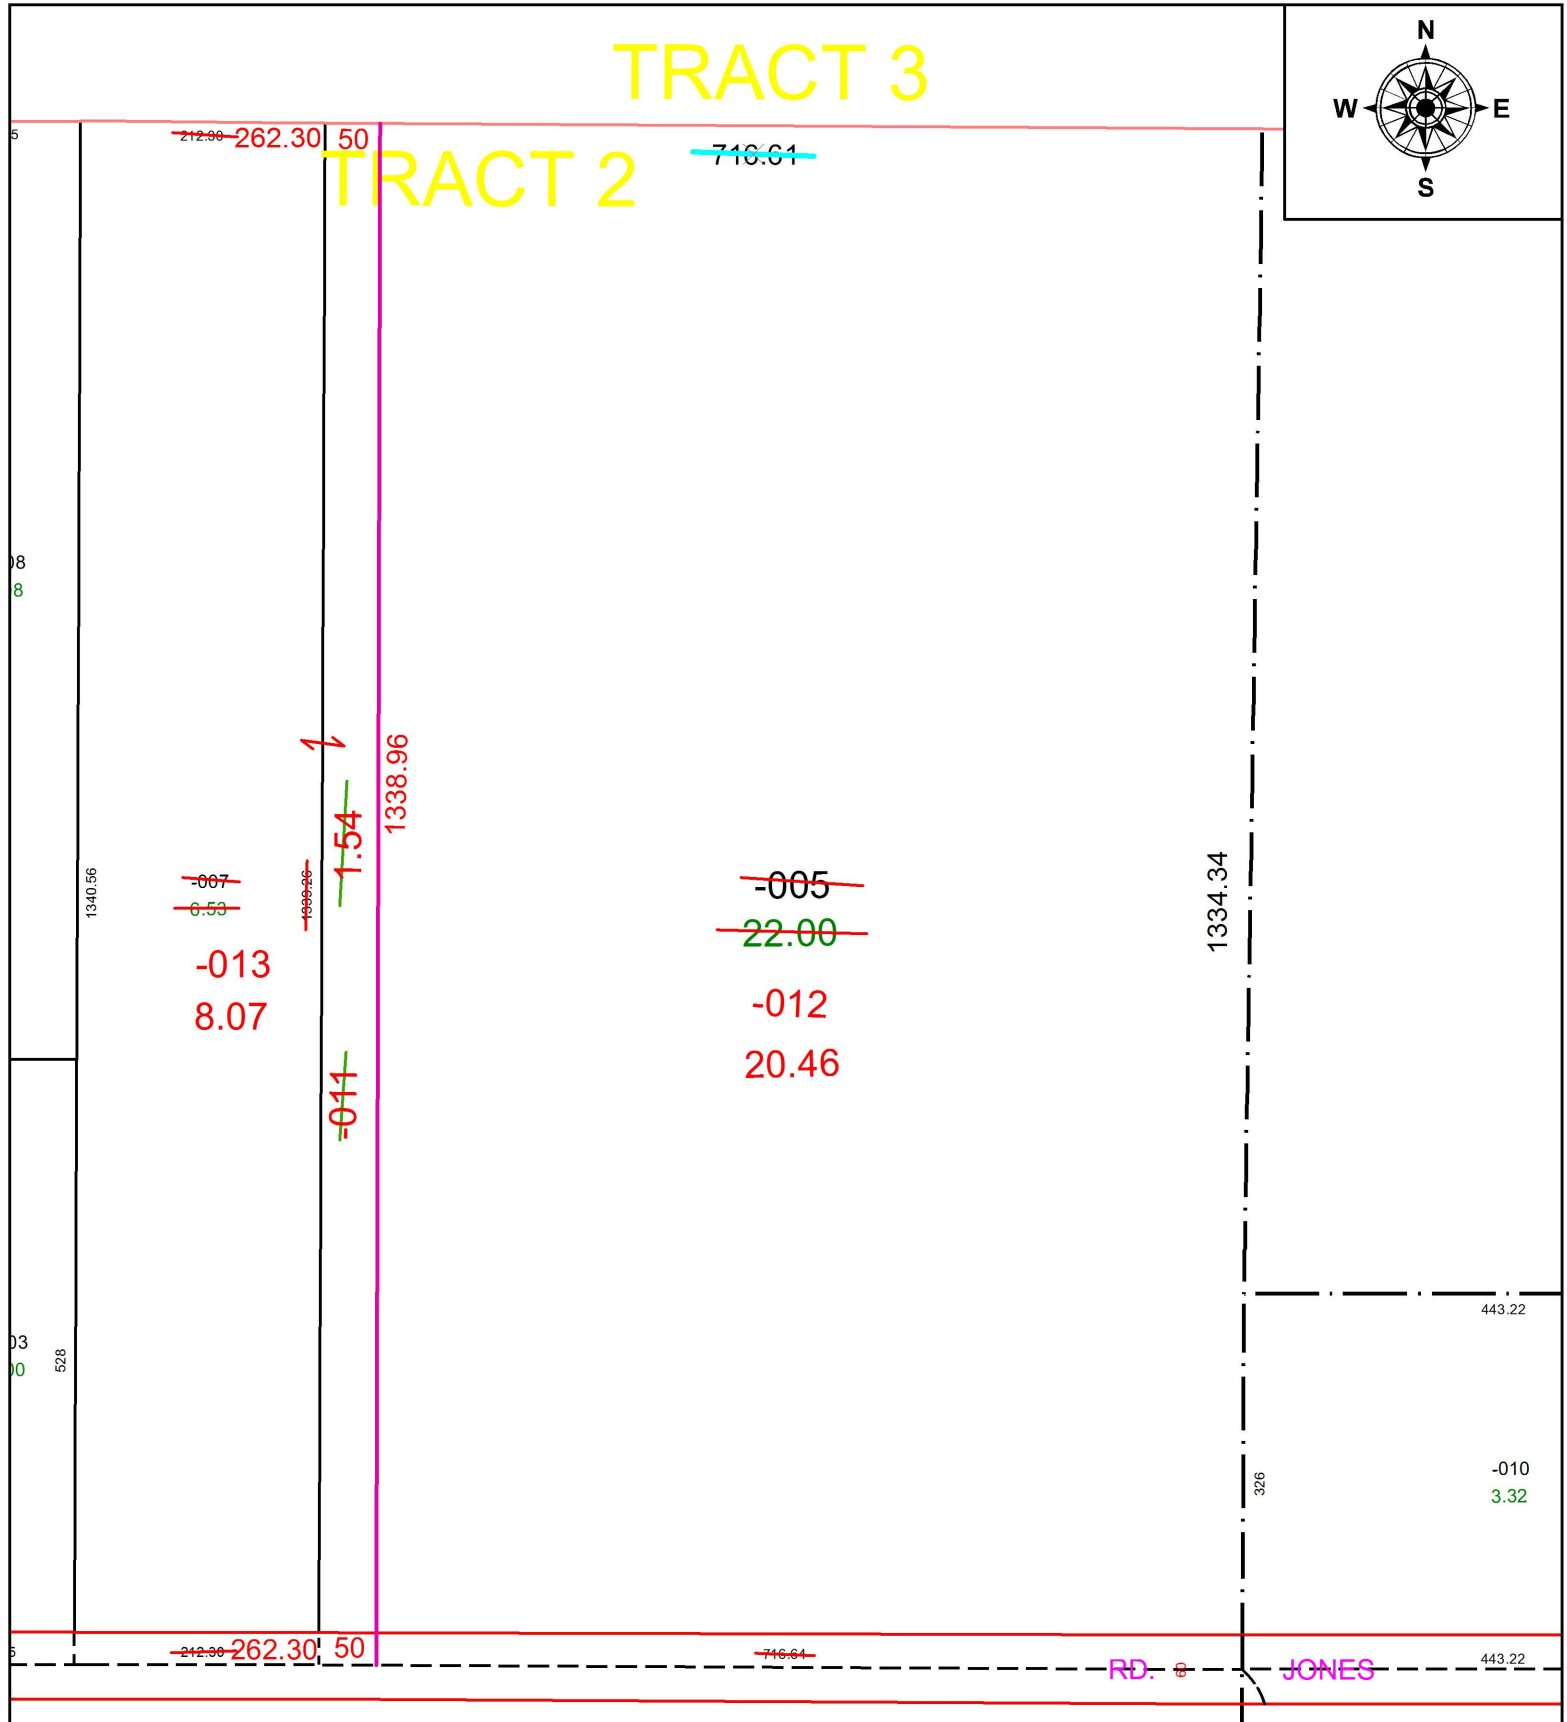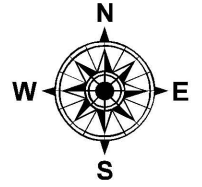

SPLITS/DEEDS PROCESSED
 LORAIN COUNTY TAX MAP DEPARTMENT
 226 MIDDLE AVE. ELYRIA, OH

SURVEYED BY: THOMAS SIMON
 CLOSURE: 1:483206
 MAP PAGE(S): 19-F
 APPROVED BY: JAH DATE: 5/9/2016
 SCALE: 1 in = 167 ft PRIOR INSTRUMENT: 19980549686