


PARENT PARCEL: 06-24-025-105-025

CHILD PARCEL: 06-24-025-105-027, -028

STARTING POINT: NORTHWESTERLY CORNER OF BANNON ALLOT. NO 1

16-03520

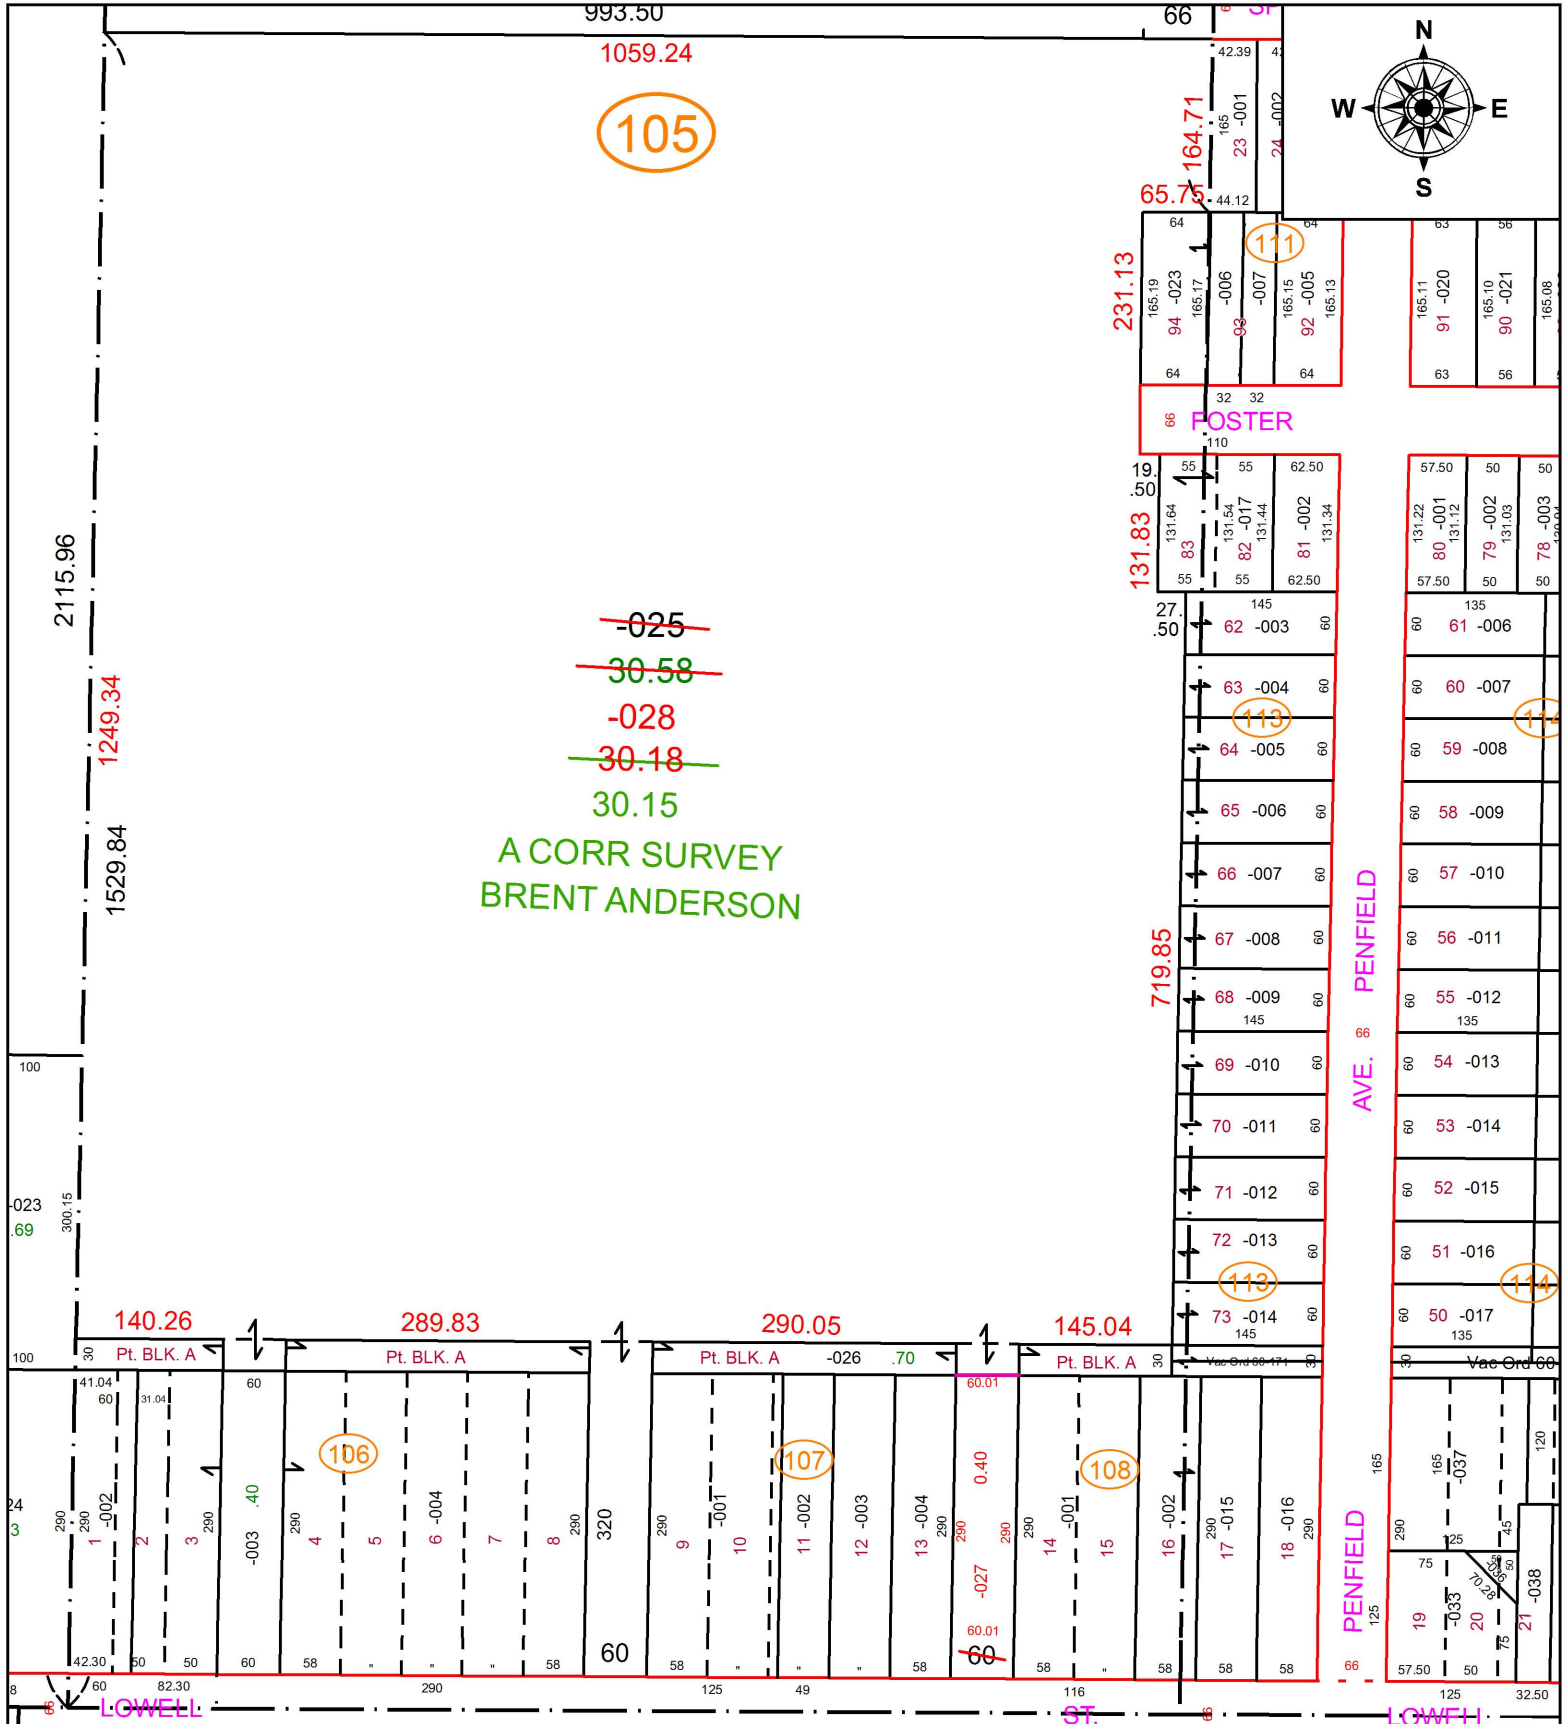

SPLITS/DEEDS PROCESSED
 LORAIN COUNTY TAX MAP DEPARTMENT
 226 MIDDLE AVE. ELYRIA, OH

SURVEYED BY: BRENT ANDERSON

CLOSURE: 1:-2147483648

MAP PAGE(S): 6-25

APPROVED BY: JAH DATE: 05/18/2016

SCALE: 1 in = 183 ft PRIOR INSTRUMENT: DV 519/224