

PARENT PARCEL: 15-00-091-000-014


CHILD PARCEL: XX-XX-XXX-XXX-XXX

STARTING POINT: NORTHEAST CORNER OF LAND CONVEYED TO DARRYL & PATRICIA ARCHER

16-03522-A



9

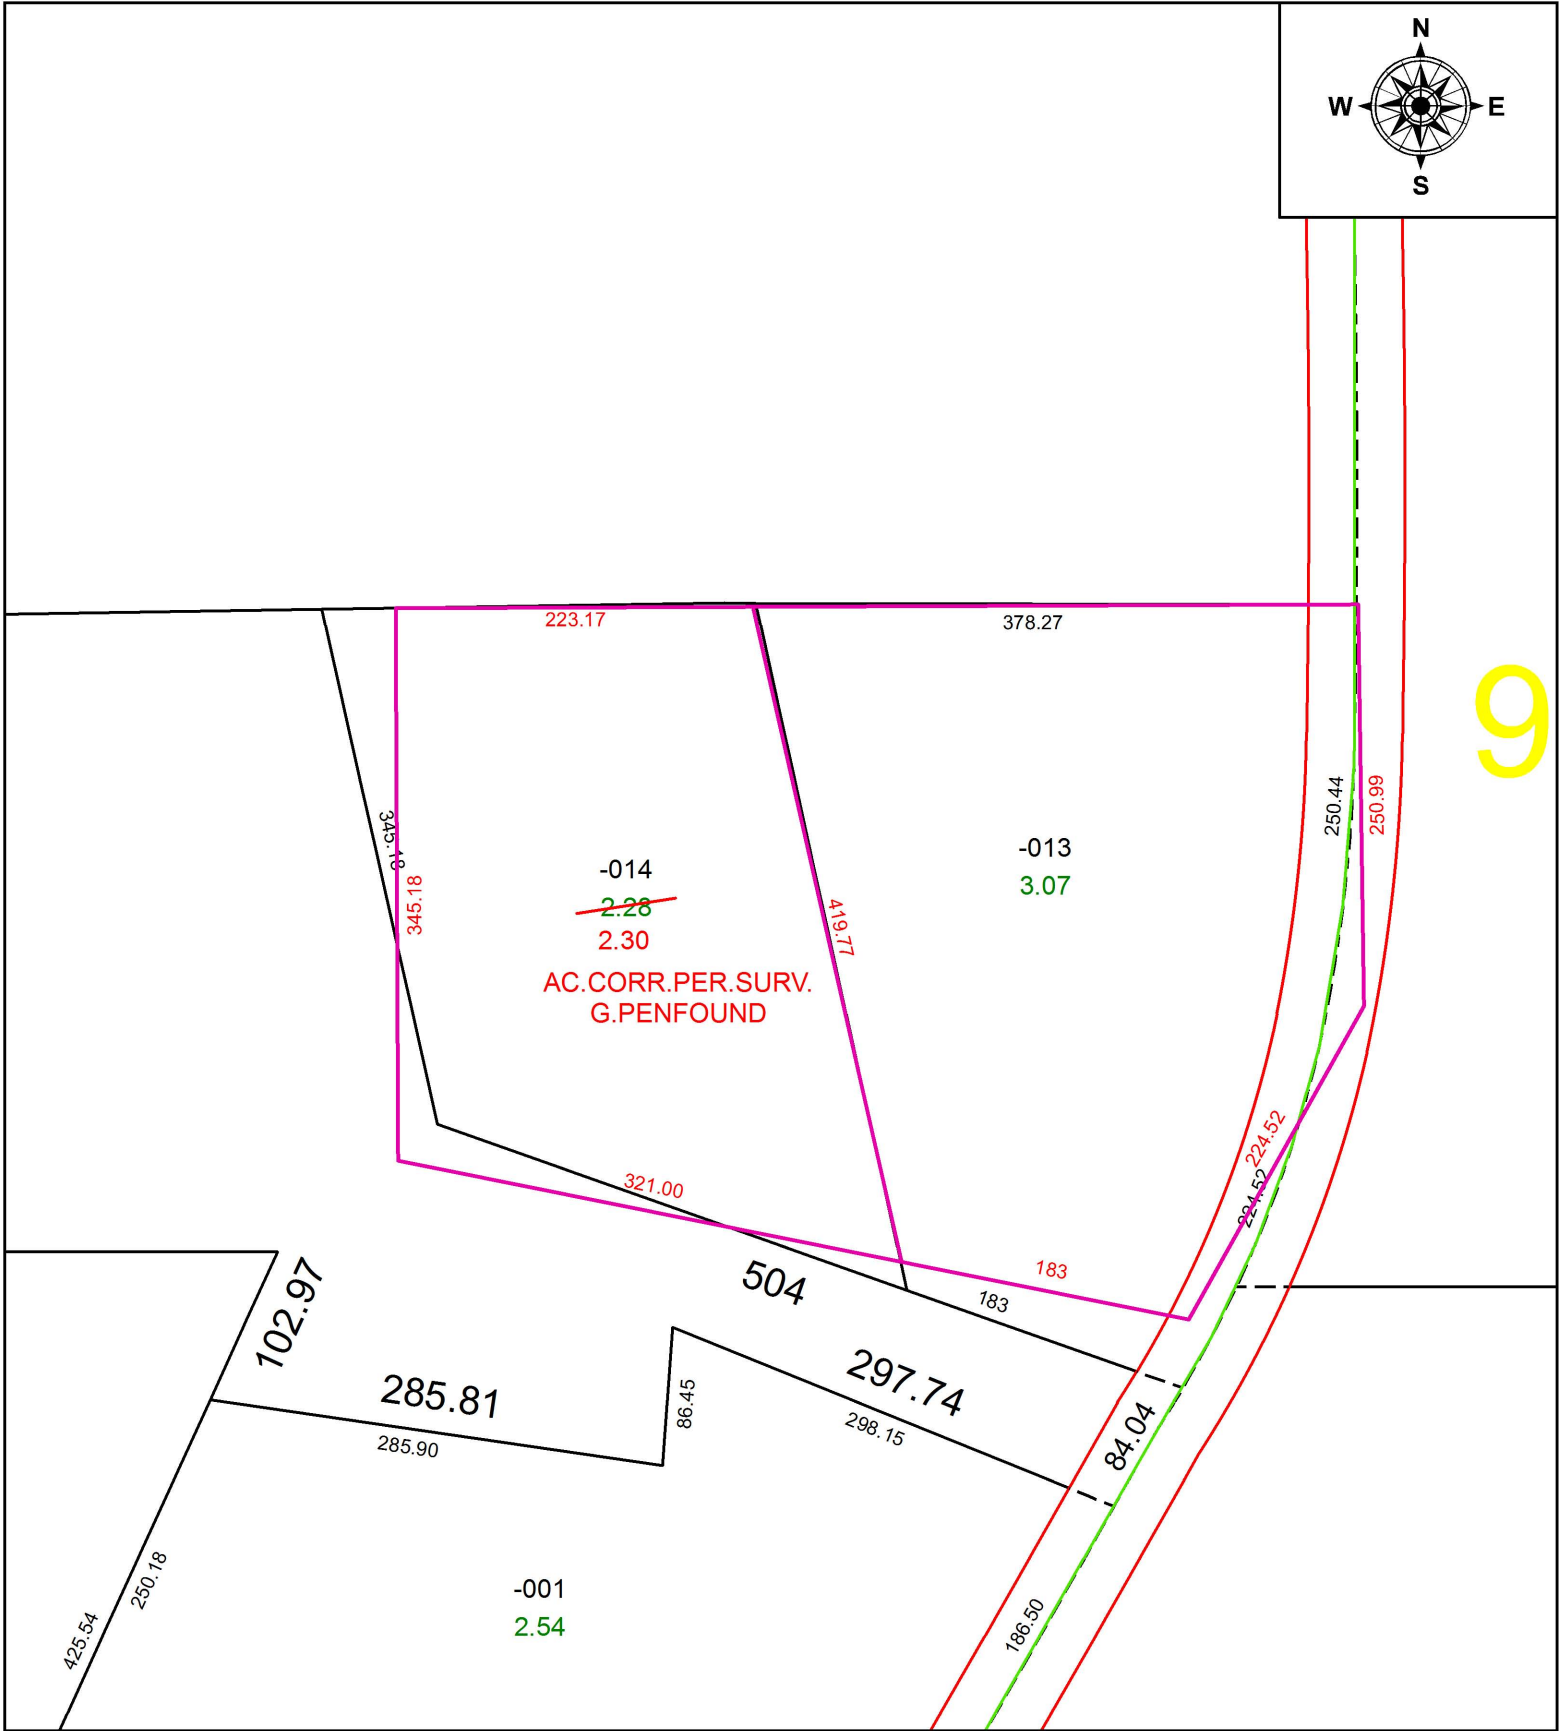

SPLITS/DEEDS PROCESSED
LORAIN COUNTY TAX MAP DEPARTMENT
226 MIDDLE AVE. ELYRIA, OH

SURVEYED BY: GARY E. PENFOUND

CLOSURE: 1: 682,782

MAP PAGE(S): 15-00-091

APPROVED BY: RRM DATE: 9-19-16

SCALE: 1" = 120 PRIOR INSTRUMENT: OR 1199/915