
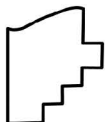
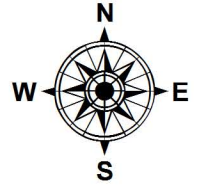


PARENT PARCEL: 04-00-022-102-051, -050, -032

CHILD PARCEL: 04-00-022-102-083 THRU -086

STARTING POINT: CENTERLINE OF DETROIT RD & JAYCOX RD

16-03522

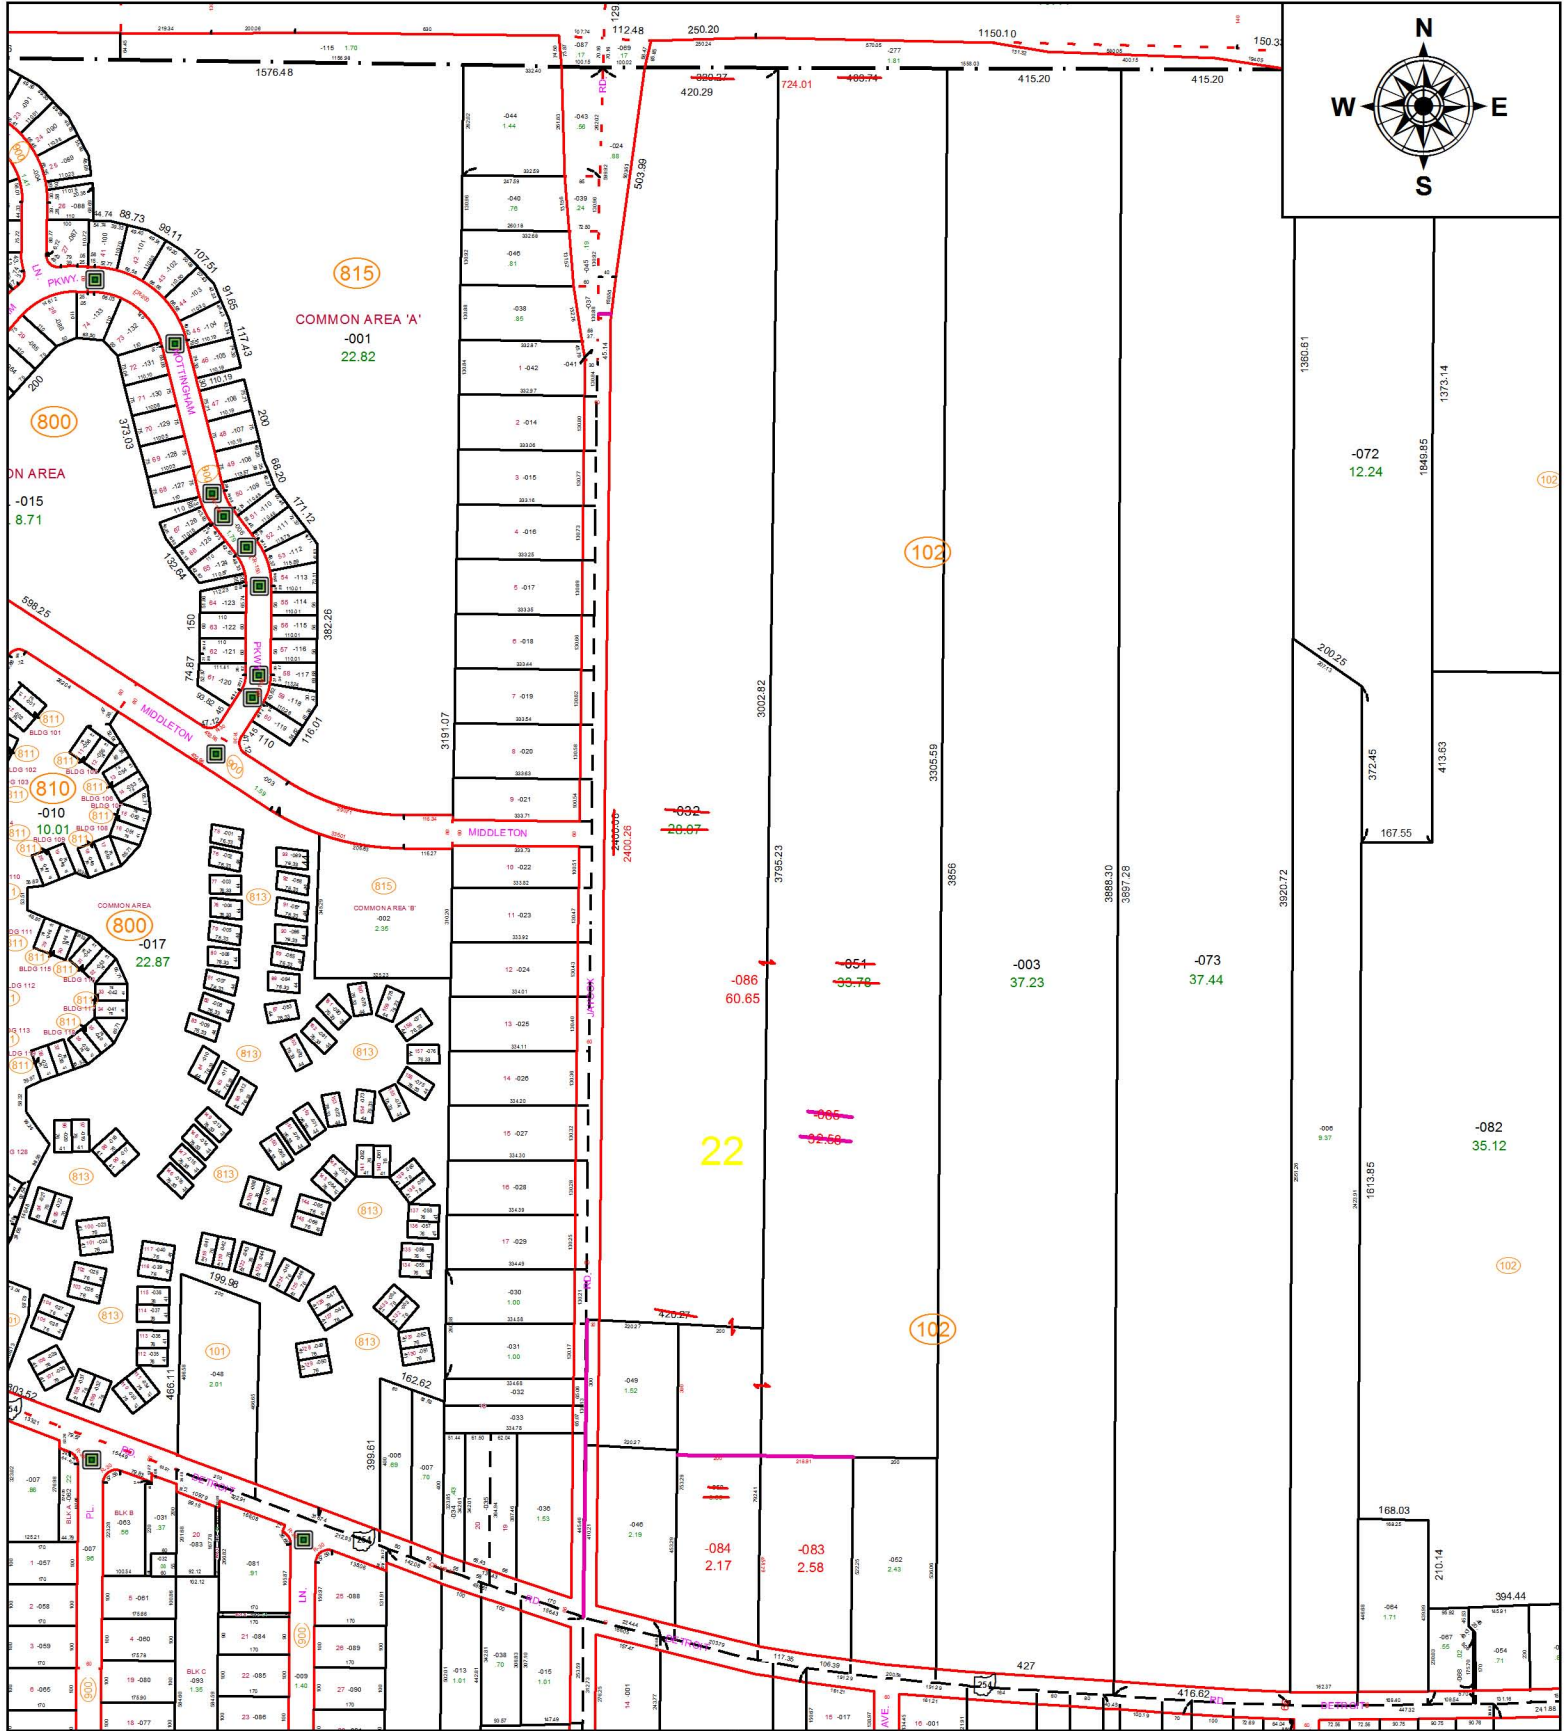

SPLITS/DEEDS PROCESSED
 LORAIN COUNTY TAX MAP DEPARTMENT
 226 MIDDLE AVE. ELYRIA, OH

SURVEYED BY: ALEX EVAN MARKS
CLOSURE: 1:218690
MAP PAGE(S): 04-00-022
APPROVED BY: JAH **DATE:** 6-1-2016
SCALE: 1 in = 458 ft **PRIOR INSTRUMENT:** 20120436197