


PARENT PARCEL: 15-00-099-102-086

CHILD PARCEL: 15-00-099-102-113, -114

STARTING POINT: NORTHEAST CORNER OF S/L 99 OF PHEASANT RUN SUBD PH 1

16-03523

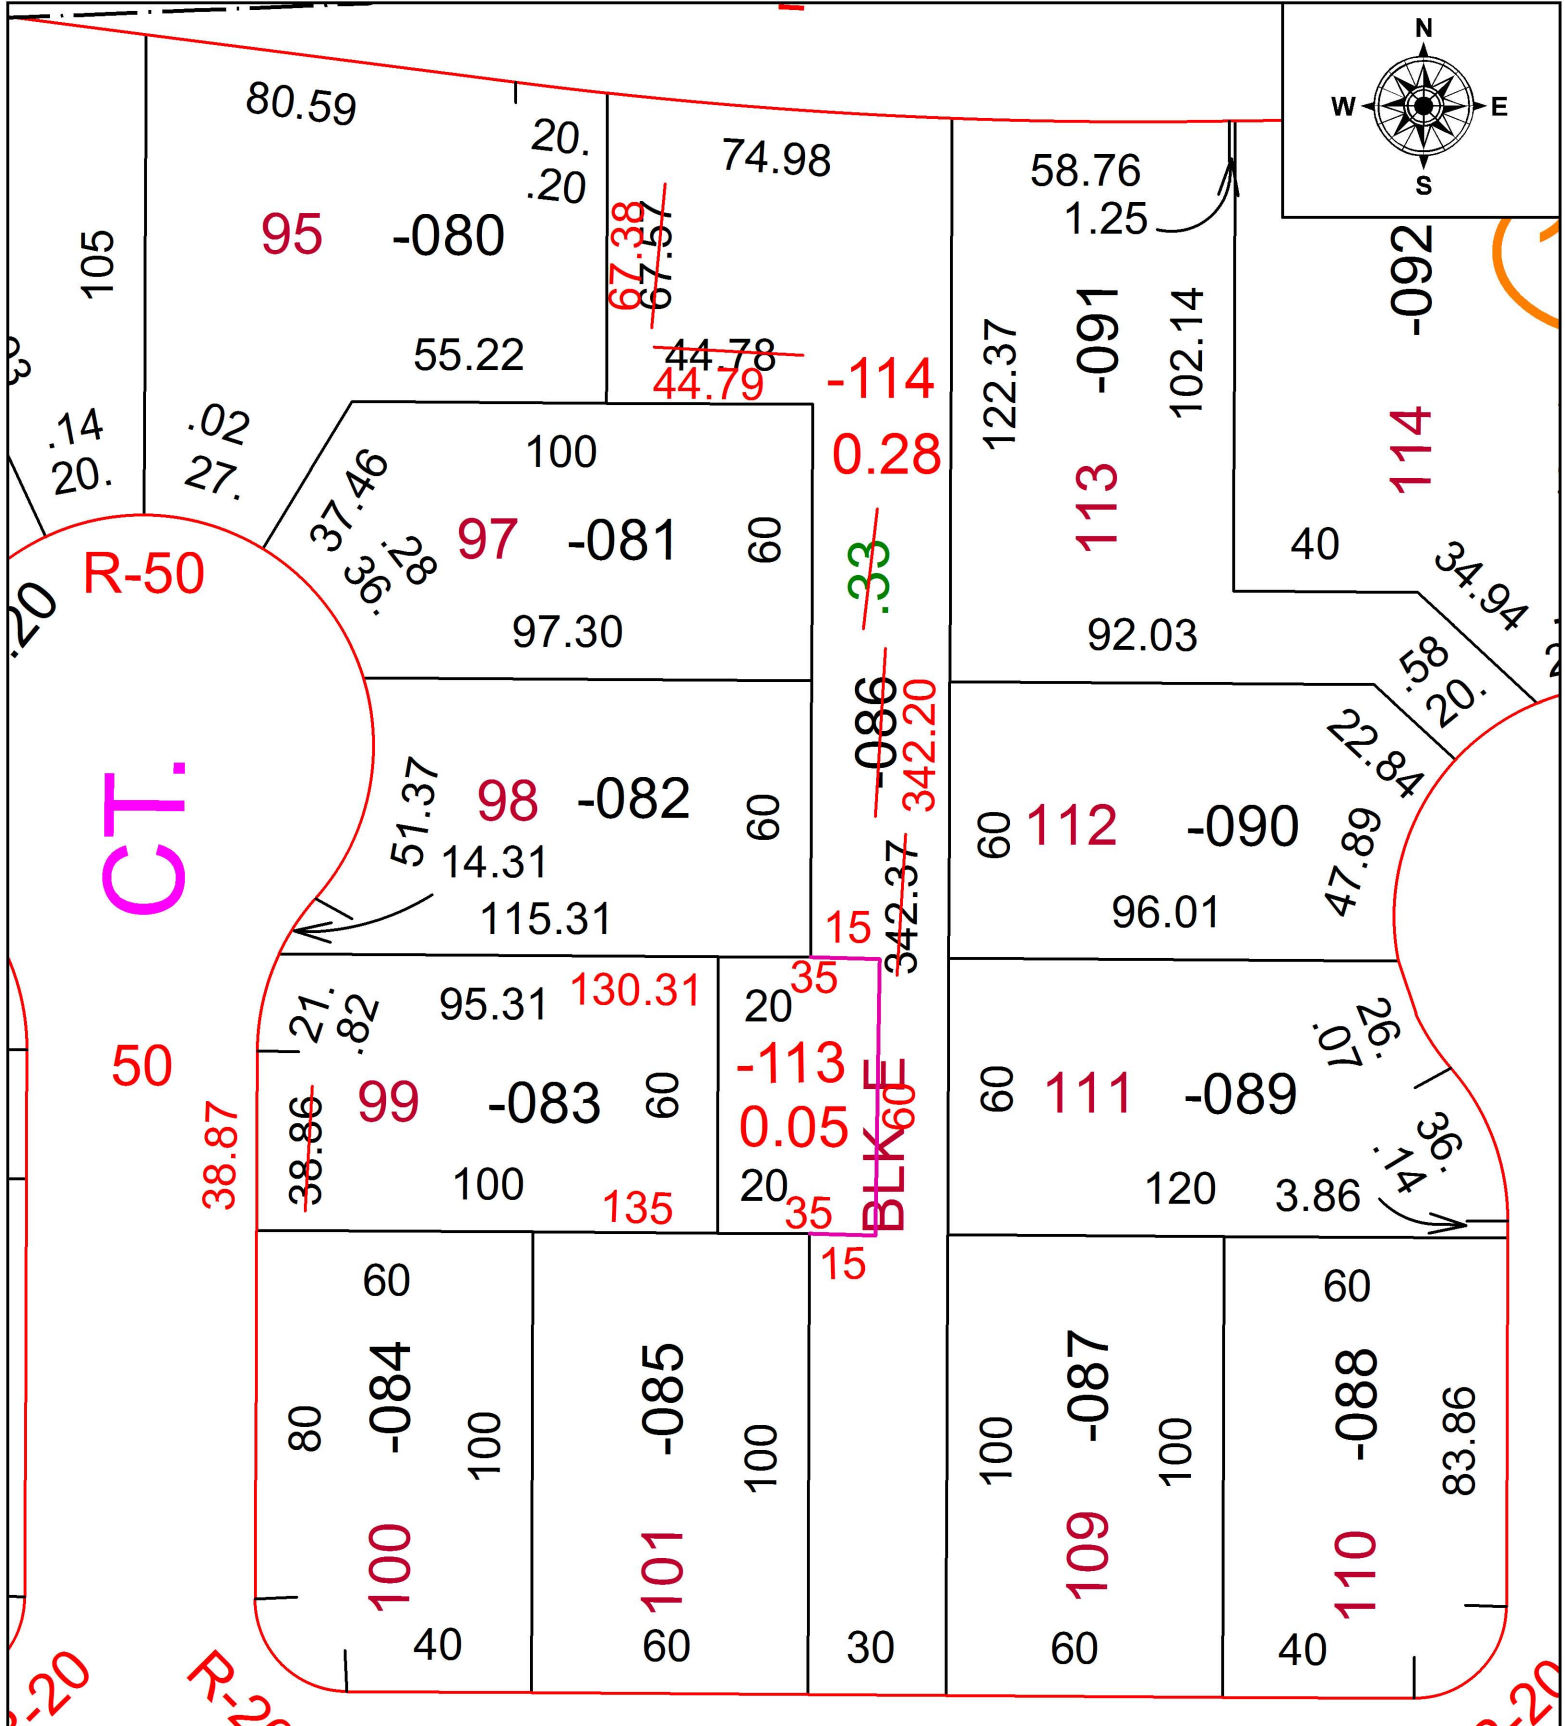

**SPLITS/DEEDS PROCESSED**  
 LORAIN COUNTY TAX MAP DEPARTMENT  
 226 MIDDLE AVE. ELYRIA, OH

SURVEYED BY: THOMAS SIMON

CLOSURE: 1:-2147483648

MAP PAGE(S): 15-00-099

APPROVED BY: JAH DATE: 6/6/2016

SCALE: 1 in = 42 ft PRIOR INSTRUMENT: 20150554268