


PARENT PARCEL: 15-00-098-108-258

CHILD PARCEL: 15-00-098-108-289, -290

16-03524

STARTING POINT: SOUTHWESTERLY CORNER OF S/L 515 IN PHEASANT RUN VILL. SUBD NO 1

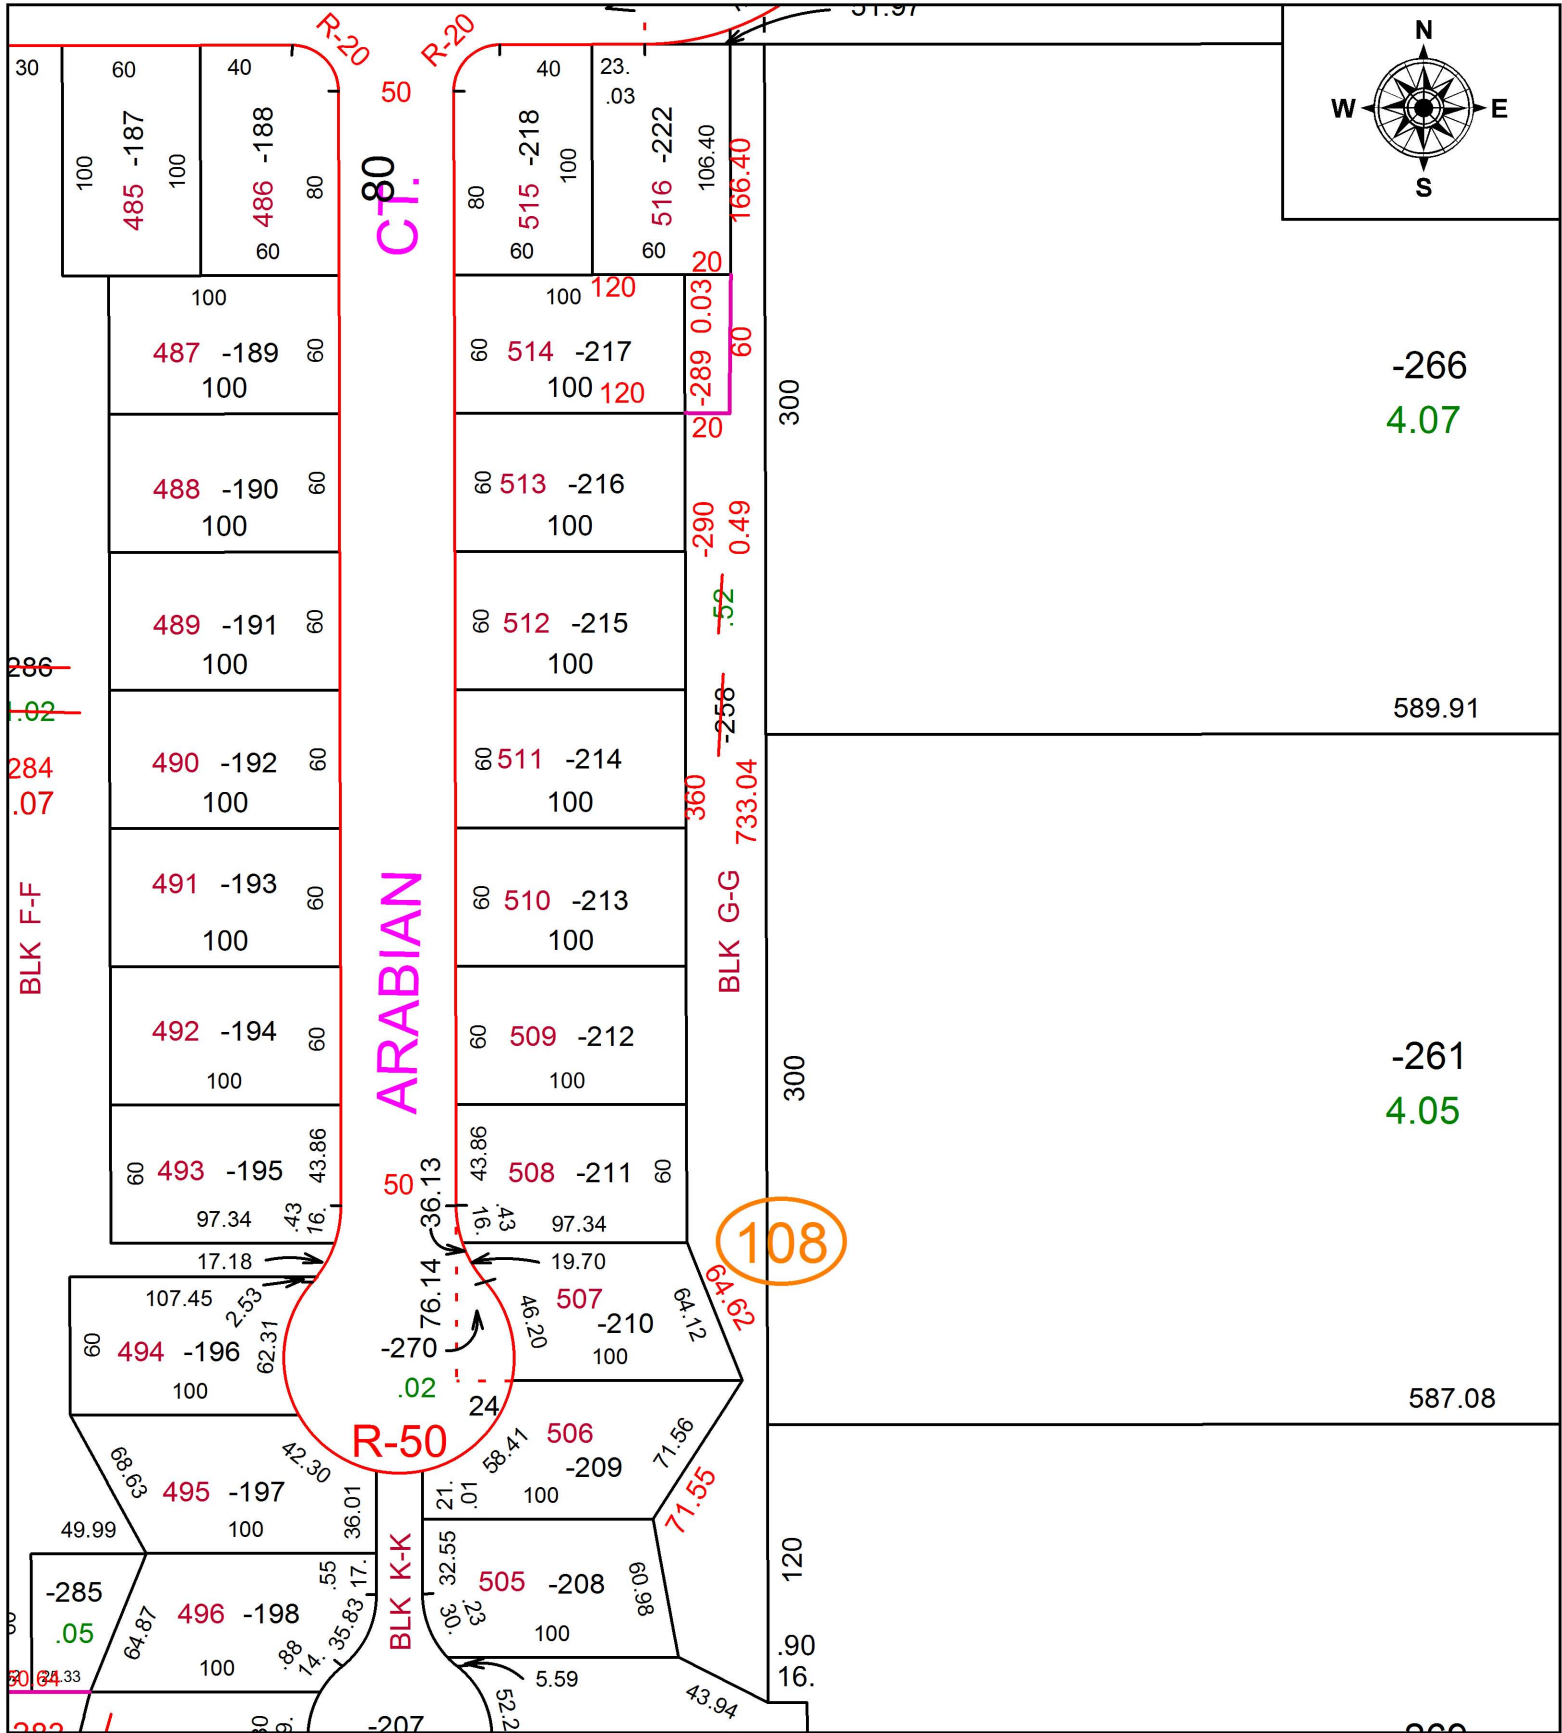

-266

4.07


589.91

-261

4.05

587.08

108

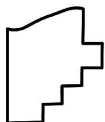

**SPLITS/DEEDS PROCESSED**

LORAIN COUNTY TAX MAP DEPARTMENT  
226 MIDDLE AVE. ELYRIA, OH

SURVEYED BY: THOMAS SIMON

CLOSURE: 1:-2147483648

MAP PAGE(S): 15-00-098

APPROVED BY: JAH DATE: 6/6/2016

SCALE: 1 in = 83 ft PRIOR INSTRUMENT: 20150554268