
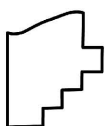


PARENT PARCEL: 15-00-030-000-014, -016 15-00-029-000-017

CHILD PARCEL: 15-00-030-000-040, 15-00-029-000-017

STARTING POINT: CENTERLINE OF INDIAN HOLLOW

16-03525

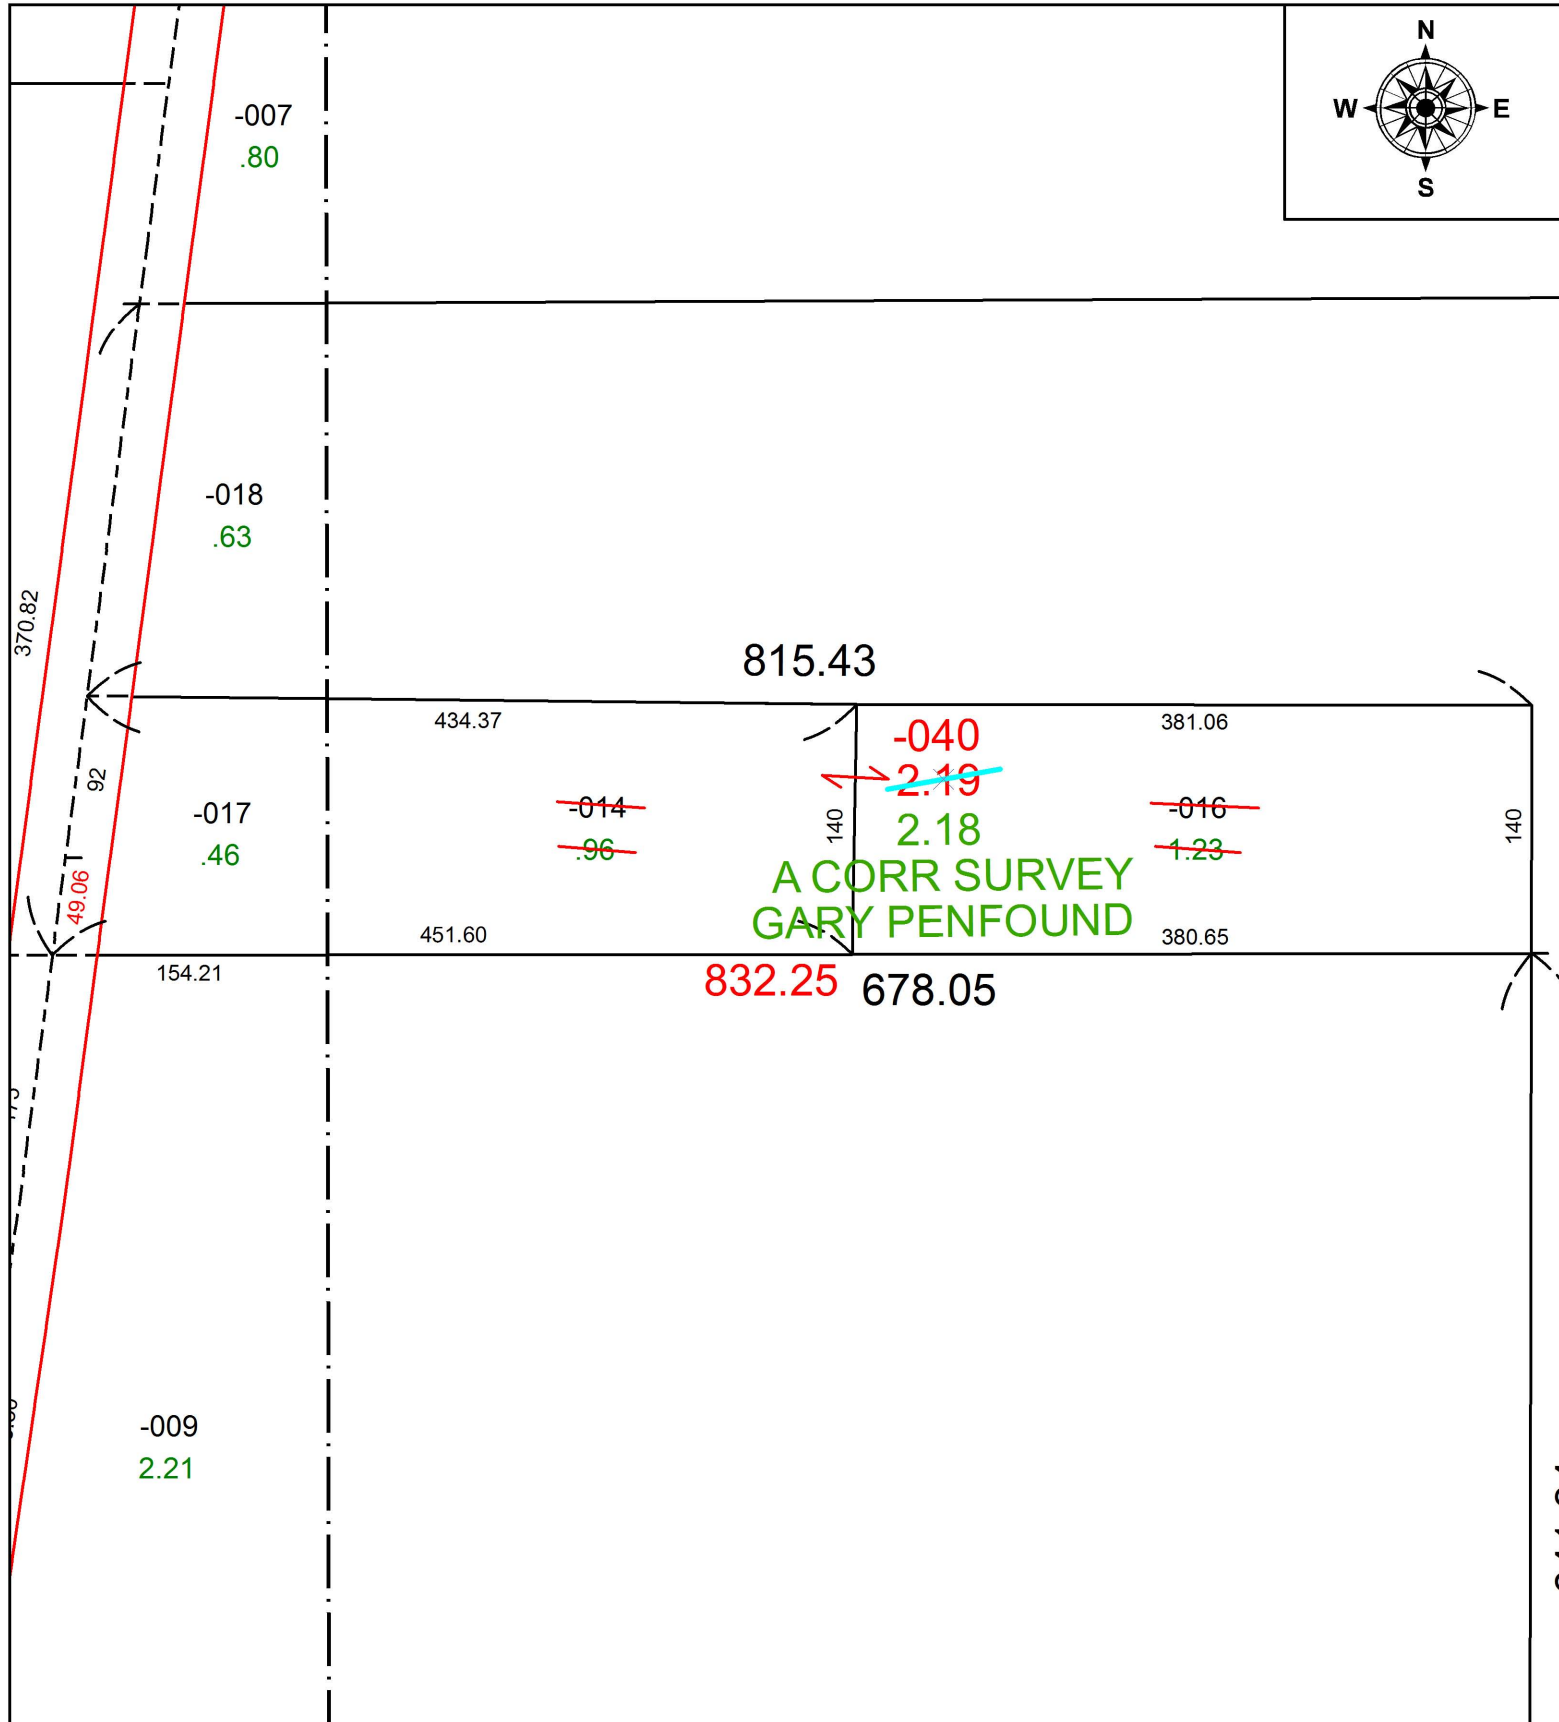

SPLITS/DEEDS PROCESSED
 LORAIN COUNTY TAX MAP DEPARTMENT
 226 MIDDLE AVE. ELYRIA, OH

SURVEYED BY: GARY PENFOUND
 CLOSURE: 1: 33,000
 MAP PAGE(S): 15-00-030
 APPROVED BY: JAH DATE: 6/7/2016
 SCALE: 1 in = 108 ft PRIOR INSTRUMENT: OR 661/338