


PARENT PARCEL: ADD TO DUPLICATE

CHILD PARCEL: 02-01-006-125-016

16-03528-C

STARTING POINT: VACATED 13TH ST. PER ORD. #36-91 RECORDED IN O.R. 411 PG. 256

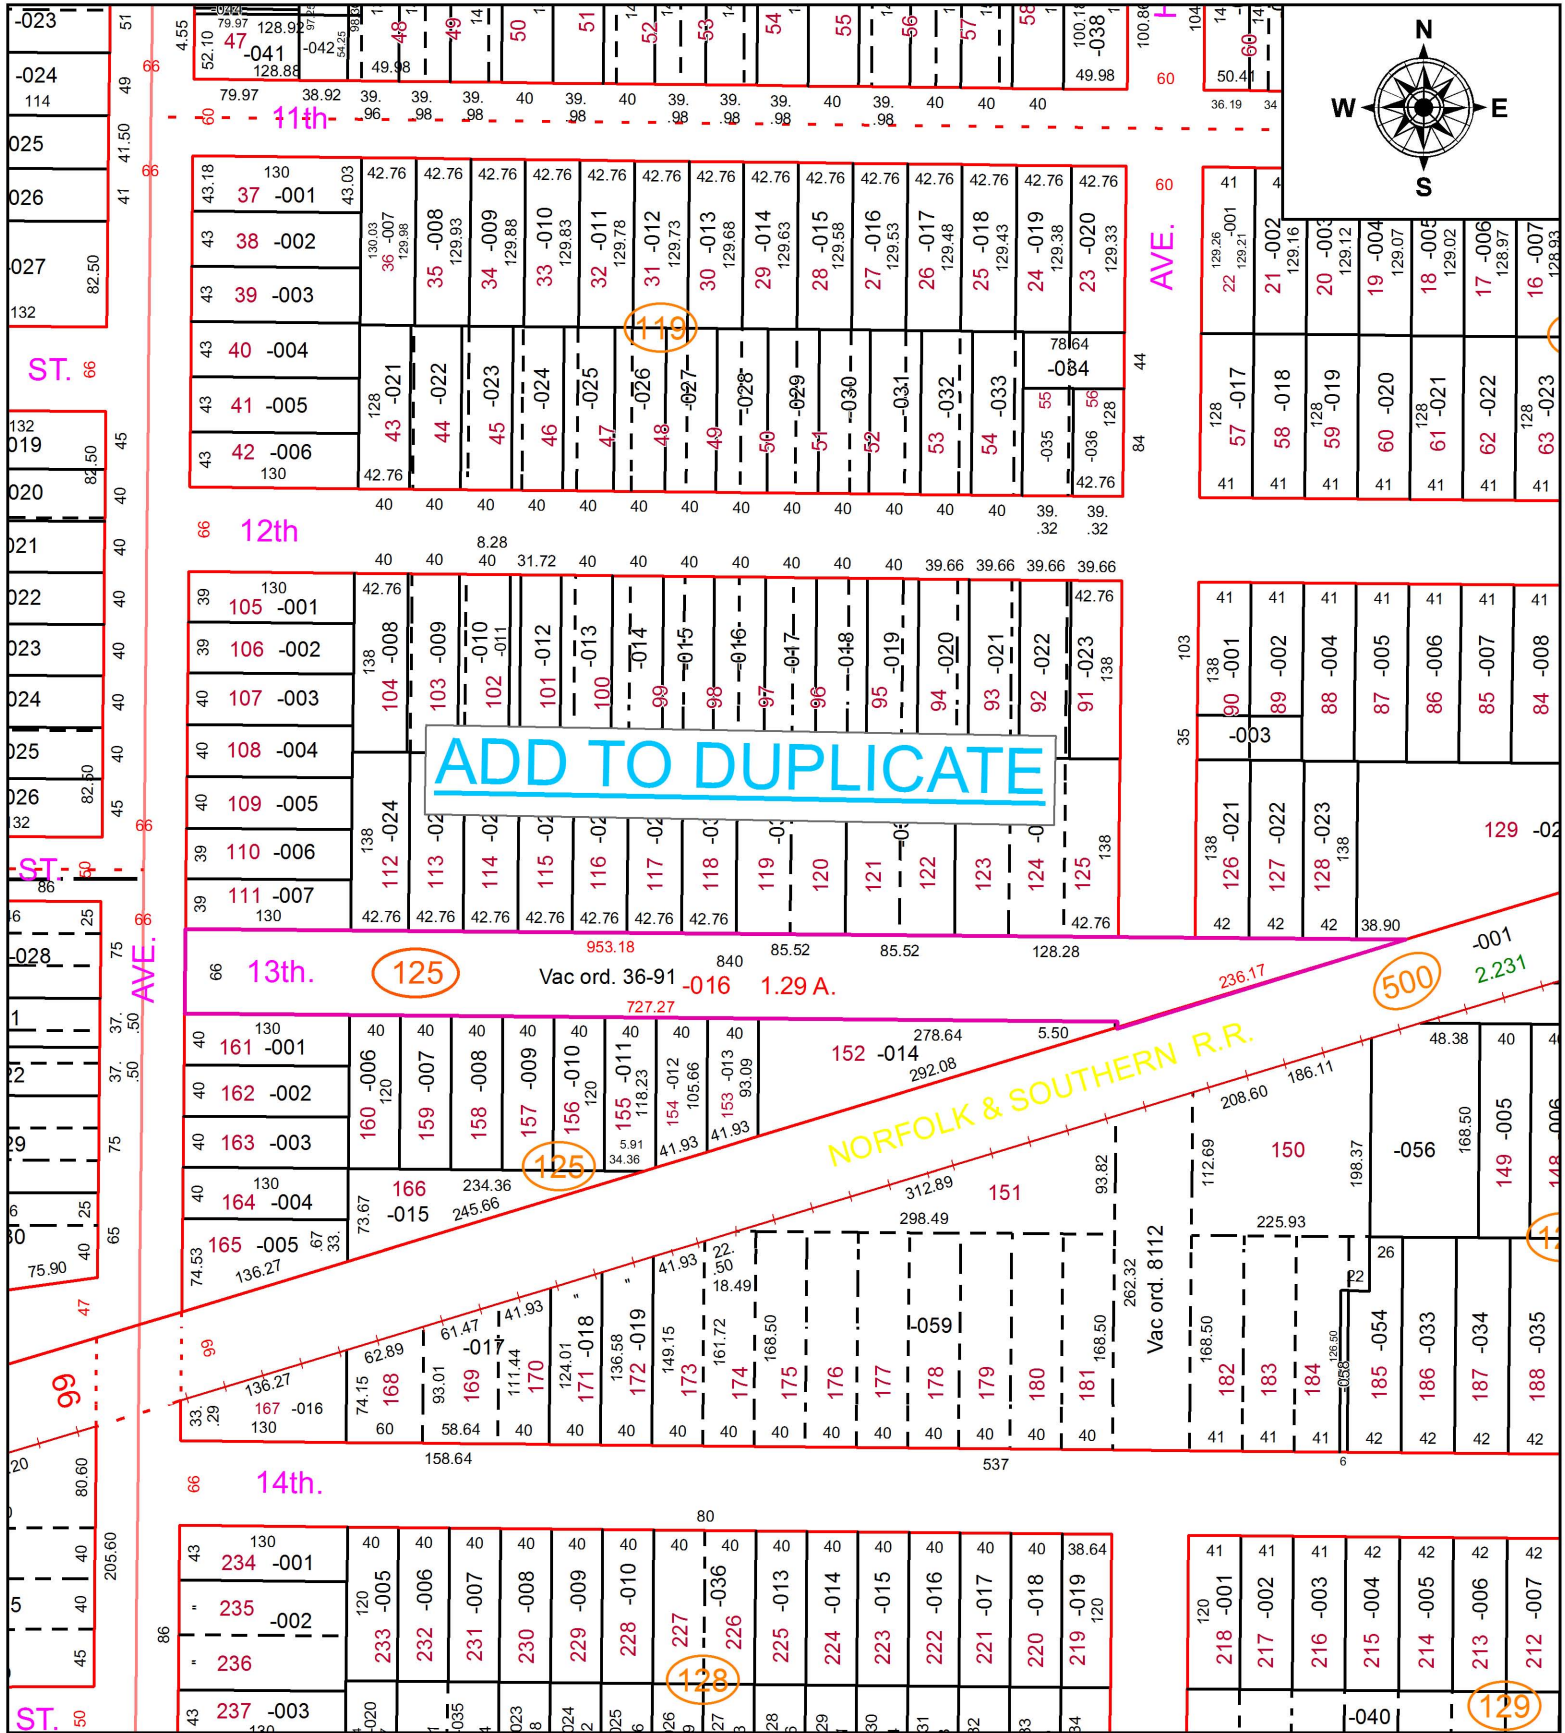

ADD TO DUPLICATE

NORFOLK & SOUTHERN R.R.

**SPLITS/DEEDS PROCESSED**  
 LORAIN COUNTY TAX MAP DEPARTMENT  
 226 MIDDLE AVE. ELYRIA, OH

SURVEYED BY: NA  
 CLOSURE: NA  
 MAP PAGE(S): 02-01-006  
 APPROVED BY: TJS DATE: 9/23/16  
 SCALE: 1" = 150 PRIOR INSTRUMENT: OR. 411/256