
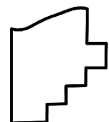
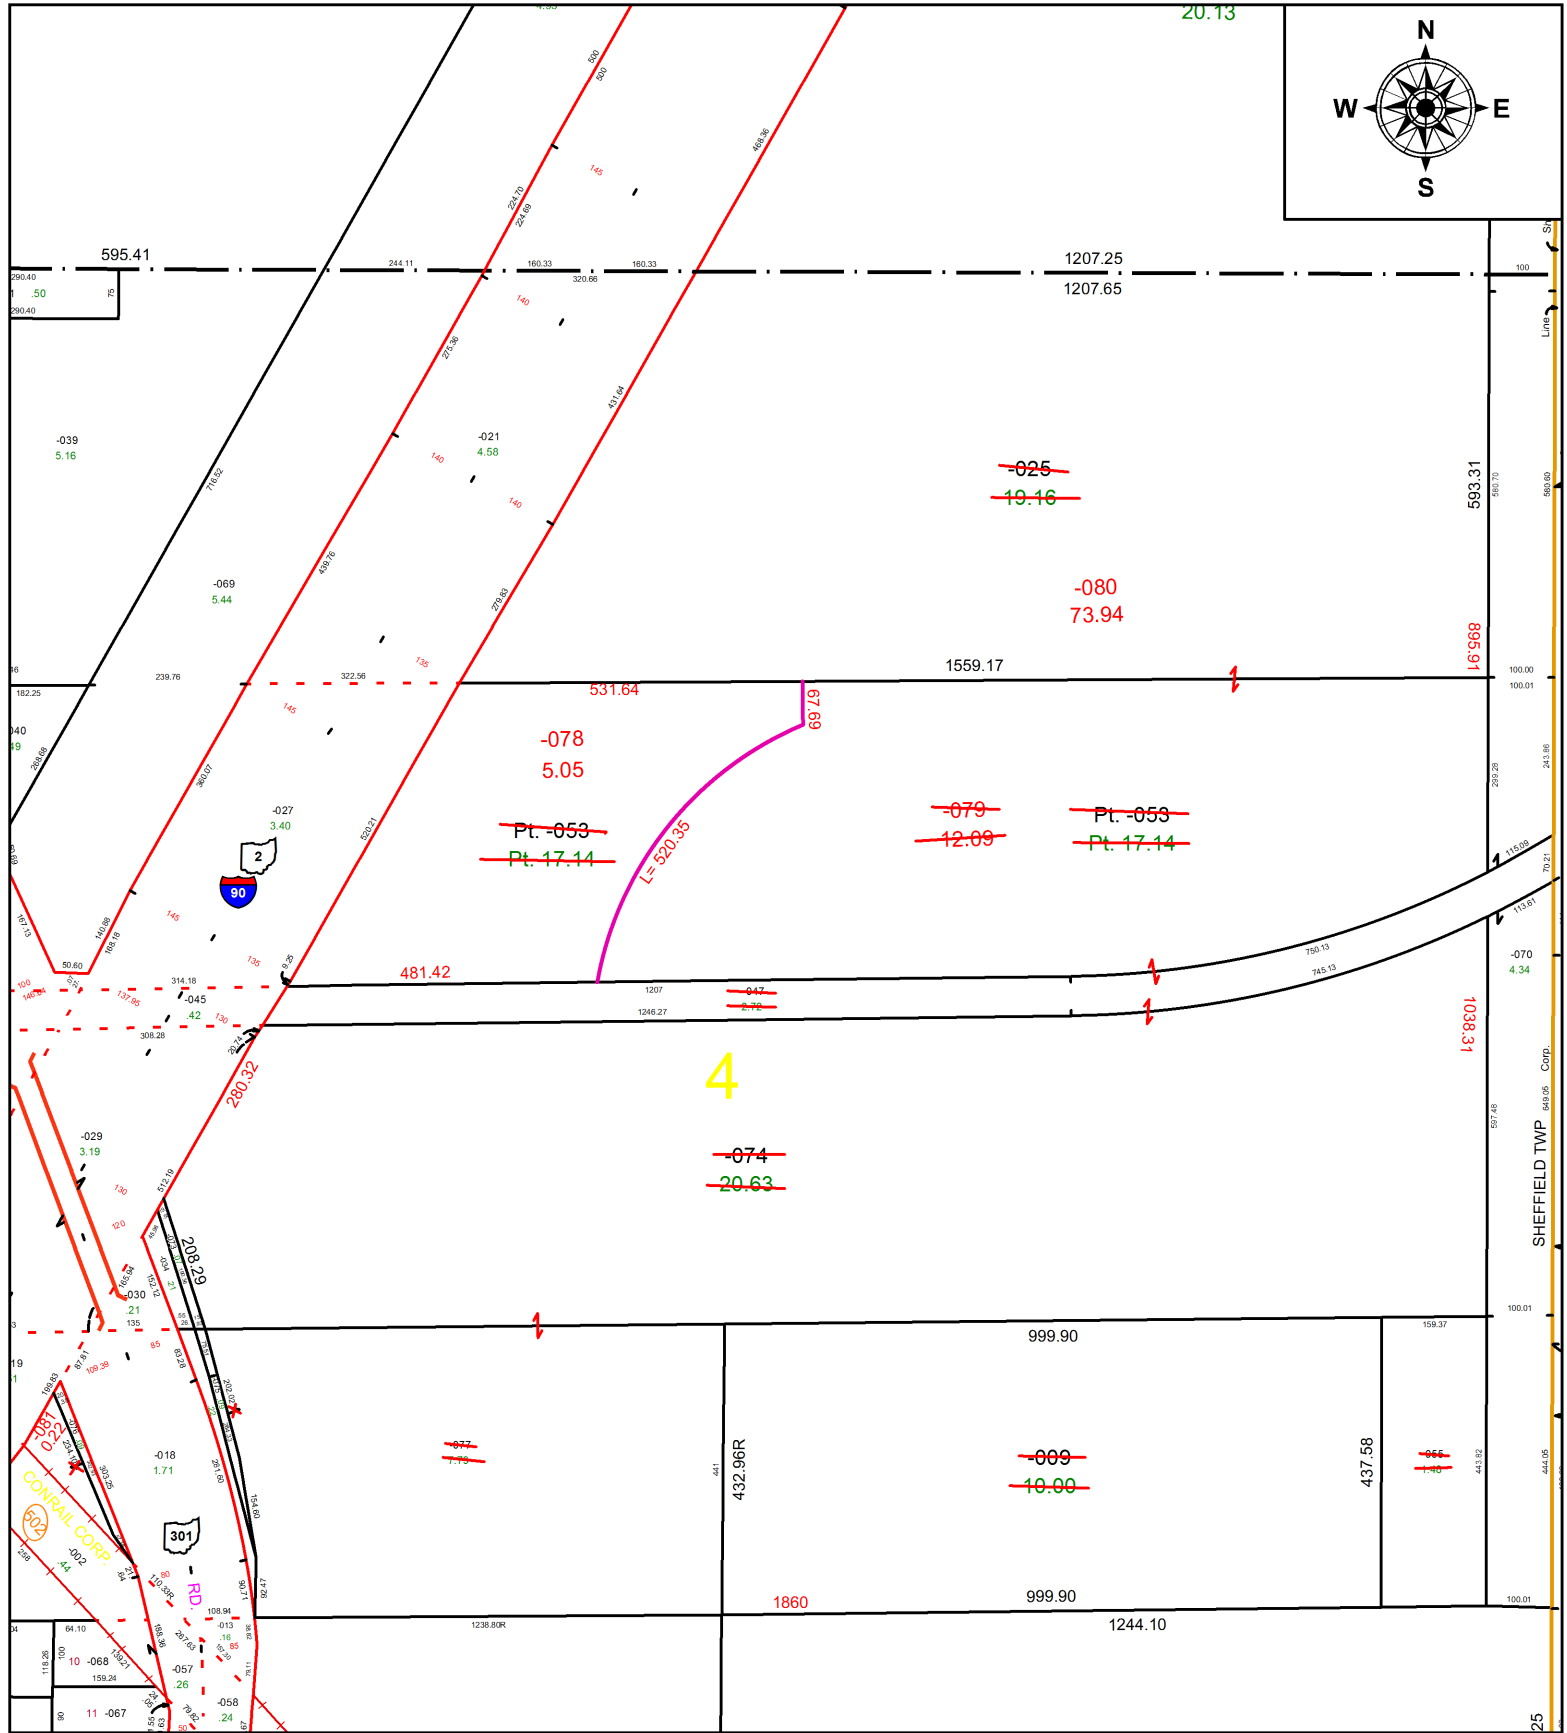


PARENT PARCEL: 03-00-004-000-053 025 047 074 055 009 077 079

CHILD PARCEL: 03-00-004-000-078, -079, 080, 081

STARTING POINT: CENTERLINE OF FRENCH CREEK RD & EAST LINE OF O.L. 5

16-03529

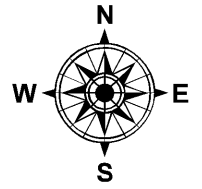

SPLITS/DEEDS PROCESSED
LORAIN COUNTY TAX MAP DEPARTMENT
226 MIDDLE AVE. ELYRIA, OH

SURVEYED BY: AMY KELLY
CLOSURE: 1:466504
MAP PAGE(S): 03-00-004
APPROVED BY: JAH DATE: 06-22-2016
SCALE: 1 in = 292 ft PRIOR INSTRUMENT: 20160574259