
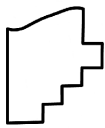


PARENT PARCEL: 0201006112003 004 005 008 009 013 0201005108001 thru 004 & 013

CHILD PARCEL: 02-01-006-112-015 -014 -005 02-01-005-108-017, -001

16-03530

STARTING POINT: CENTERLINE OF WEST 5TH & WASHINGTON AVE

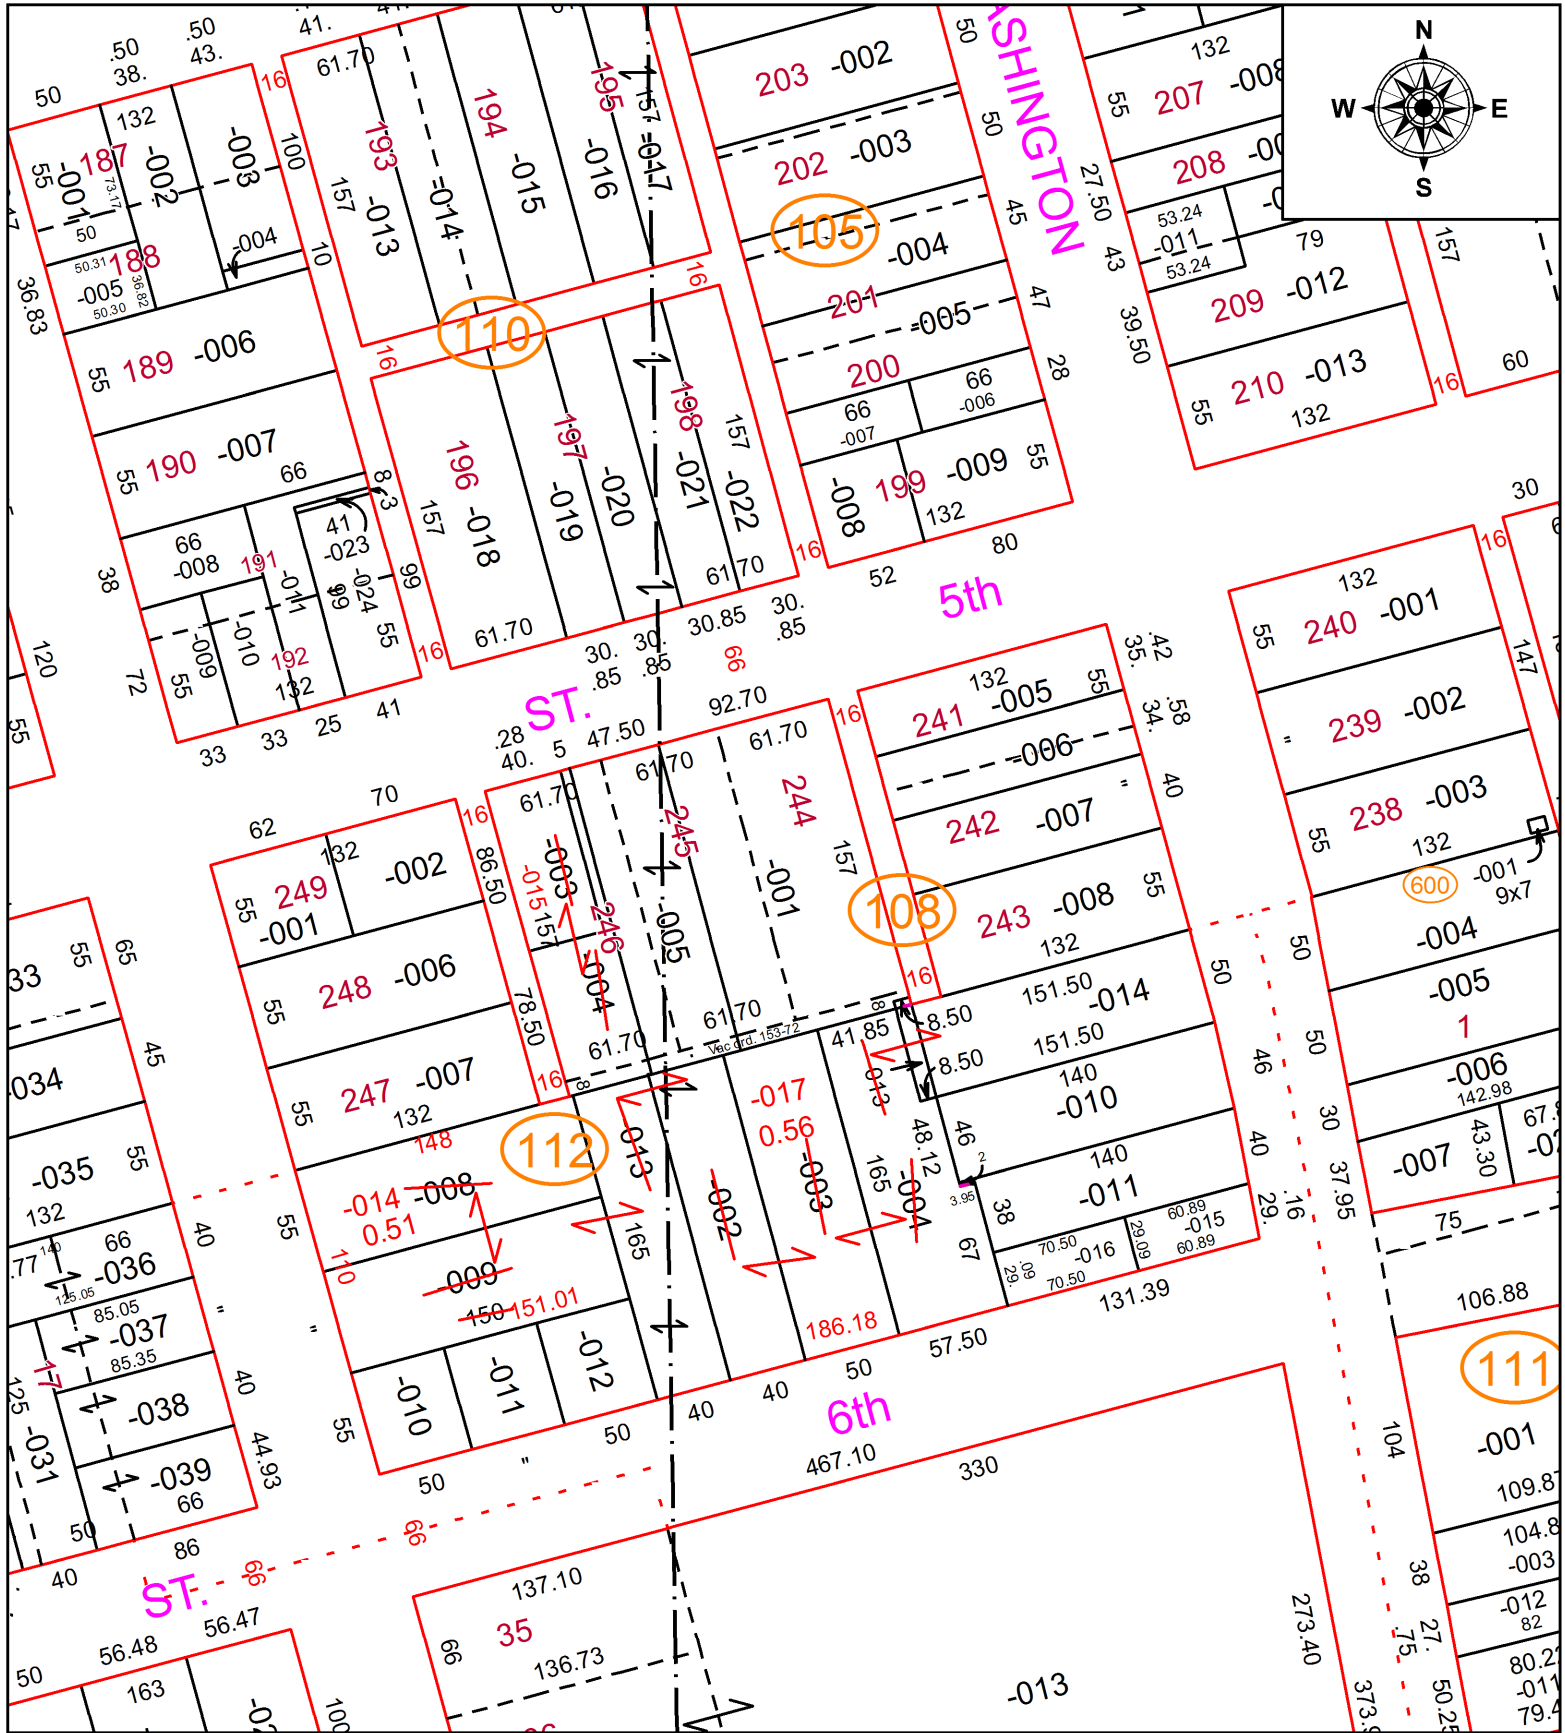

SPLITS/DEEDS PROCESSED

LORAIN COUNTY TAX MAP DEPARTMENT
226 MIDDLE AVE. ELYRIA, OH

SURVEYED BY: AMY KELLY

CLOSURE: 1:441984

MAP PAGE(S): 02-01-006

APPROVED BY: JAH DATE: 06-30-2016

SCALE: 1 in = 100 ft PRIOR INSTRUMENT: DV 1048/481