
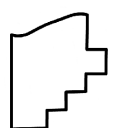


PARENT PARCEL: 06-22-015-501-005 & -007, & 06-22-016-501-001 & -002

CHILD PARCEL: 06-22-015-101-010 & -011, 06-22-016-000-015, & 06-22-020-107-017

STARTING POINT: 1/2" I.P. FOUND, N.E. CORNER OF O.L. 16 IN BURRELL & DAY TRACT

16-03531

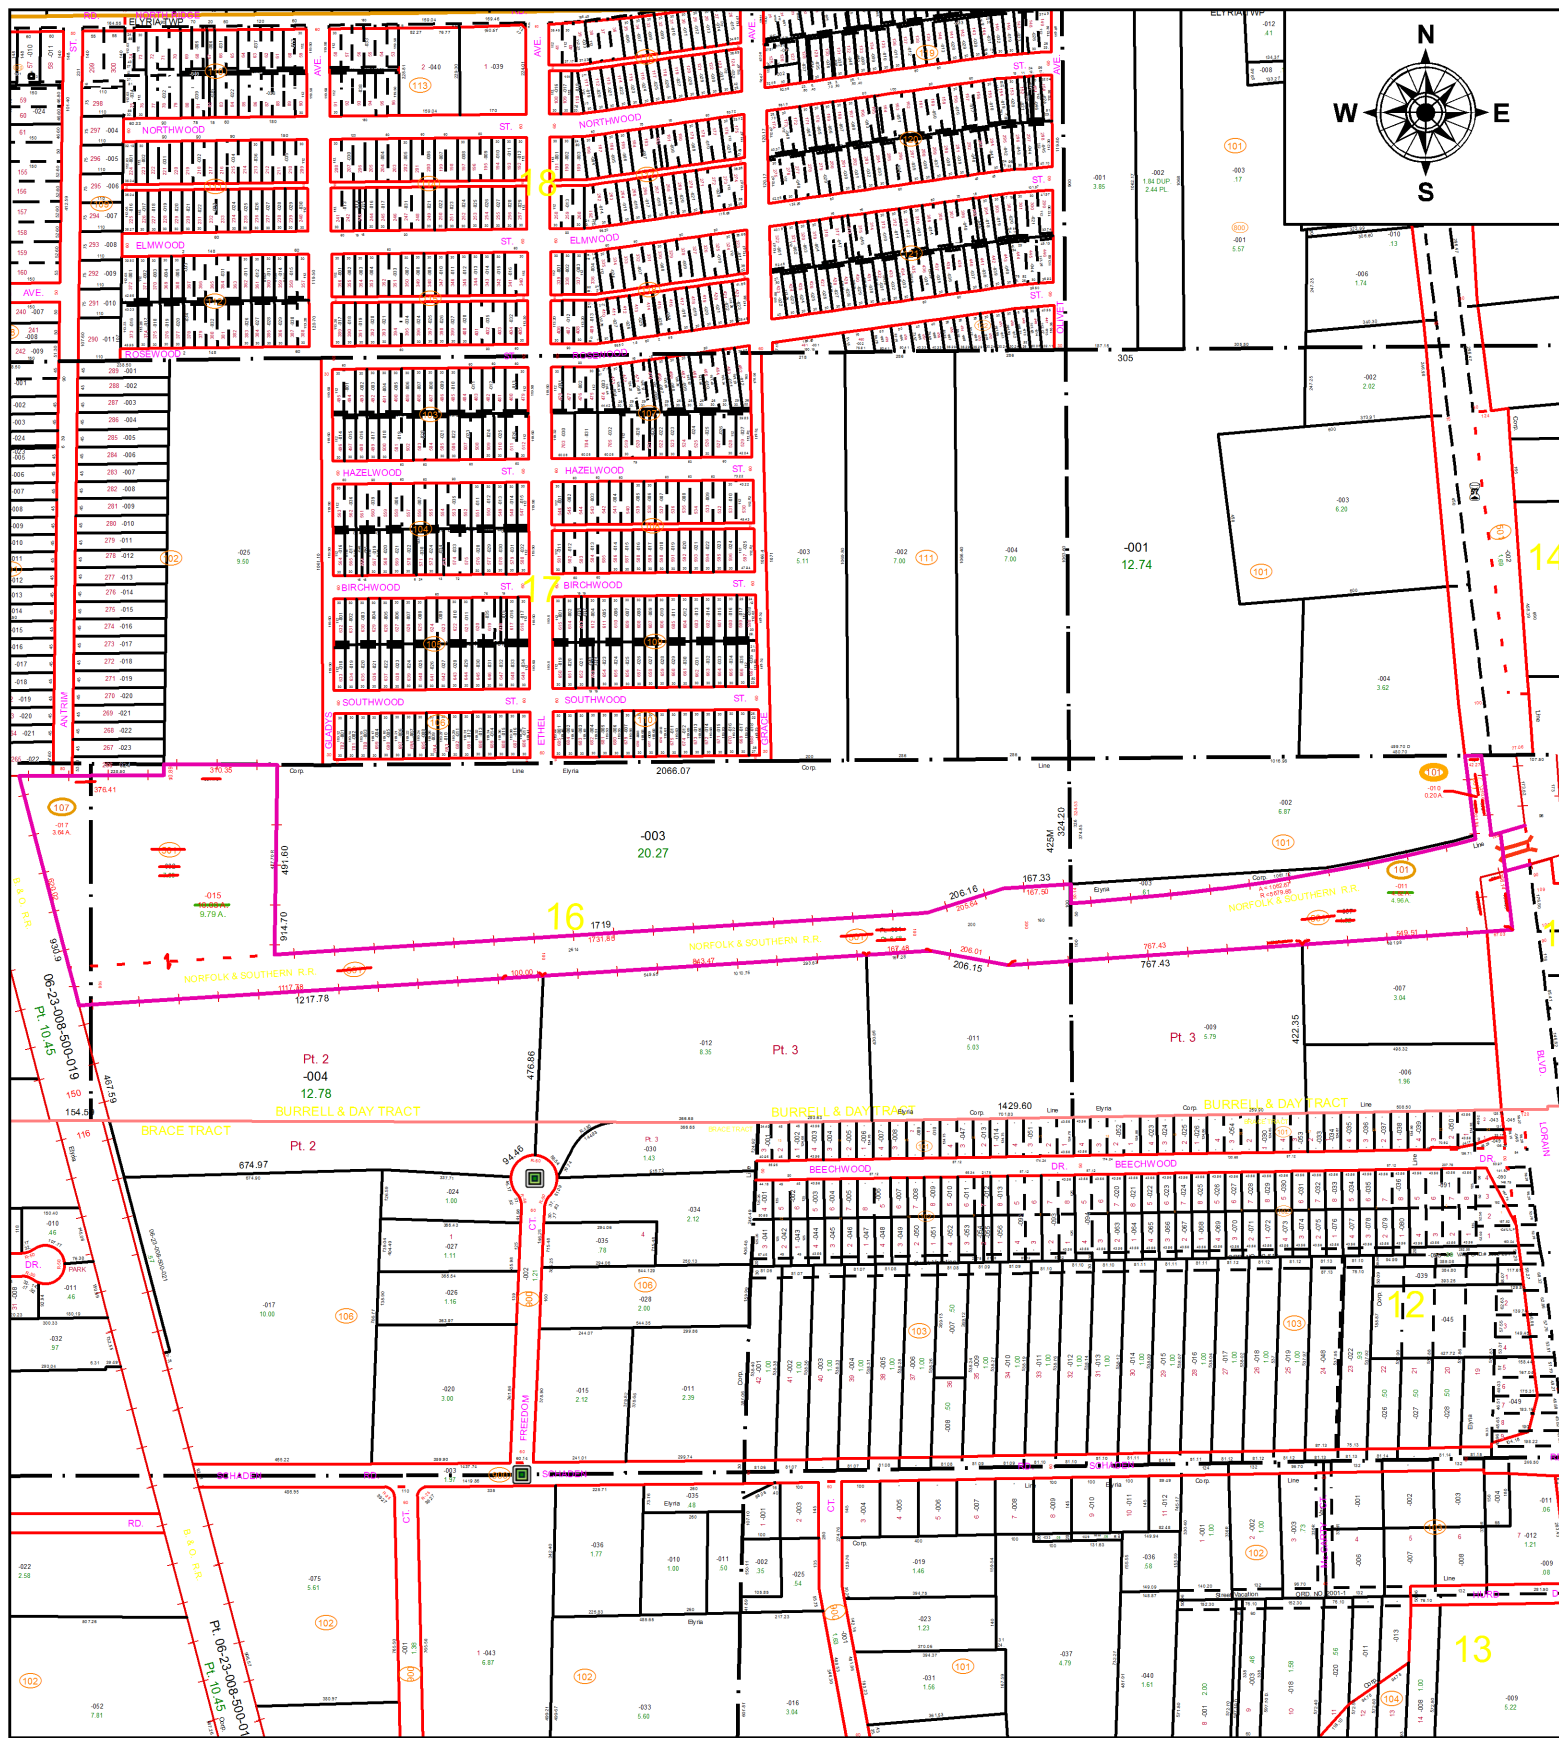

**SPLITS/DEEDS PROCESSED**  
 LORAIN COUNTY TAX MAP DEPARTMENT  
 226 MIDDLE AVE. ELYRIA, OH

**SURVEYED BY:** LELAND B. DILLWORTH  
**CLOSURE:** 1: 10,000  
**MAP PAGE(S):** 06-22-015, -016, -020  
**APPROVED BY:** TJS **DATE:** 7/1/16  
**SCALE:** 1" = 500 **PRIOR INSTRUMENT:** DV 1313/819