
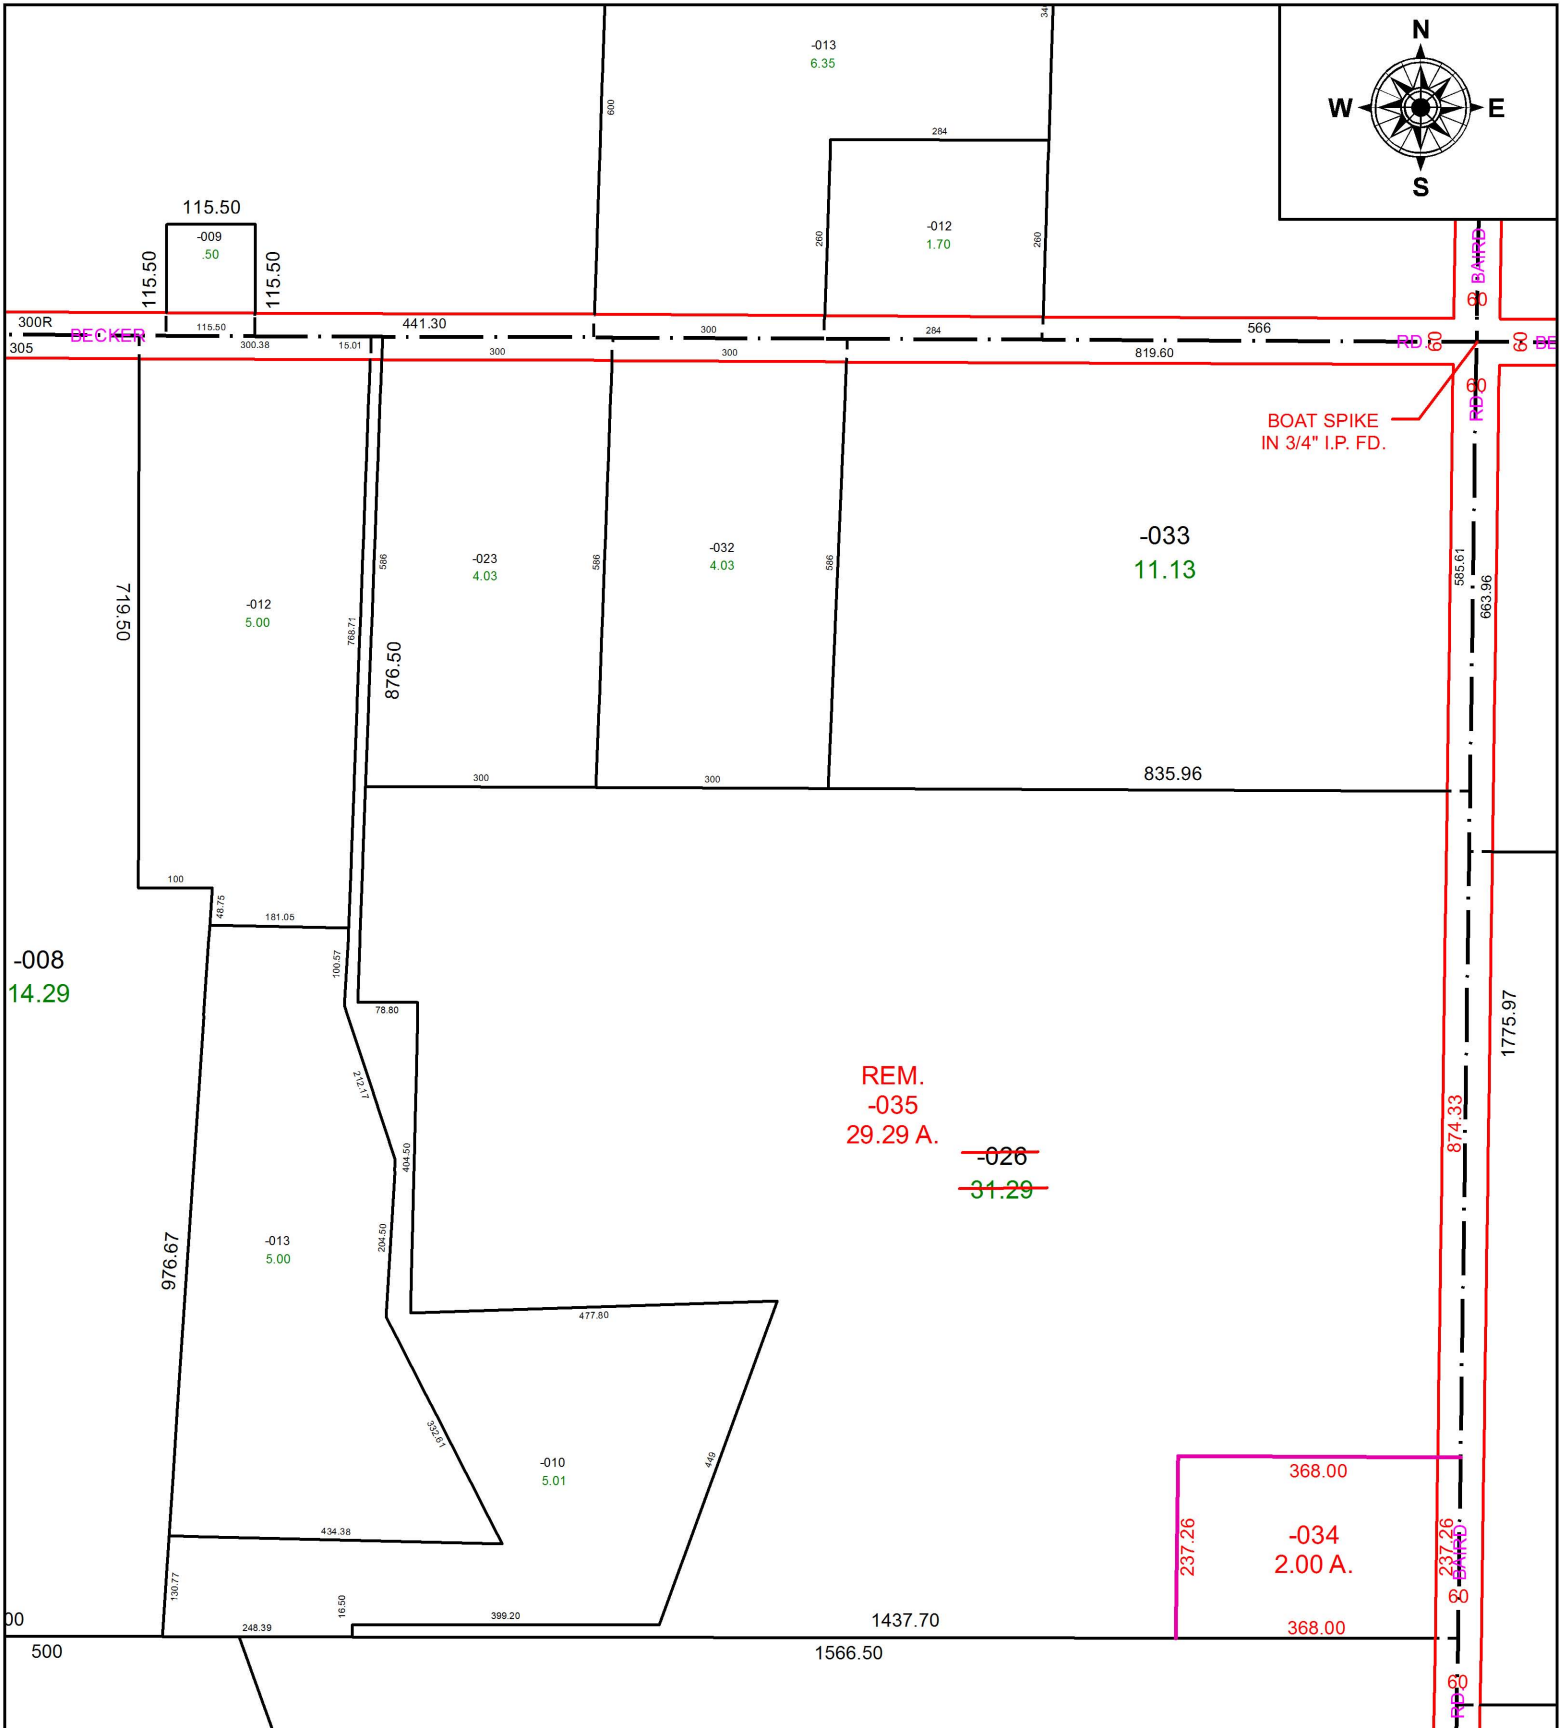


PARENT PARCEL: 08-12-013-000-026

CHILD PARCEL: 08-12-013-000-034 & -035

STARTING POINT: BOAT SPIKE IN 3/4" I.P. FD, CL OF BAIRD RD. & CL OF BECKER RD.

16-03532

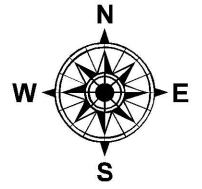


BOAT SPIKE  
IN 3/4" I.P. FD.

REM.  
-035  
29.29 A.

~~-026~~  
~~31.29~~

368.00  
-034  
2.00 A.  
368.00

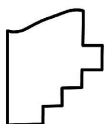

**SPLITS/DEEDS PROCESSED**  
LORAIN COUNTY TAX MAP DEPARTMENT  
226 MIDDLE AVE. ELYRIA, OH

SURVEYED BY: THOMAS M. SNEZEK

CLOSURE: 1: 400,000

MAP PAGE(S): 08-12-013

APPROVED BY: TJS DATE: 7/5/16

SCALE: 1" = 250 PRIOR INSTRUMENT: 2012-0437321