
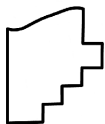


PARENT PARCEL: 03-00-008-000-027

CHILD PARCEL: 03-00-008-000-068 THRU -071

STARTING POINT: CENTERLINE OF ABBE RD & SOUTH LINE OF O.L. 8

16-03534

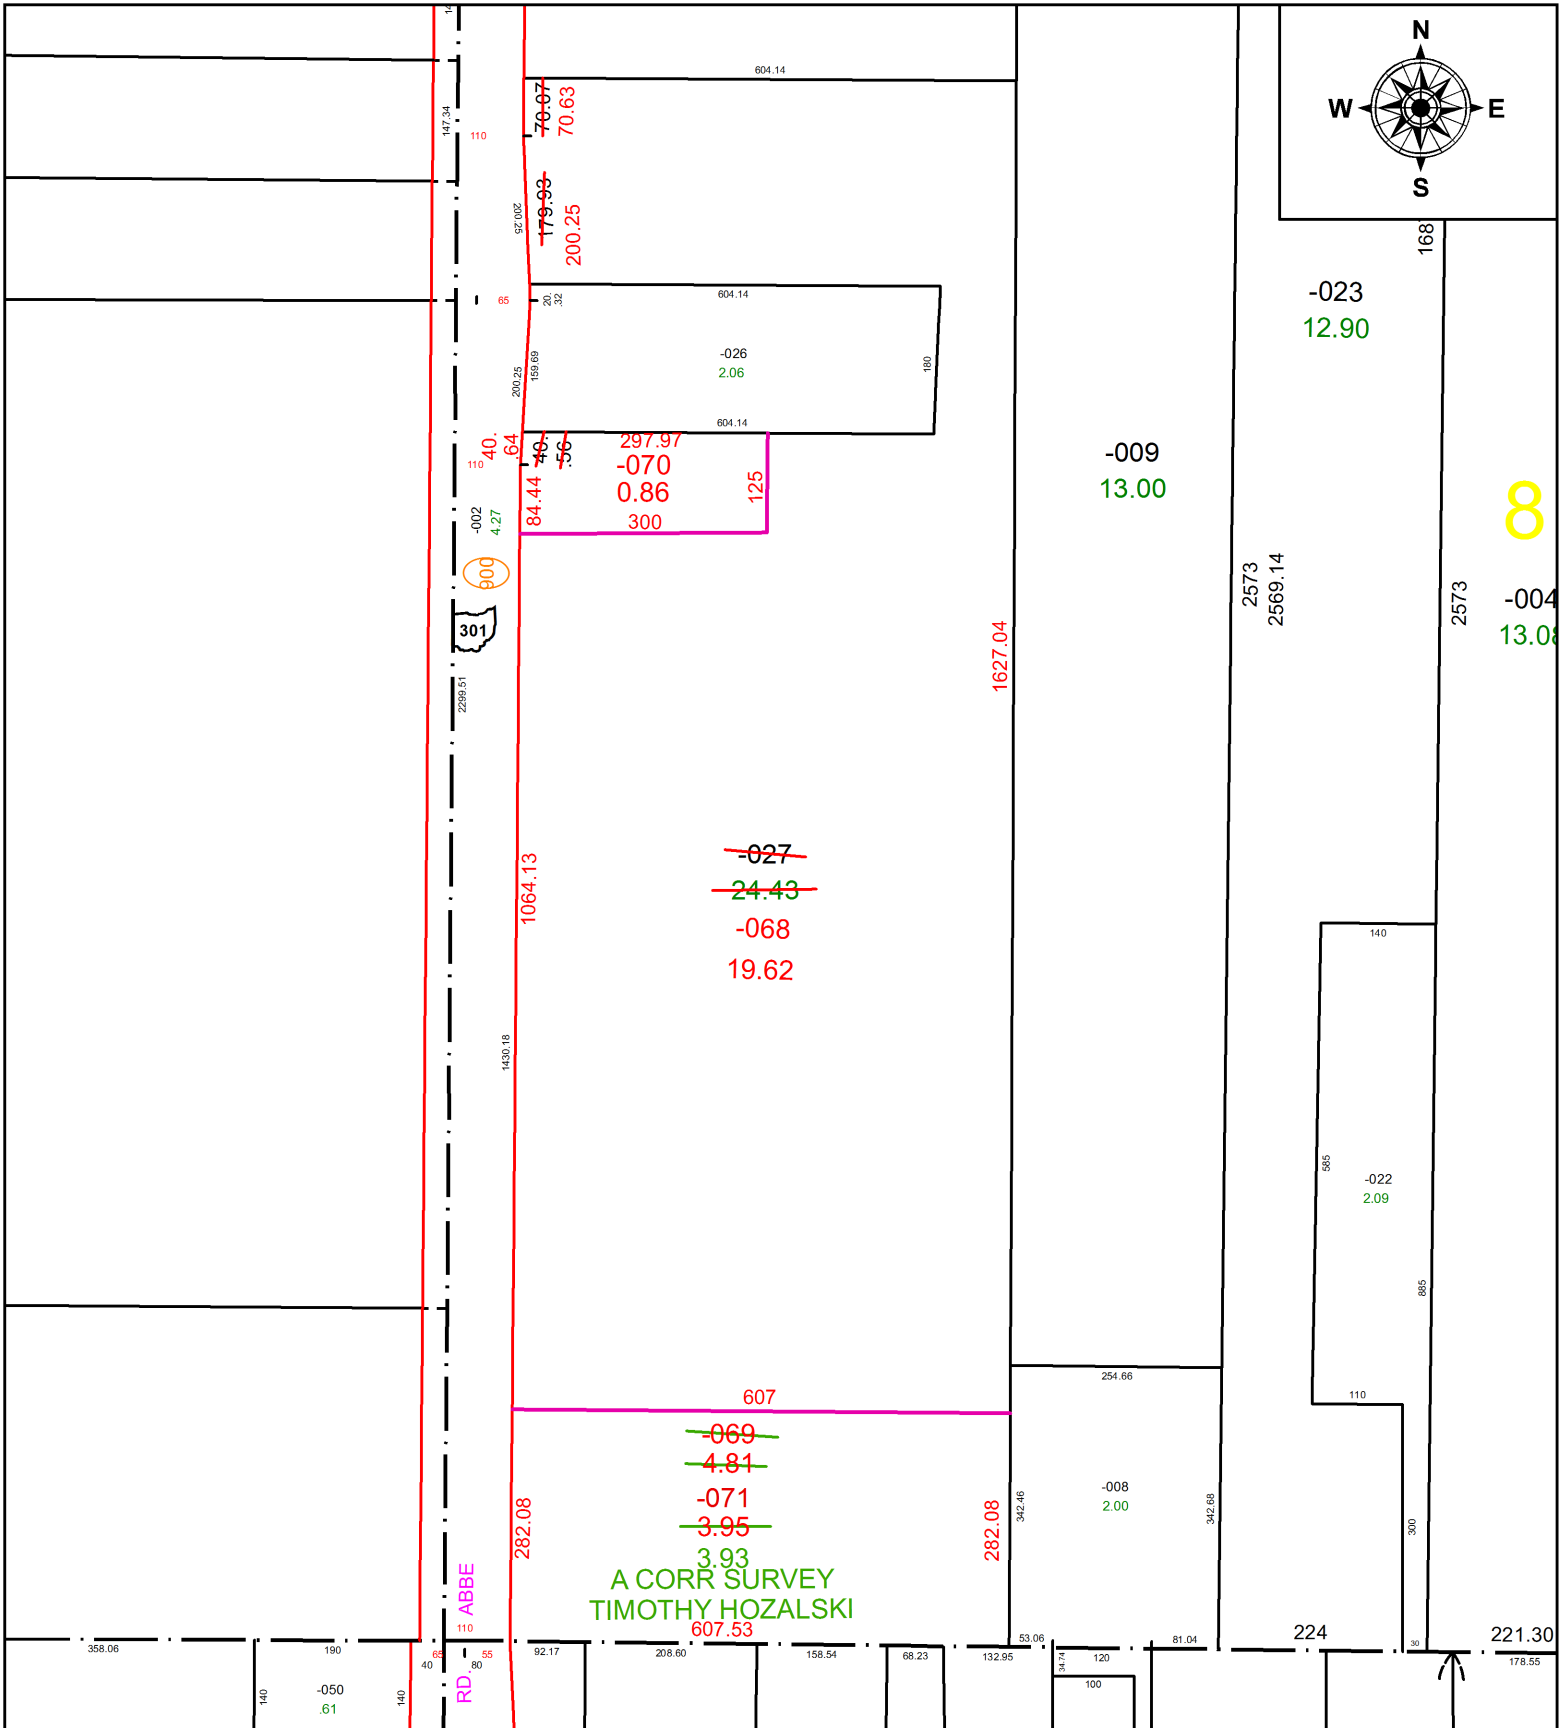

SPLITS/DEEDS PROCESSED
LORAIN COUNTY TAX MAP DEPARTMENT
226 MIDDLE AVE. ELYRIA, OH

SURVEYED BY:	TIMOTHY HOZALSKI		
CLOSURE:	1:691456		
MAP PAGE(S):	03-00-008		
APPROVED BY:	JAH	DATE:	7/6/2016
SCALE:	1 in = 233 ft	PRIOR INSTRUMENT:	20080269559