


PARENT PARCEL: 02-02-025-116-012


CHILD PARCEL: XX-XX-XXX-XXX-XXX

STARTING POINT: S/L 163 IN OAKLAND ADD.

16-03535-C

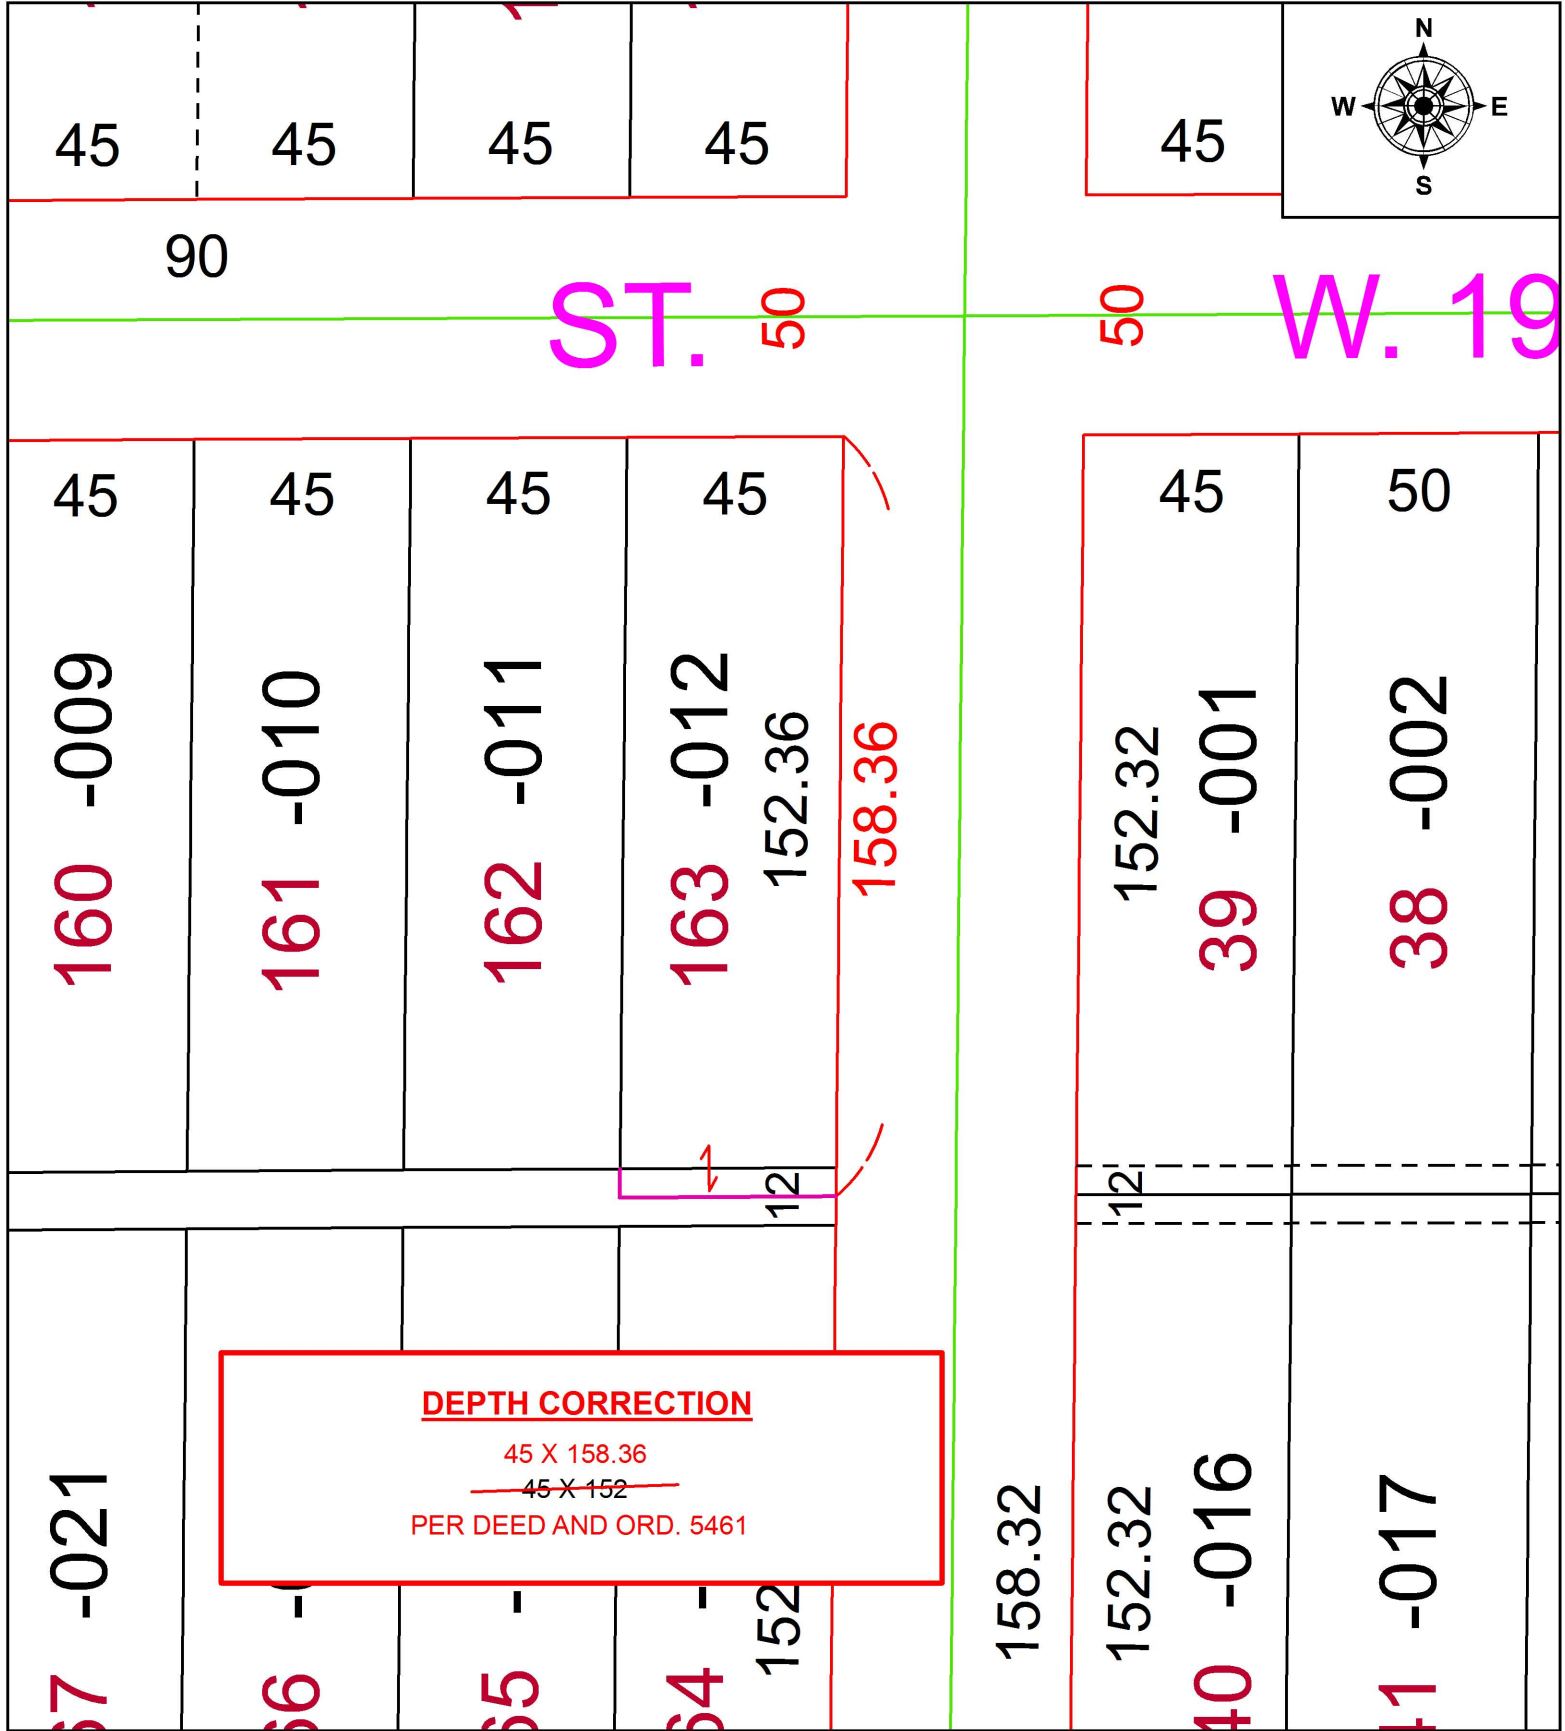

DEPTH CORRECTION
 45 X 158.36
~~45 X 152~~
 PER DEED AND ORD. 5461

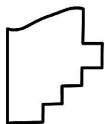

SPLITS/DEEDS PROCESSED
 LORAIN COUNTY TAX MAP DEPARTMENT
 226 MIDDLE AVE. ELYRIA, OH

SURVEYED BY: N/A
 CLOSURE: N/A
 MAP PAGE(S): 2-02-025
 APPROVED BY: RRM DATE: 10-4-16
 SCALE: 1" = 40 PRIOR INSTRUMENT: 20160589080