


PARENT PARCEL: 20-05-010-000-007, -005 20-05-004-000-012 (ST)


CHILD PARCEL: 20-05-010-000-009, -010, -011

STARTING POINT: CENTERLINE OF BURSLEY RD & QUARRY RD

16-03537

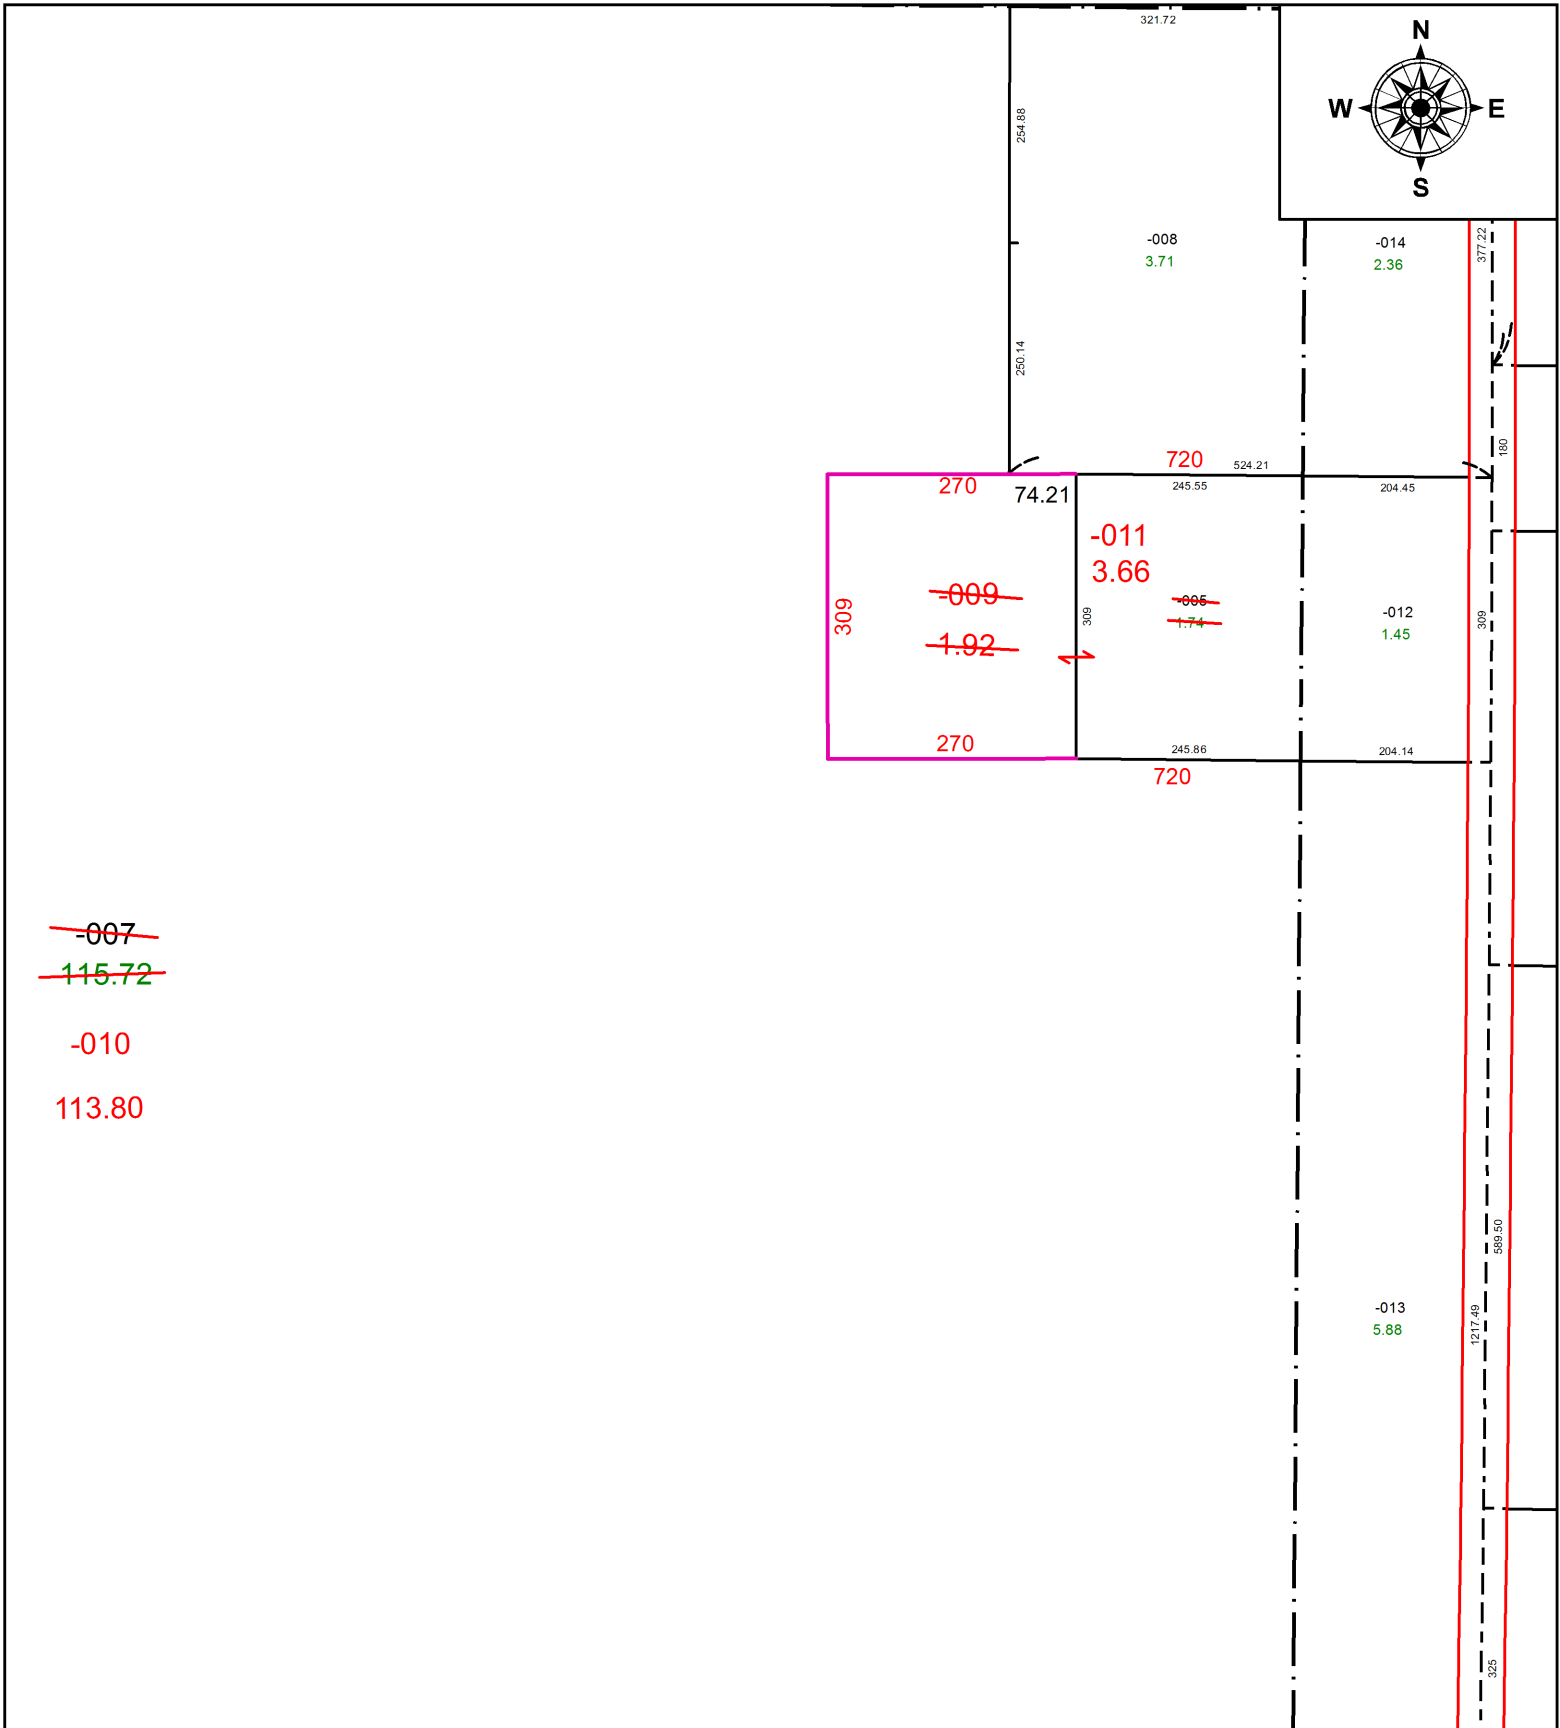

~~-007~~
~~115.72~~
 -010
 113.80

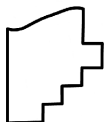

SPLITS/DEEDS PROCESSED
 LORAIN COUNTY TAX MAP DEPARTMENT
 226 MIDDLE AVE. ELYRIA, OH

SURVEYED BY: RICK CARLSON

CLOSURE: 1:-2147483648

MAP PAGE(S): 20-05-010

APPROVED BY: JAH DATE: 07/14/2016

SCALE: 1 in = 208 ft PRIOR INSTRUMENT: 20120418633