
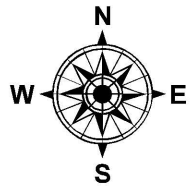


PARENT PARCEL: 05-00-025-101-008

CHILD PARCEL: 05-00-025-101-133, -134

STARTING POINT: NORTHWEST CORNER OF S/L 241

16-03540-U

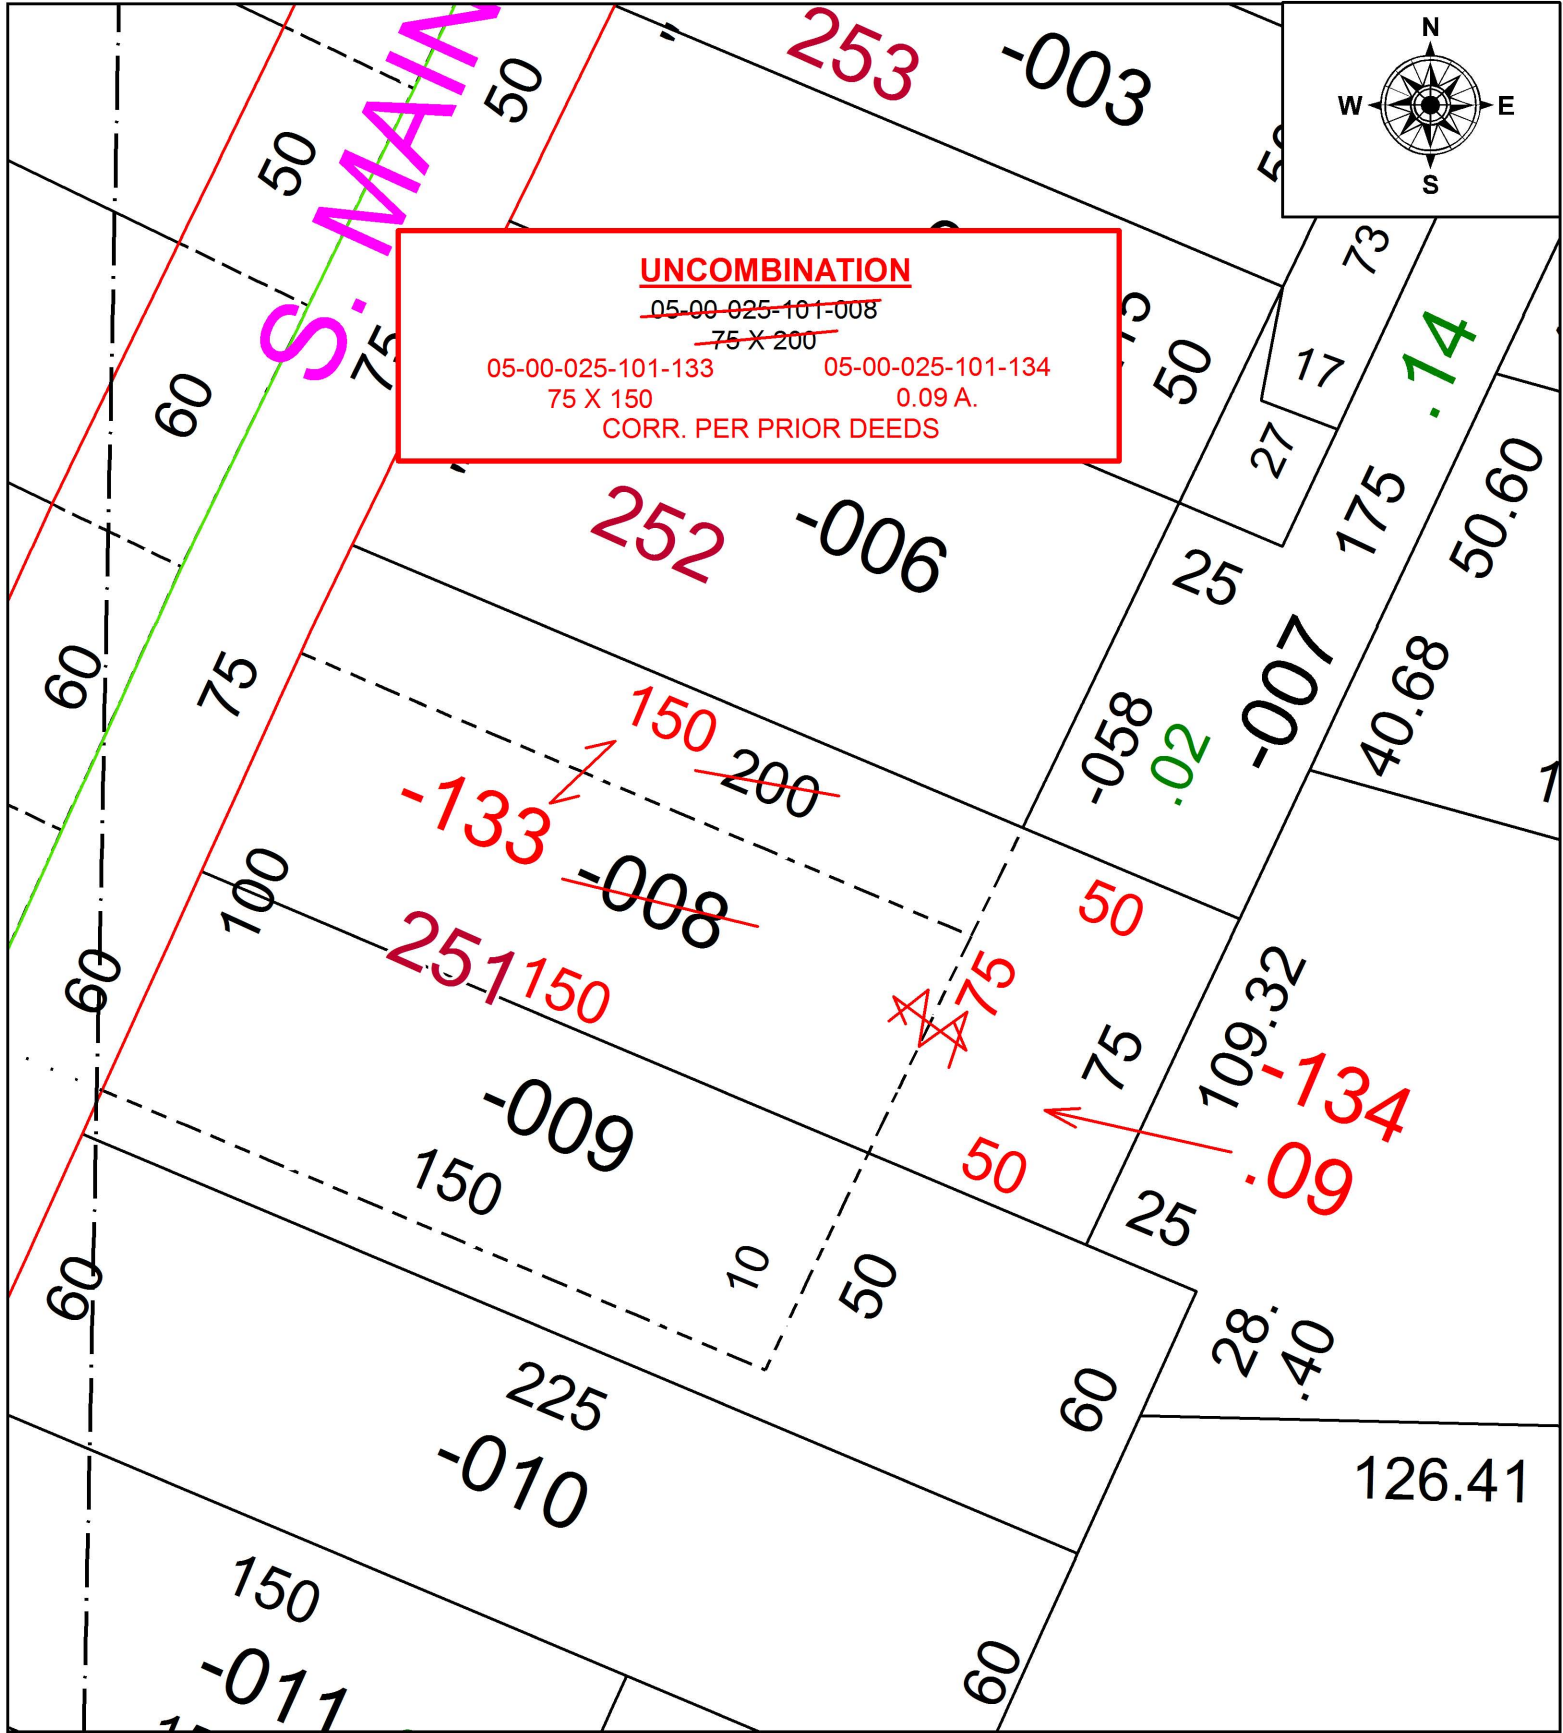

**SPLITS/DEEDS PROCESSED**  
 LORAIN COUNTY TAX MAP DEPARTMENT  
 226 MIDDLE AVE. ELYRIA, OH

SURVEYED BY: N/A  
 CLOSURE: N/A  
 MAP PAGE(S): 5-00-025  
 APPROVED BY: RRM      DATE: 10-12-16  
 SCALE: 1" = 40'      PRIOR INSTRUMENT: 20040016407