
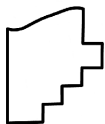


PARENT PARCEL: 06-21-001-101-059, -060, -033

CHILD PARCEL: 06-21-001-101-065

STARTING POINT: CENTERLINES OF OLD WEST RIDGE RD & MIDDLE RIDGE RD

16-03541

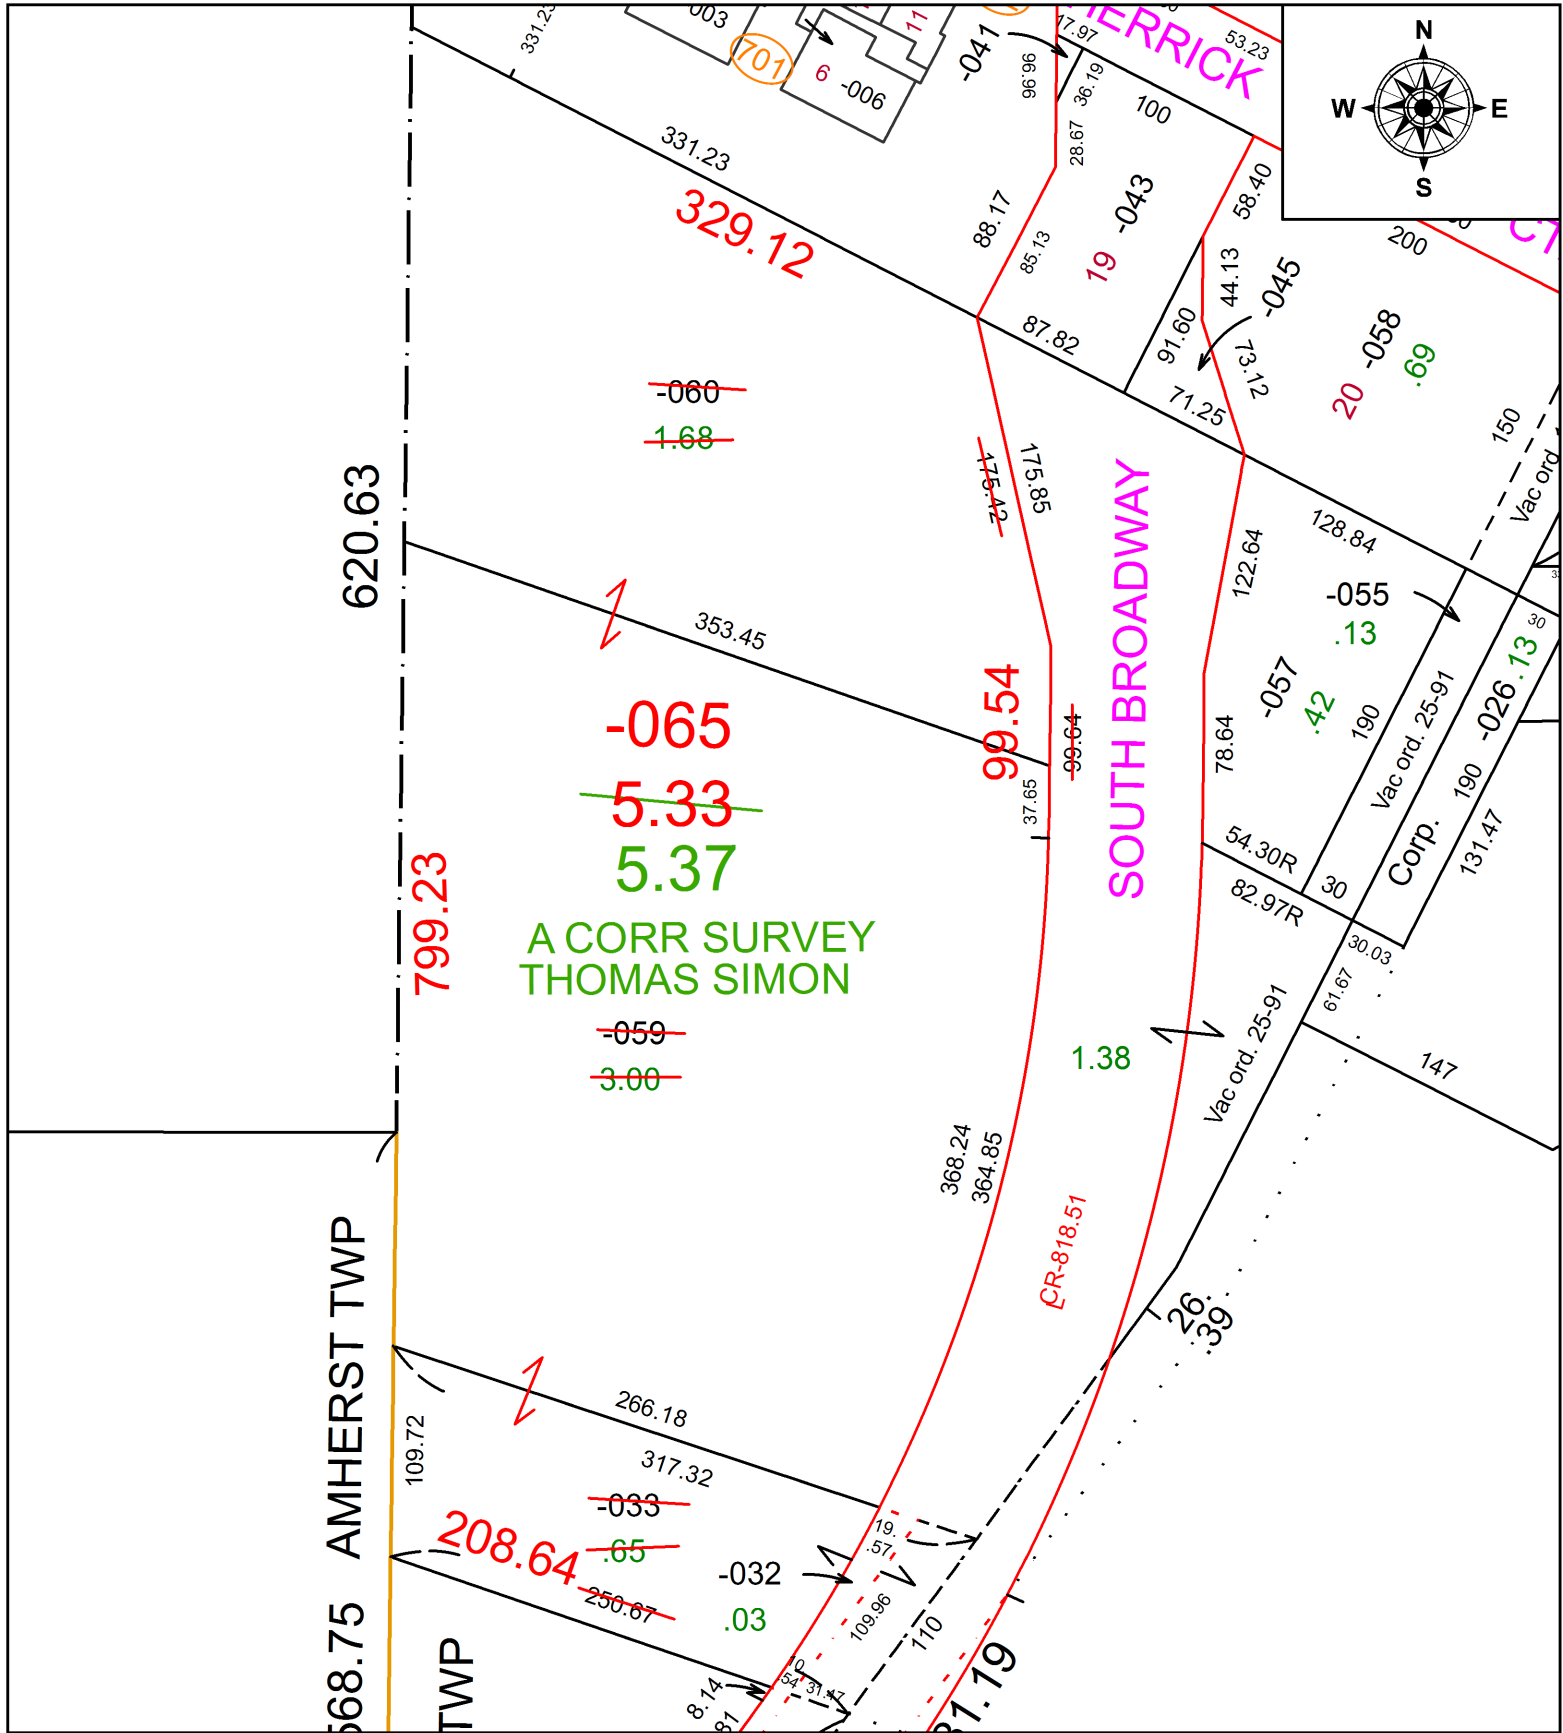

**SPLITS/DEEDS PROCESSED**  
 LORAIN COUNTY TAX MAP DEPARTMENT  
 226 MIDDLE AVE. ELYRIA, OH

SURVEYED BY: THOMAS SIMON  
 CLOSURE: 1:347458  
 MAP PAGE(S): 6-21  
 APPROVED BY: JAH DATE: 7/20/2016  
 SCALE: 1 in = 100 ft PRIOR INSTRUMENT: 20060178428