


PARENT PARCEL: 04-00-007-109-002


CHILD PARCEL: 04-00-007-109-018, -019

STARTING POINT: 155.48 FT SOUTHERLY FROM THE NORTHEAST CORNER OF S/L 16

16-03548-U

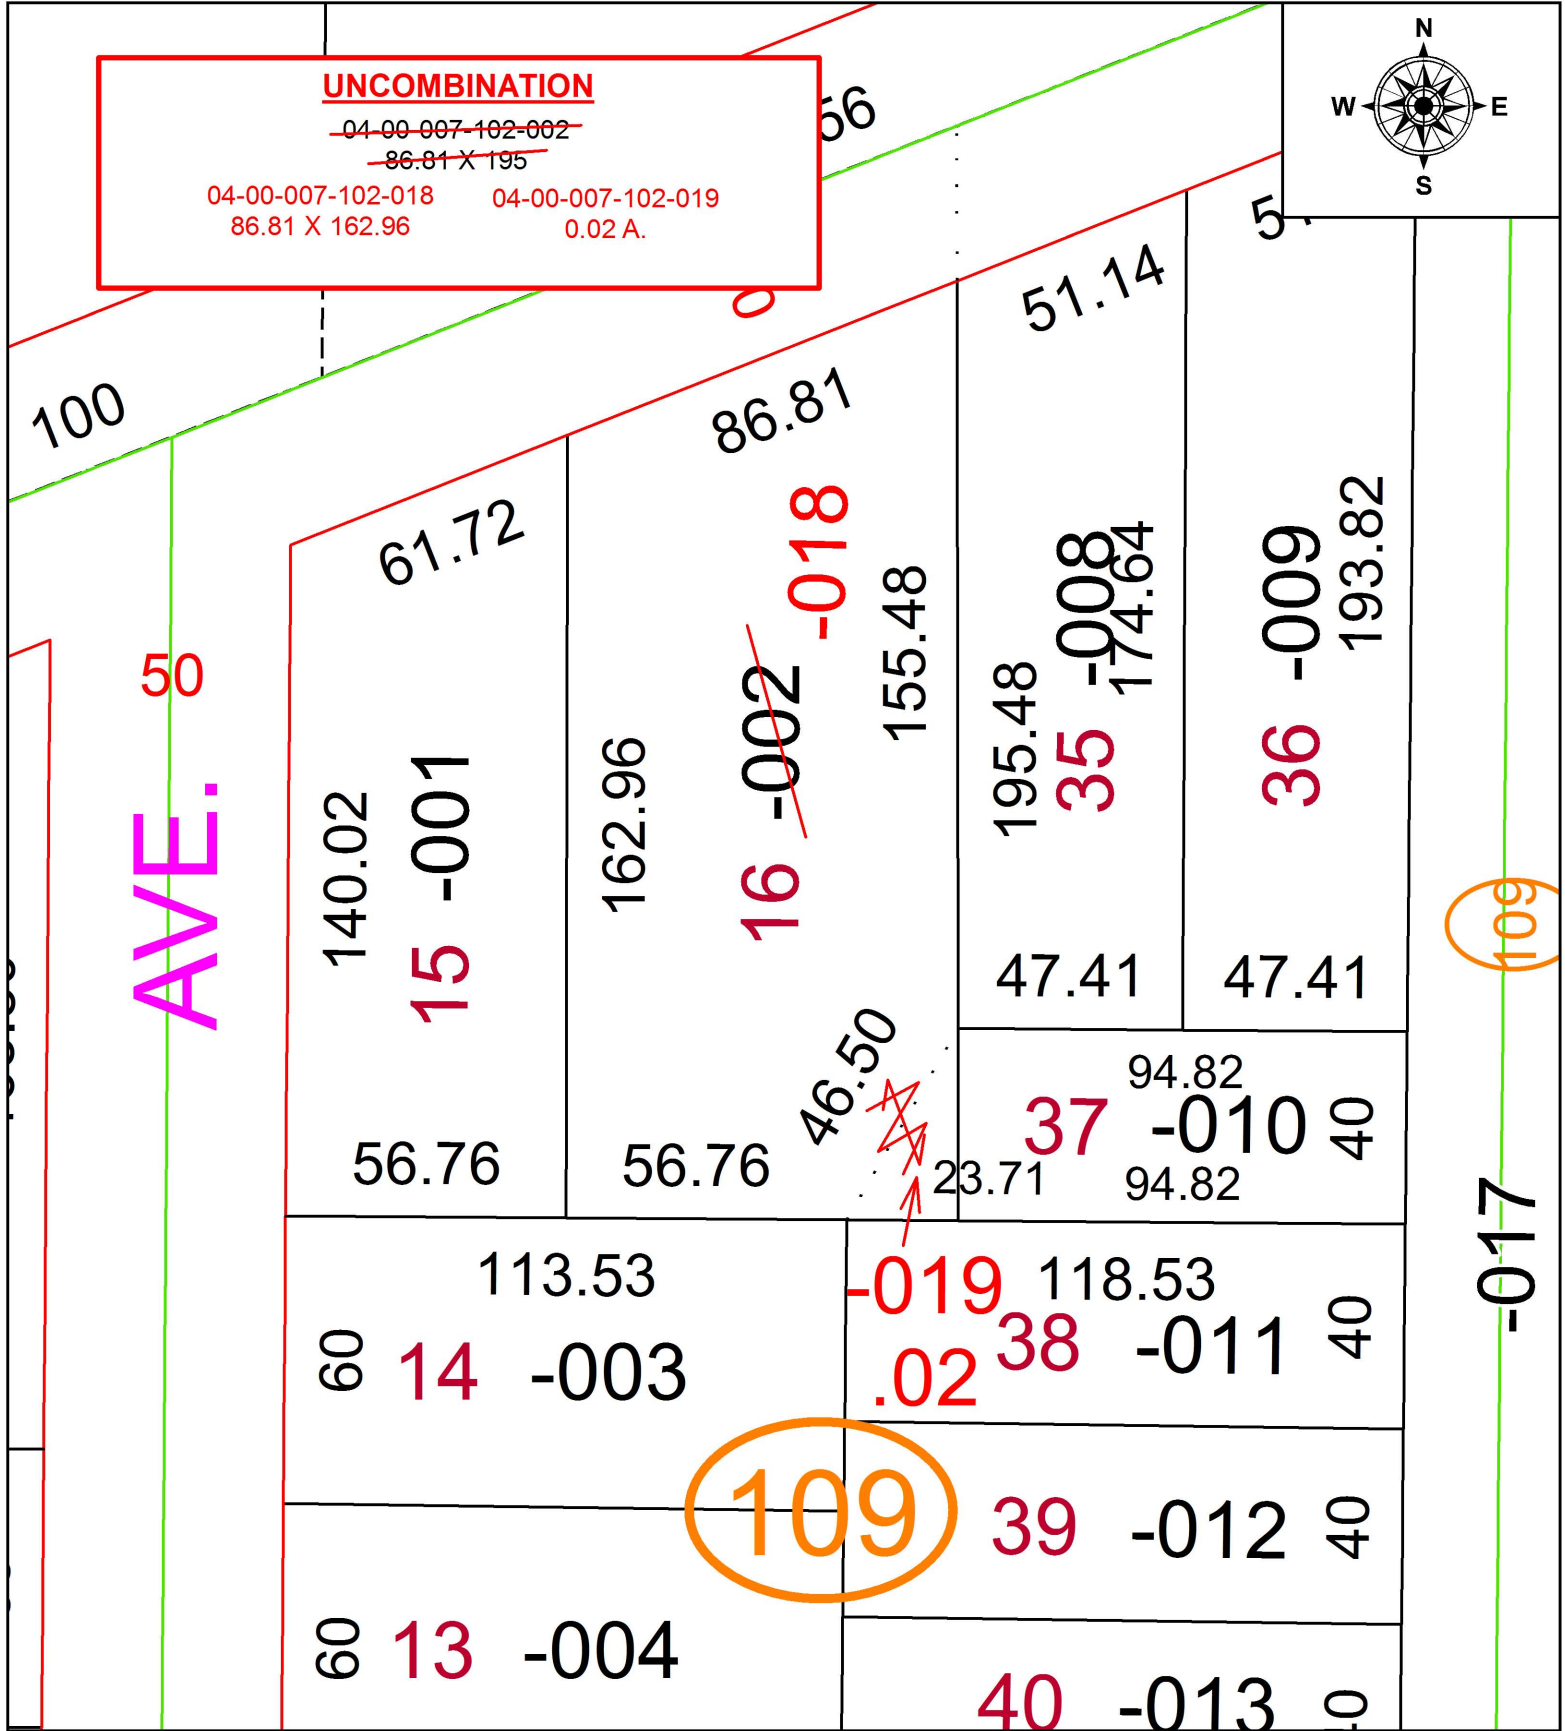

UNCOMBINATION
~~04-00-007-102-002~~
~~86.81 X 195~~
 04-00-007-102-018 04-00-007-102-019
 86.81 X 162.96 0.02 A.

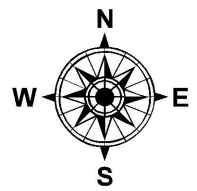


50
AVE.

109

109

-017

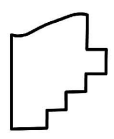

SPLITS/DEEDS PROCESSED
 LORAIN COUNTY TAX MAP DEPARTMENT
 226 MIDDLE AVE. ELYRIA, OH

SURVEYED BY: _____ N/A
 CLOSURE: _____ N/A
 MAP PAGE(S): _____ 4-00-007
 APPROVED BY: _____ RRM DATE: _____ 11-3-16
 SCALE: _____ 1" = 40 PRIOR INSTRUMENT: _____ 201012270783