


PARENT PARCEL: 15-00-099-101-228

CHILD PARCEL: 15-00-099-101-229 THRU -233

STARTING POINT: SOUTHEAST CORNER OF O.L.99

16-03548

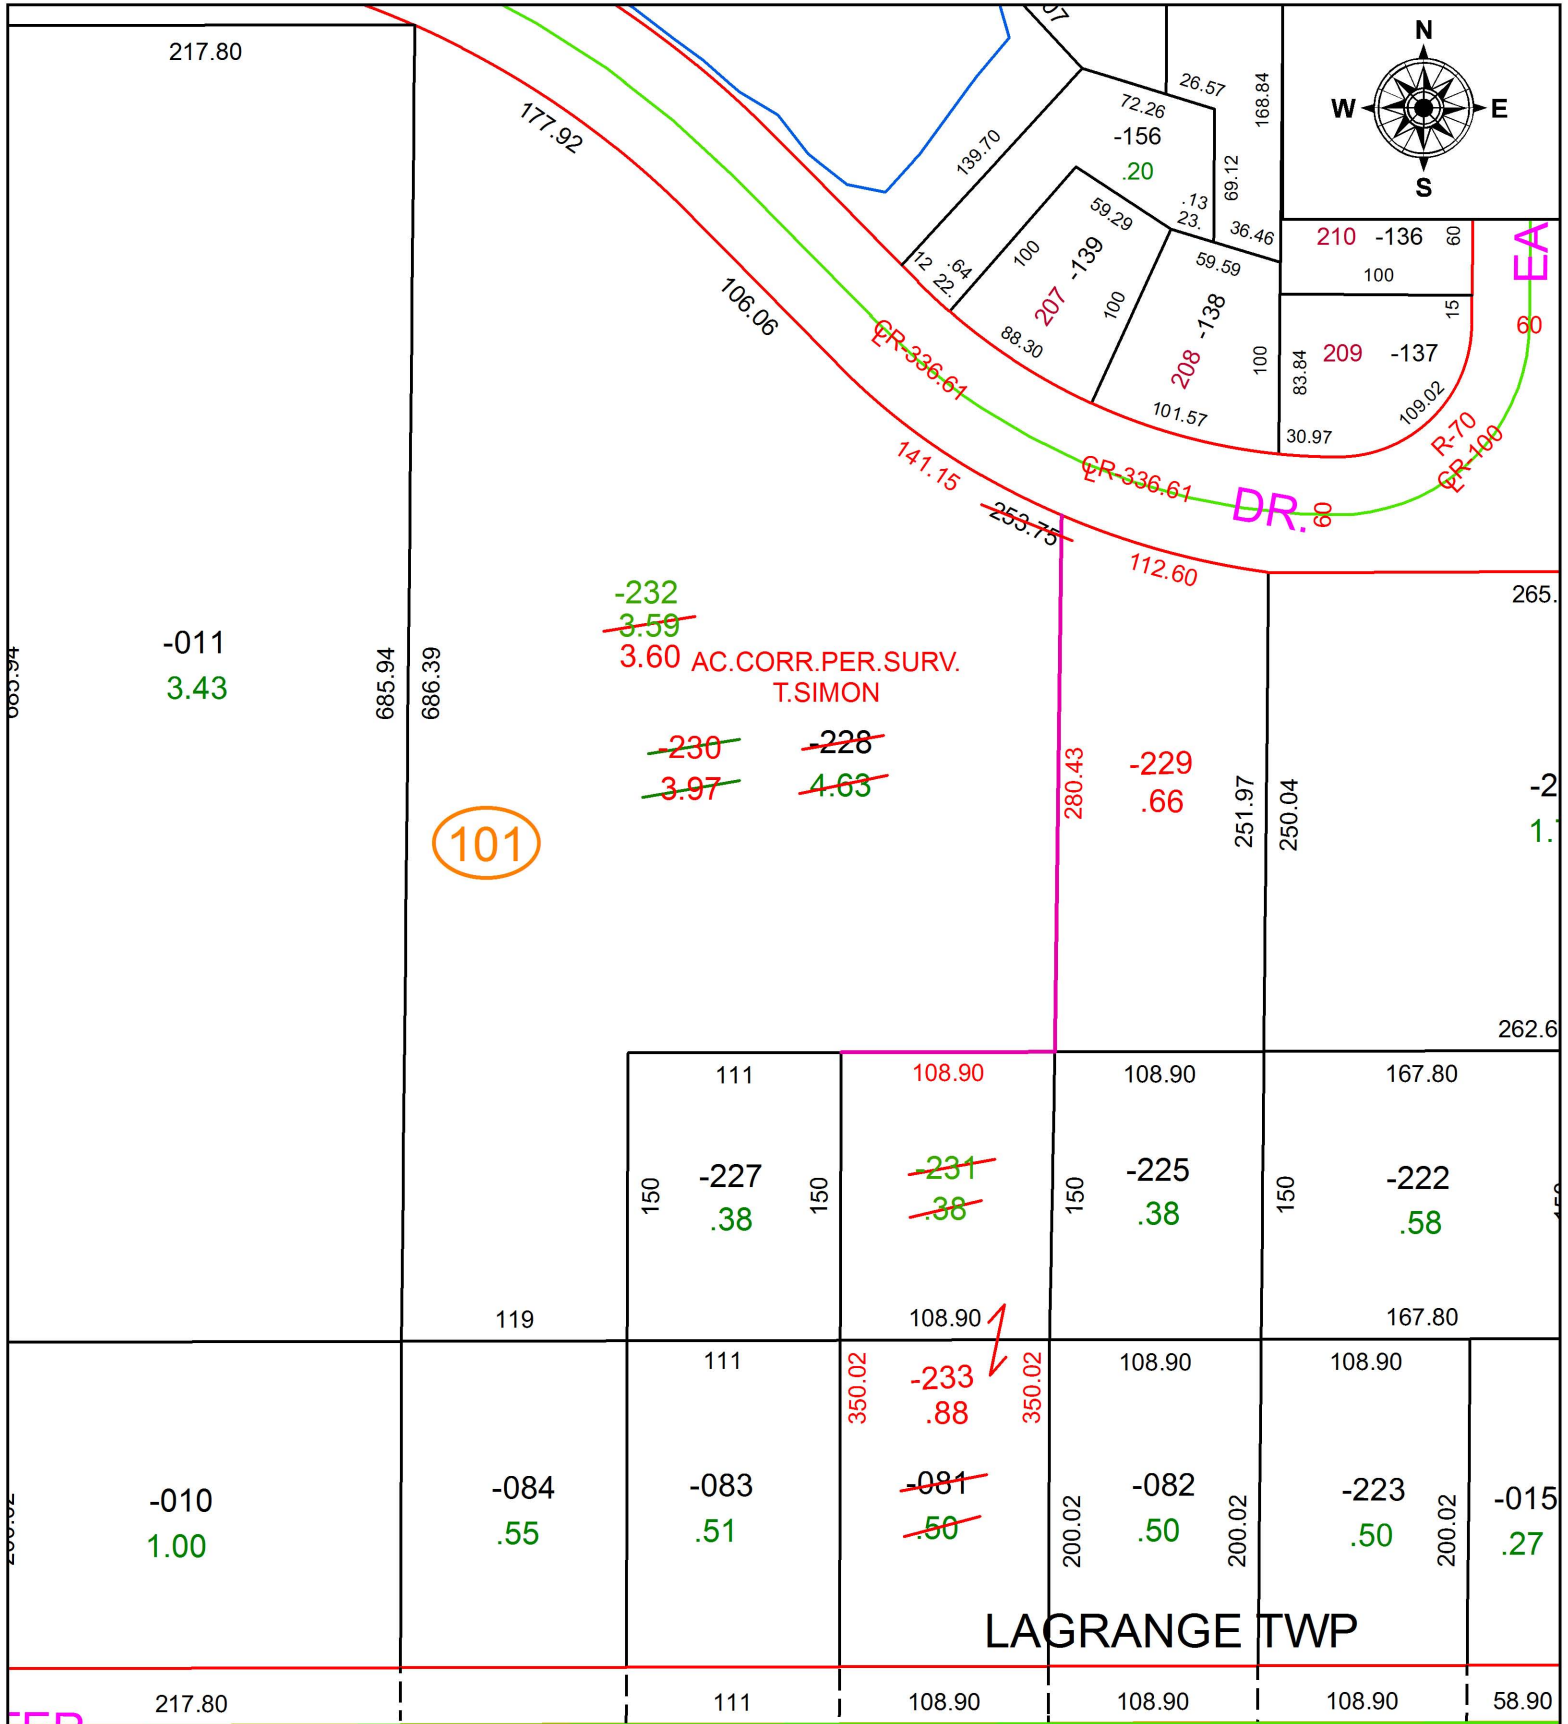


101

~~-232~~
~~3.59~~
3.60 AC. CORR. PER. SURV.
T. SIMON

~~-230~~ ~~-228~~
~~3.97~~ ~~4.63~~

LAGRANGE TWP

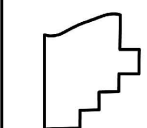

SPLITS/DEEDS PROCESSED
 LORAIN COUNTY TAX MAP DEPARTMENT
 226 MIDDLE AVE. ELYRIA, OH

SURVEYED BY: THOMAS A. SIMON
 CLOSURE: 1: 182,301
 MAP PAGE(S): 15-00-099
 APPROVED BY: RRM DATE: 8-2-16
 SCALE: 1" = 100 PRIOR INSTRUMENT: PLAT V 102/7