


PARENT PARCEL: 03-00-007-102-004, -022

CHILD PARCEL: 03-00-007-102-059

STARTING POINT: INTERSECTION OF C/L OF ABBE RD. AND SOUTH LINE OF O.L.7

16-03550-C

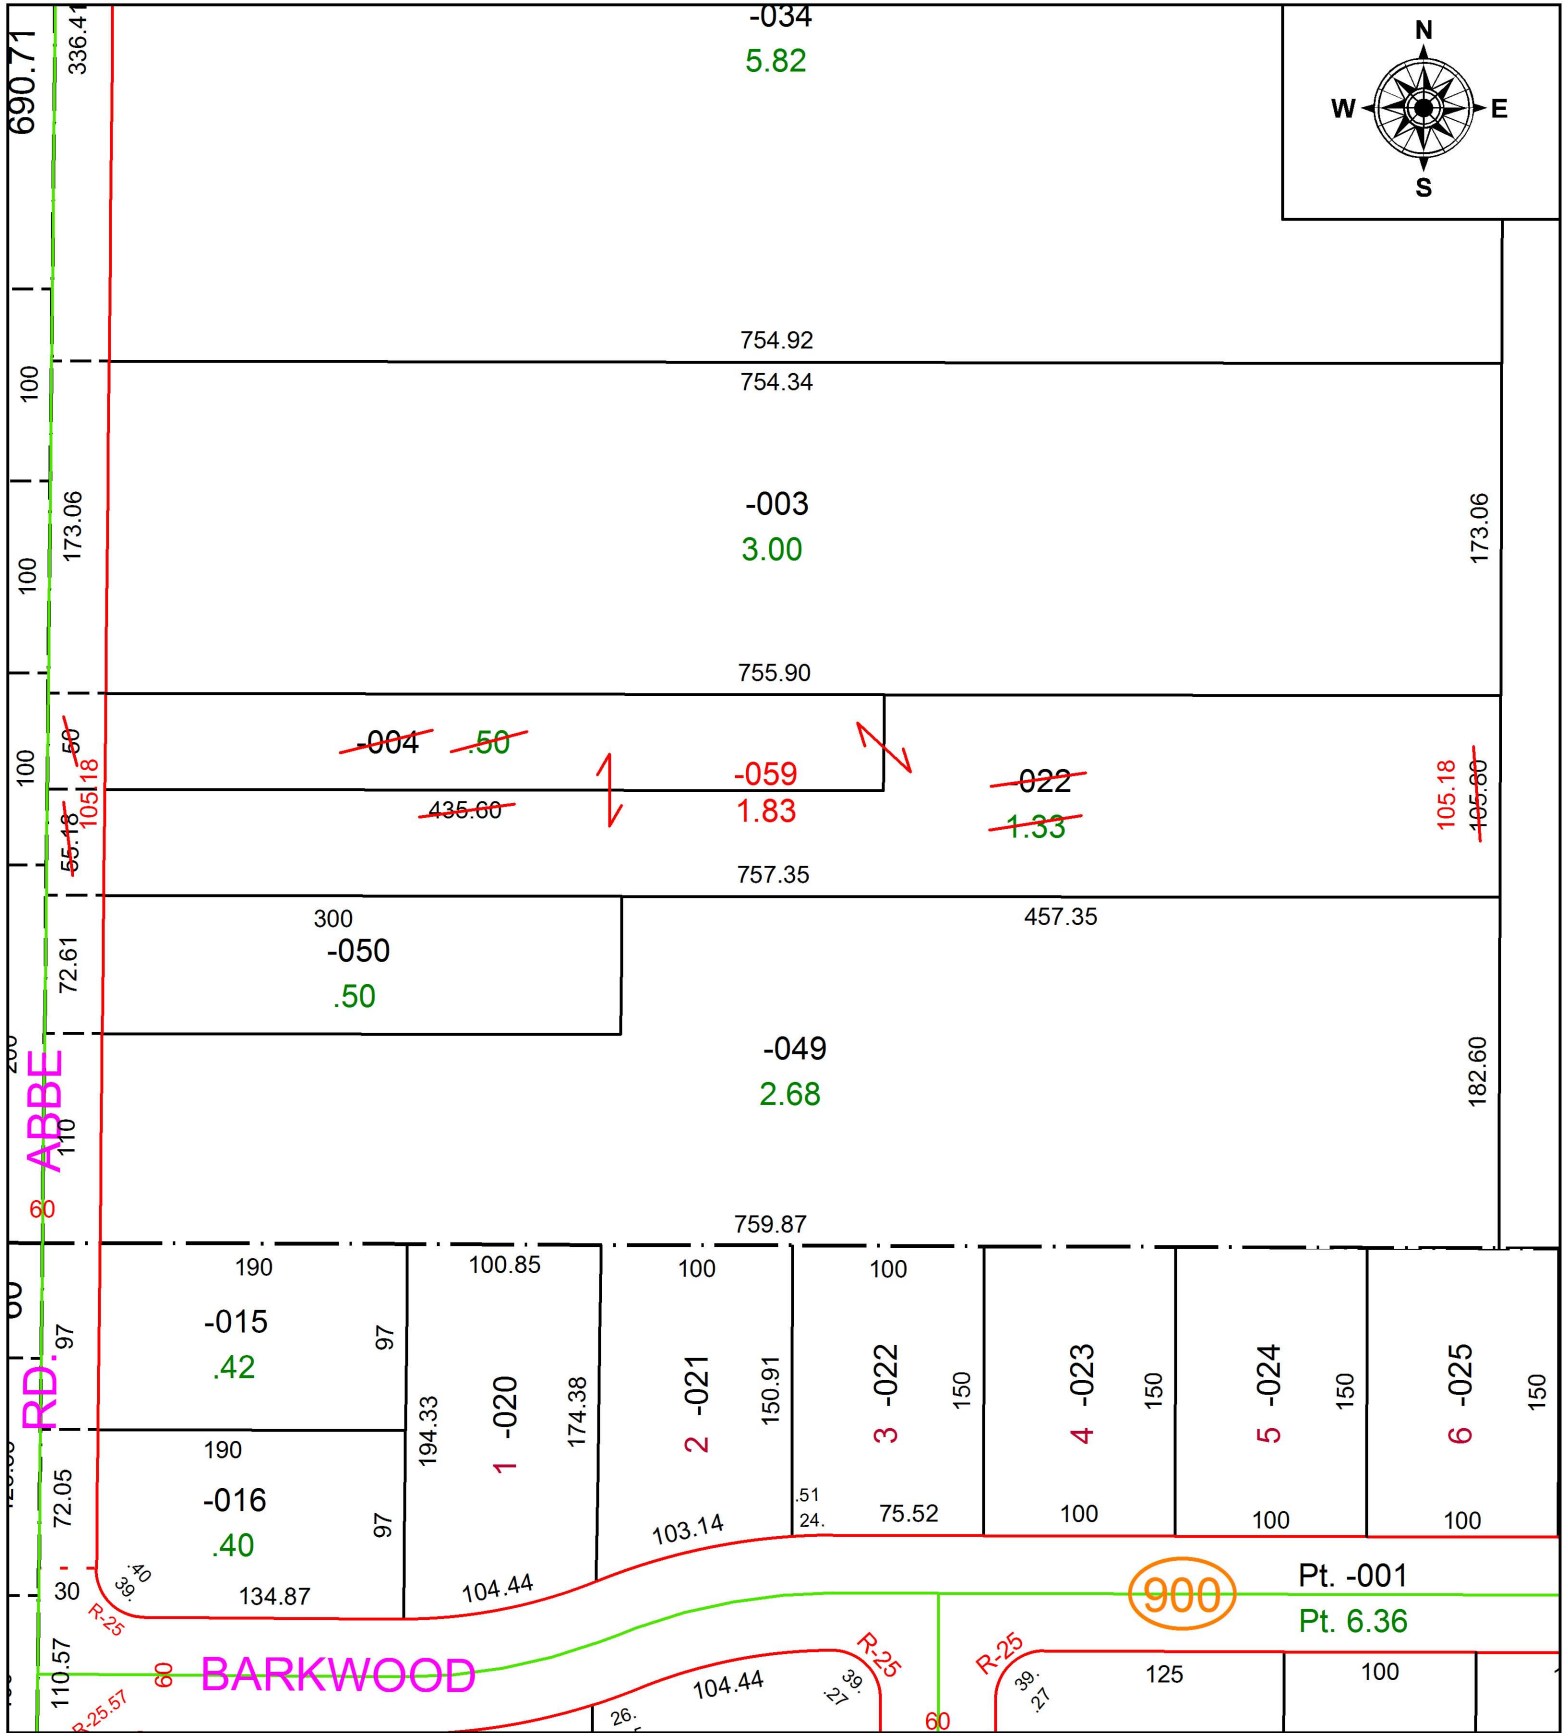

SPLITS/DEEDS PROCESSED
 LORAIN COUNTY TAX MAP DEPARTMENT
 226 MIDDLE AVE. ELYRIA, OH

SURVEYED BY: _____ N/A
 CLOSURE: _____ 1: 3,496
 MAP PAGE(S): _____ 3-00-007
 APPROVED BY: _____ RRM DATE: _____ 11-7-16
 SCALE: _____ 1" = 100 PRIORITY INSTRUMENT: _____ 20060146274