


PARENT PARCEL: 04-00-002-101-175-176

CHILD PARCEL: 04-00-002-101-358 THRU -366

STARTING POINT: CENTERLINE OF MOON RD & CASE RD

16-03551

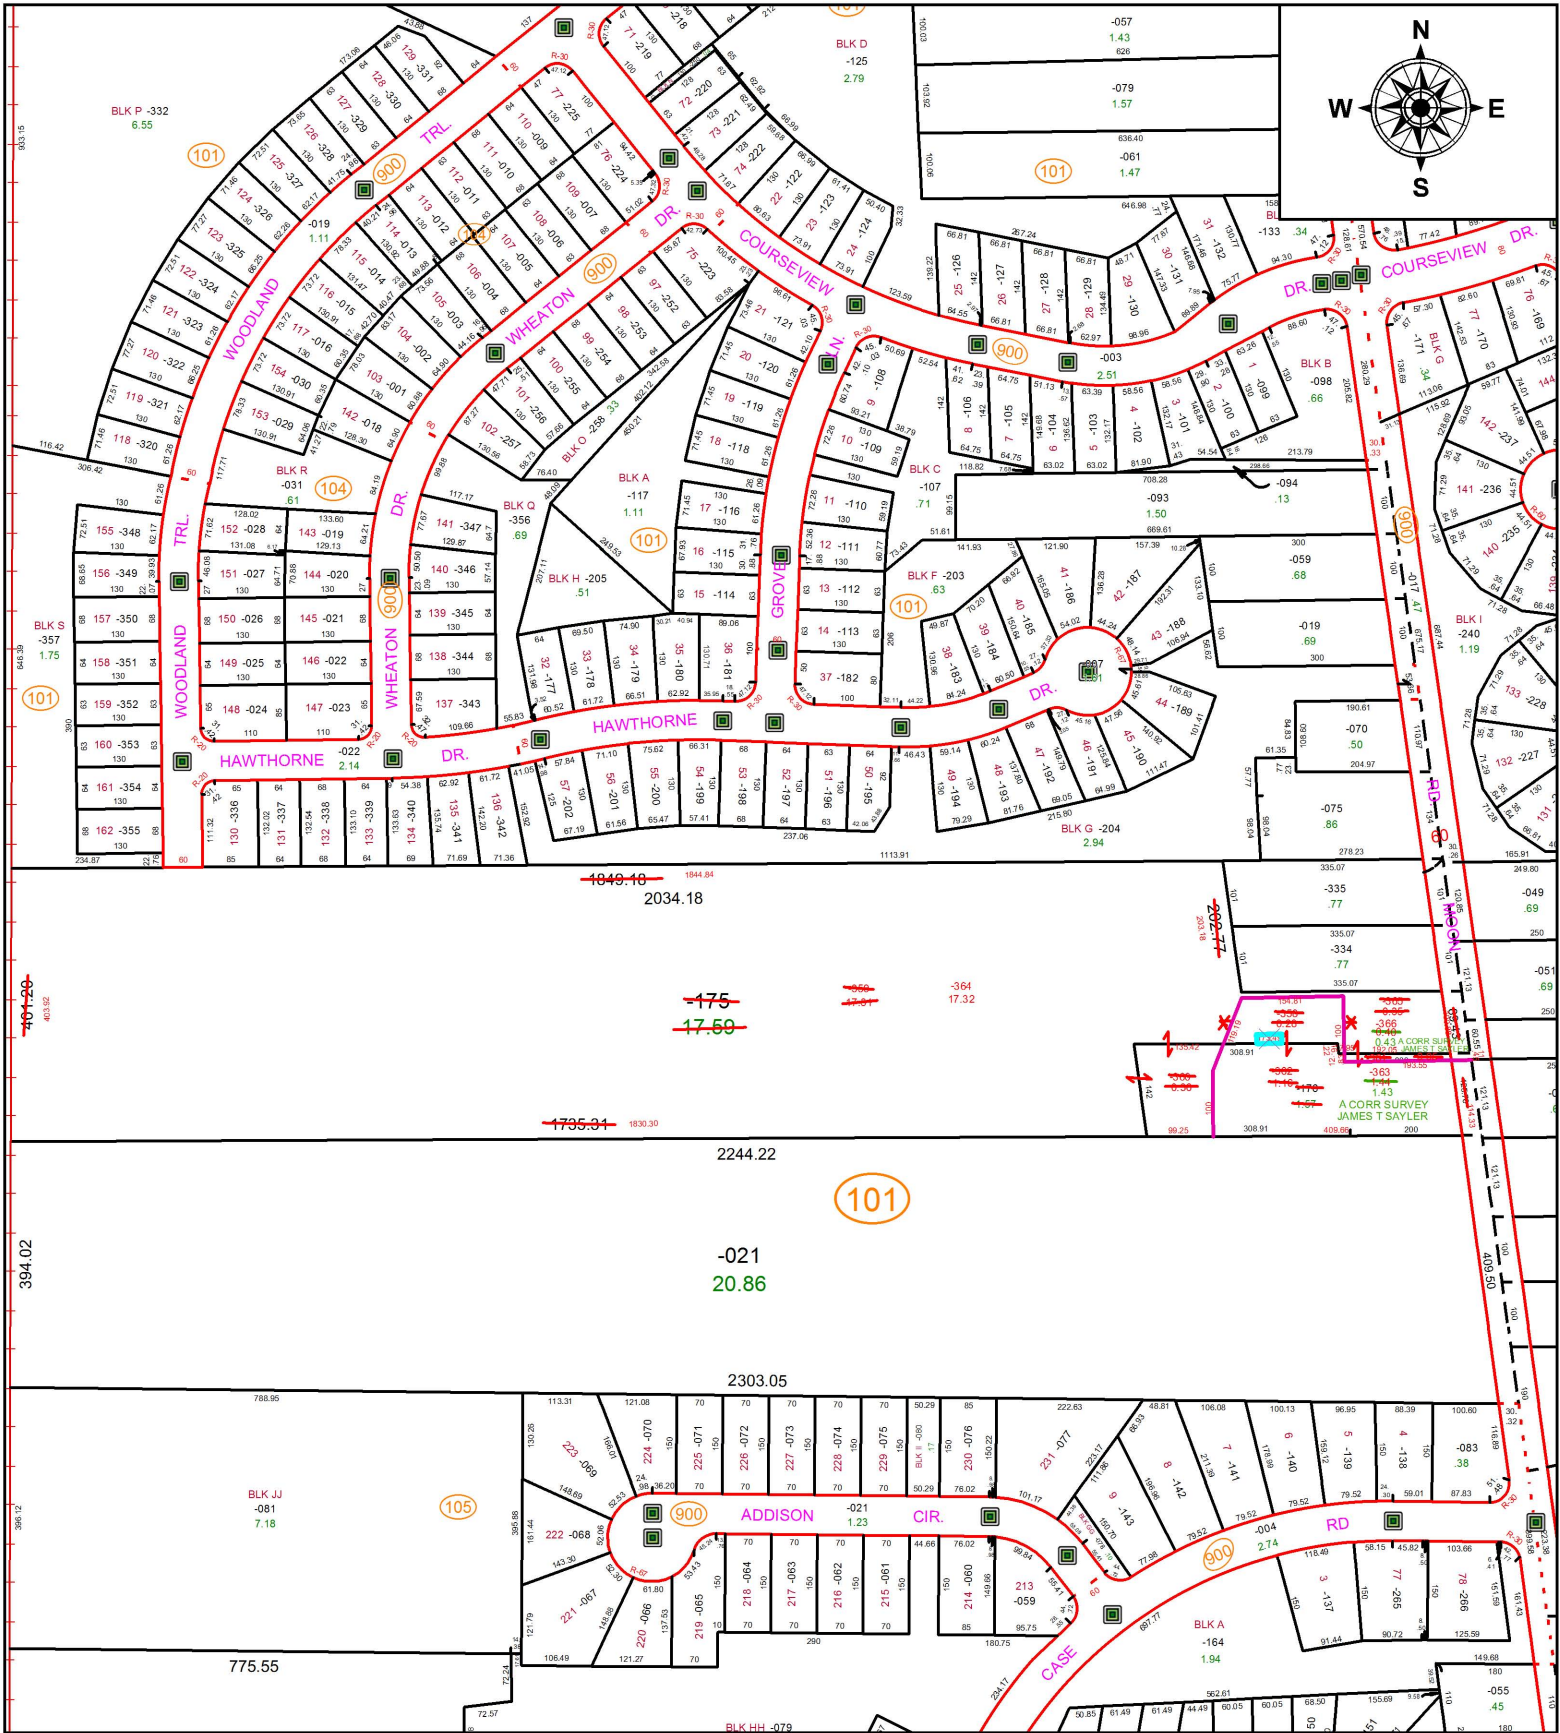

SPLITS/DEEDS PROCESSED
 LORAIN COUNTY TAX MAP DEPARTMENT
 226 MIDDLE AVE. ELYRIA, OH

SURVEYED BY: JAMES T SAYLER
CLOSURE: 1:798493
MAP PAGE(S): 04-00-002
APPROVED BY: JAH **DATE:** 8/11/2016
SCALE: 1 in = 292 ft **PRIOR INSTRUMENT:** 20160585084