


PARENT PARCEL: 15-00-042-000-006

CHILD PARCEL: 15-00-042-000-014, -015

STARTING POINT: CENTERLINE OF DIAGONAL RD & NORTH LINE OF O.L. 42


16-03553

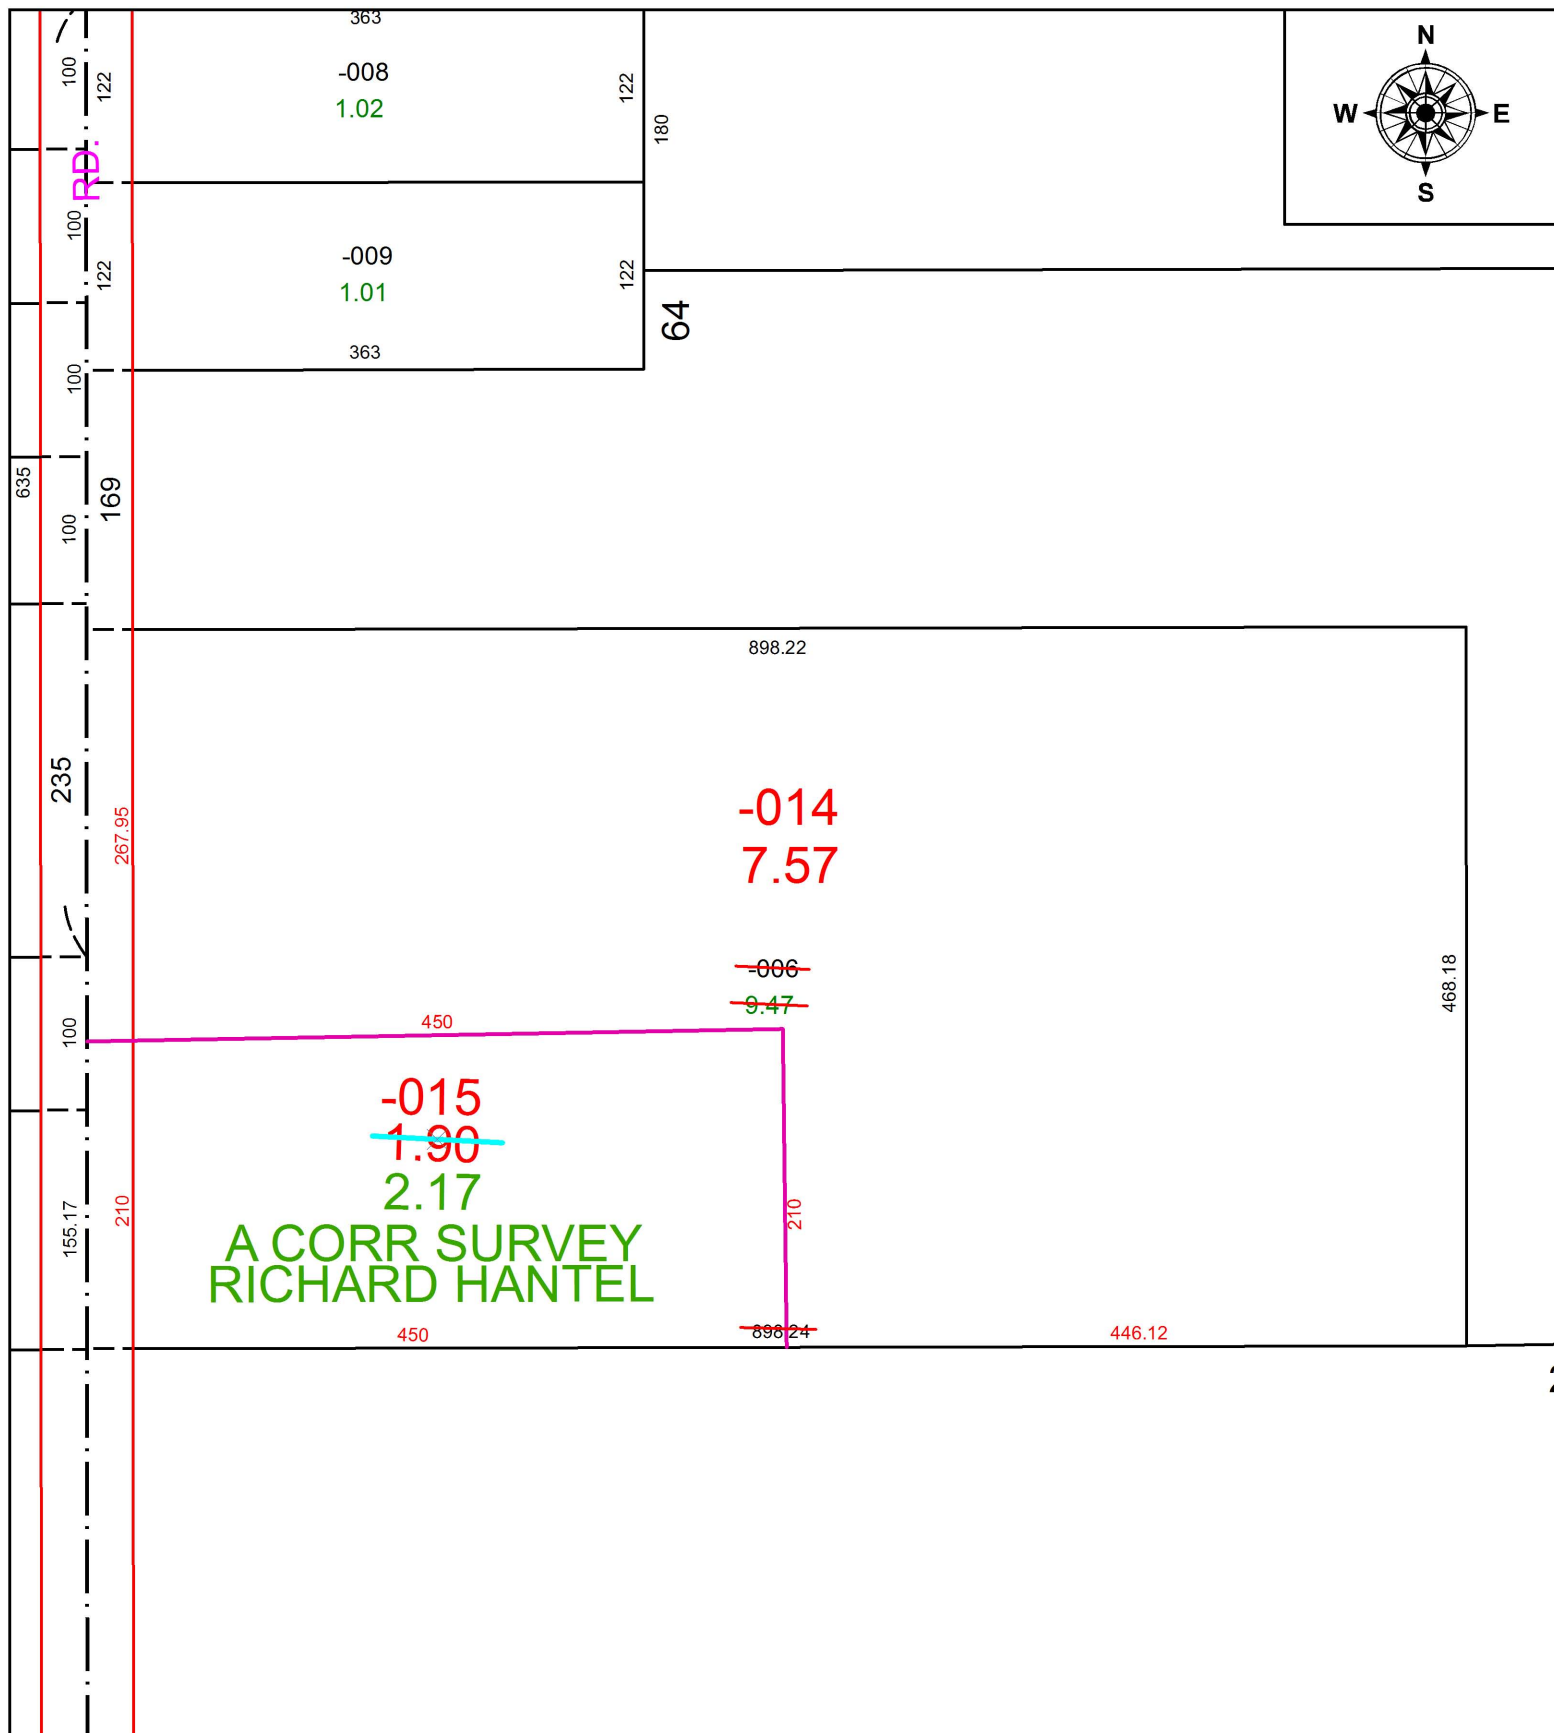

-015
~~1.90~~
 2.17
A CORR SURVEY
RICHARD HANTEL

-014
7.57

~~-006~~
~~9.47~~

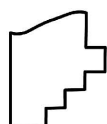

SPLITS/DEEDS PROCESSED
 LORAIN COUNTY TAX MAP DEPARTMENT
 226 MIDDLE AVE. ELYRIA, OH

SURVEYED BY: RICHARD HANTEL
 CLOSURE: 1:-2147483648
 MAP PAGE(S): 15-00-042
 APPROVED BY: JAH DATE: 08-12-2016
 SCALE: 1 in = 125 ft PRIOR INSTRUMENT: OR 793/490