


PARENT PARCEL: 13-11-021-000-011

CHILD PARCEL: XX-XX-XXX-XXX-XXX

STARTING POINT: INTERSECTION OF C/L OF S.R.20 AND C/L OF GORE ORPHANAGE RD.

16-03554-A

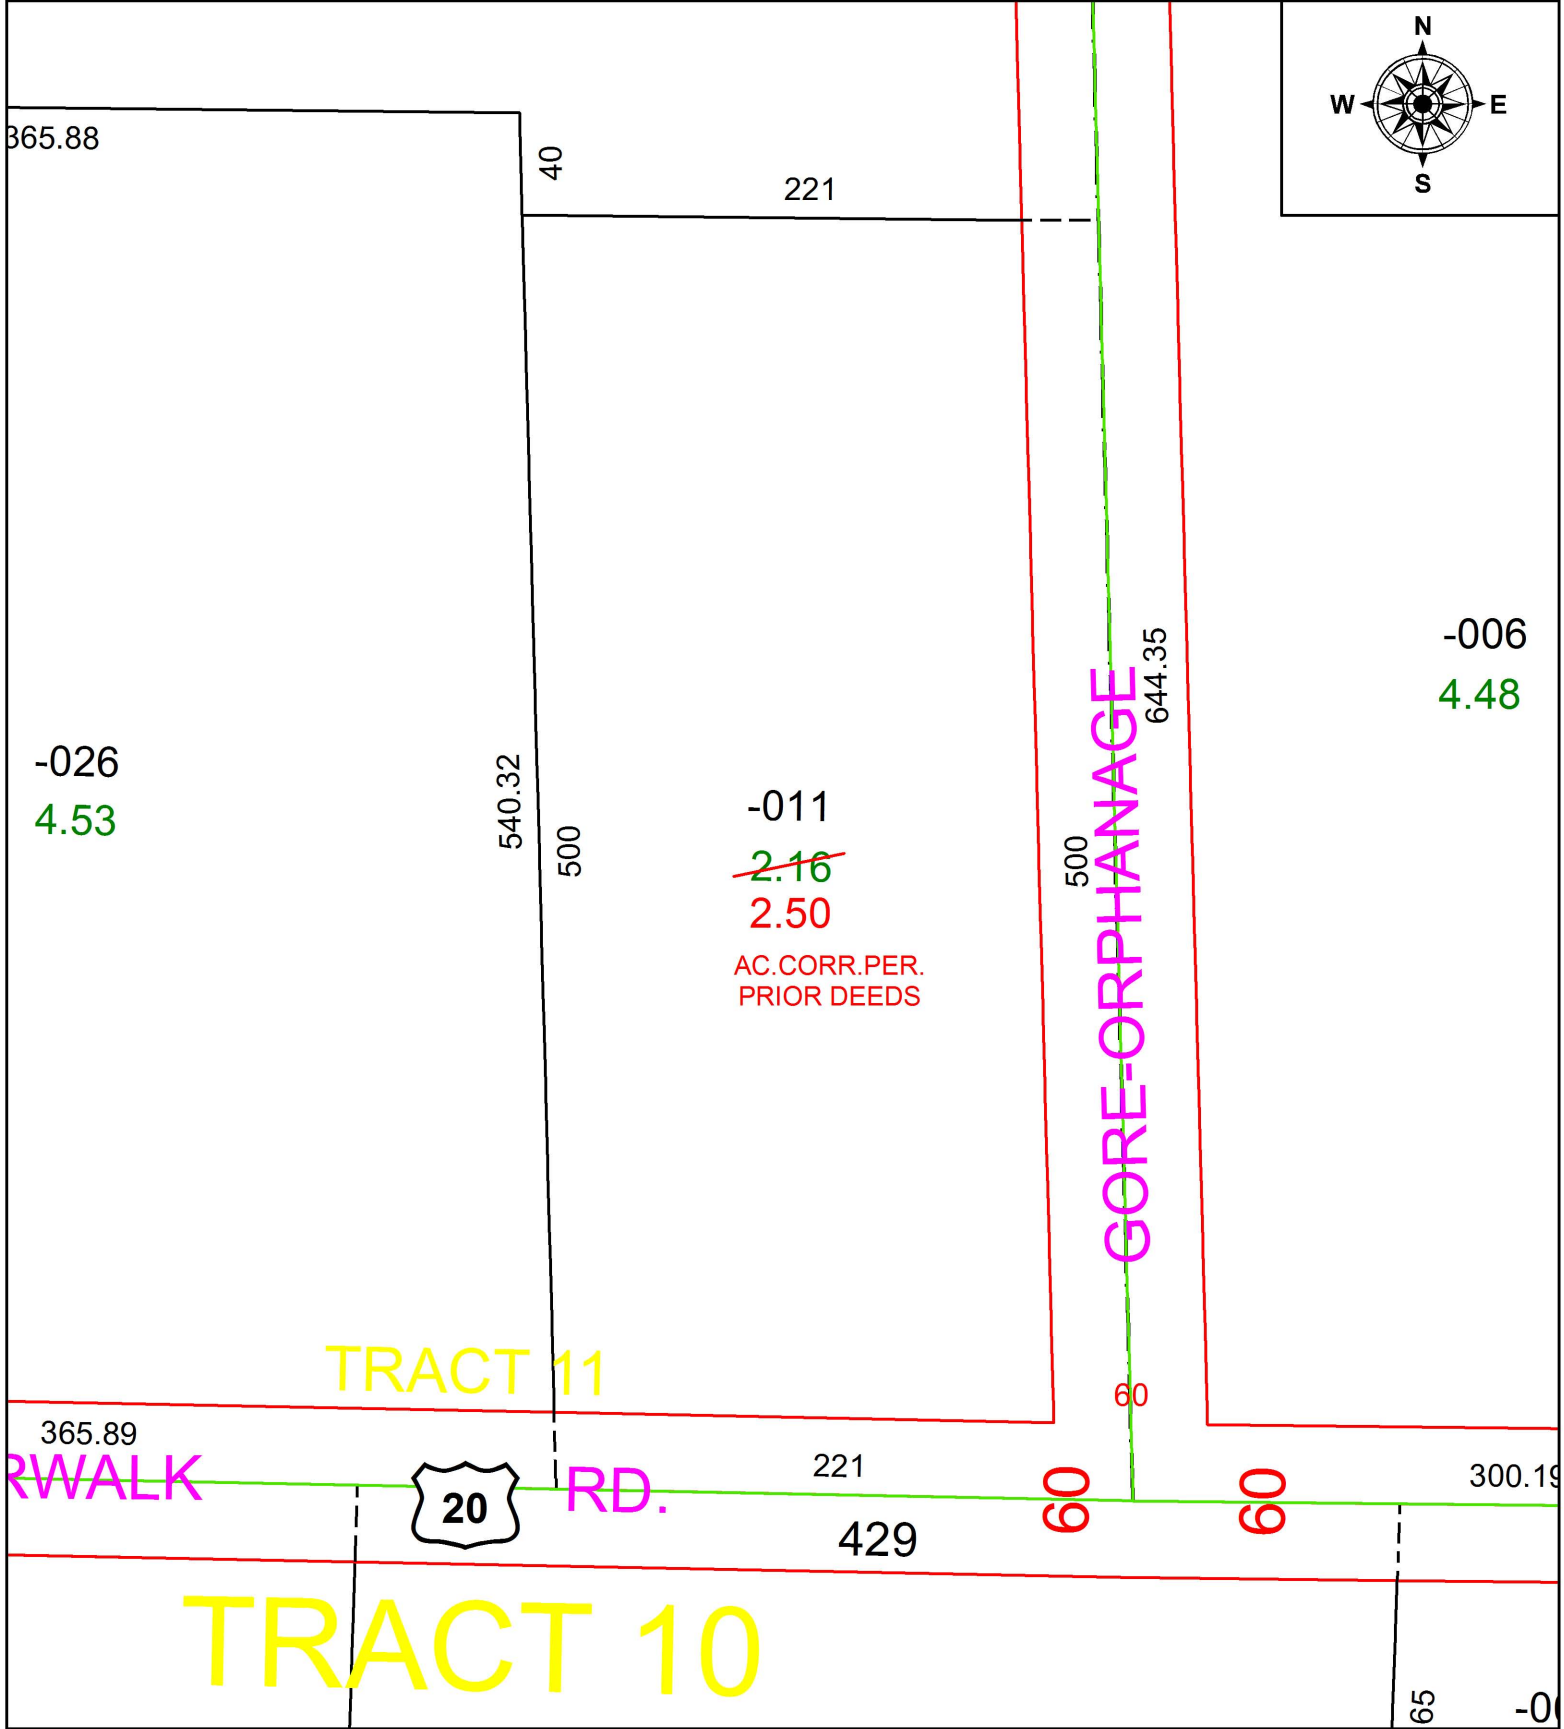

TRACT 11


TRACT 10

GORE-ORPHANAGE



RWALK

RD.

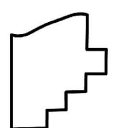

SPLITS/DEEDS PROCESSED
LORAIN COUNTY TAX MAP DEPARTMENT
226 MIDDLE AVE. ELYRIA, OH

SURVEYED BY: _____ N/A
CLOSURE: _____ N/A
MAP PAGE(S): _____ 13-A
APPROVED BY: _____ RRM DATE: _____ 11-10-16
SCALE: _____ 1" = 75' PRIOR INSTRUMENT: _____ 20160597404