
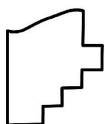


PARENT PARCEL: 07-00-004-108-112

CHILD PARCEL: 15-00-042-000-014, -01507-00-004-108-116, -117

STARTING POINT: CENTERLINE OF LEAR NAGEL RD & CHESTNUT RIDGE RD

16-03554

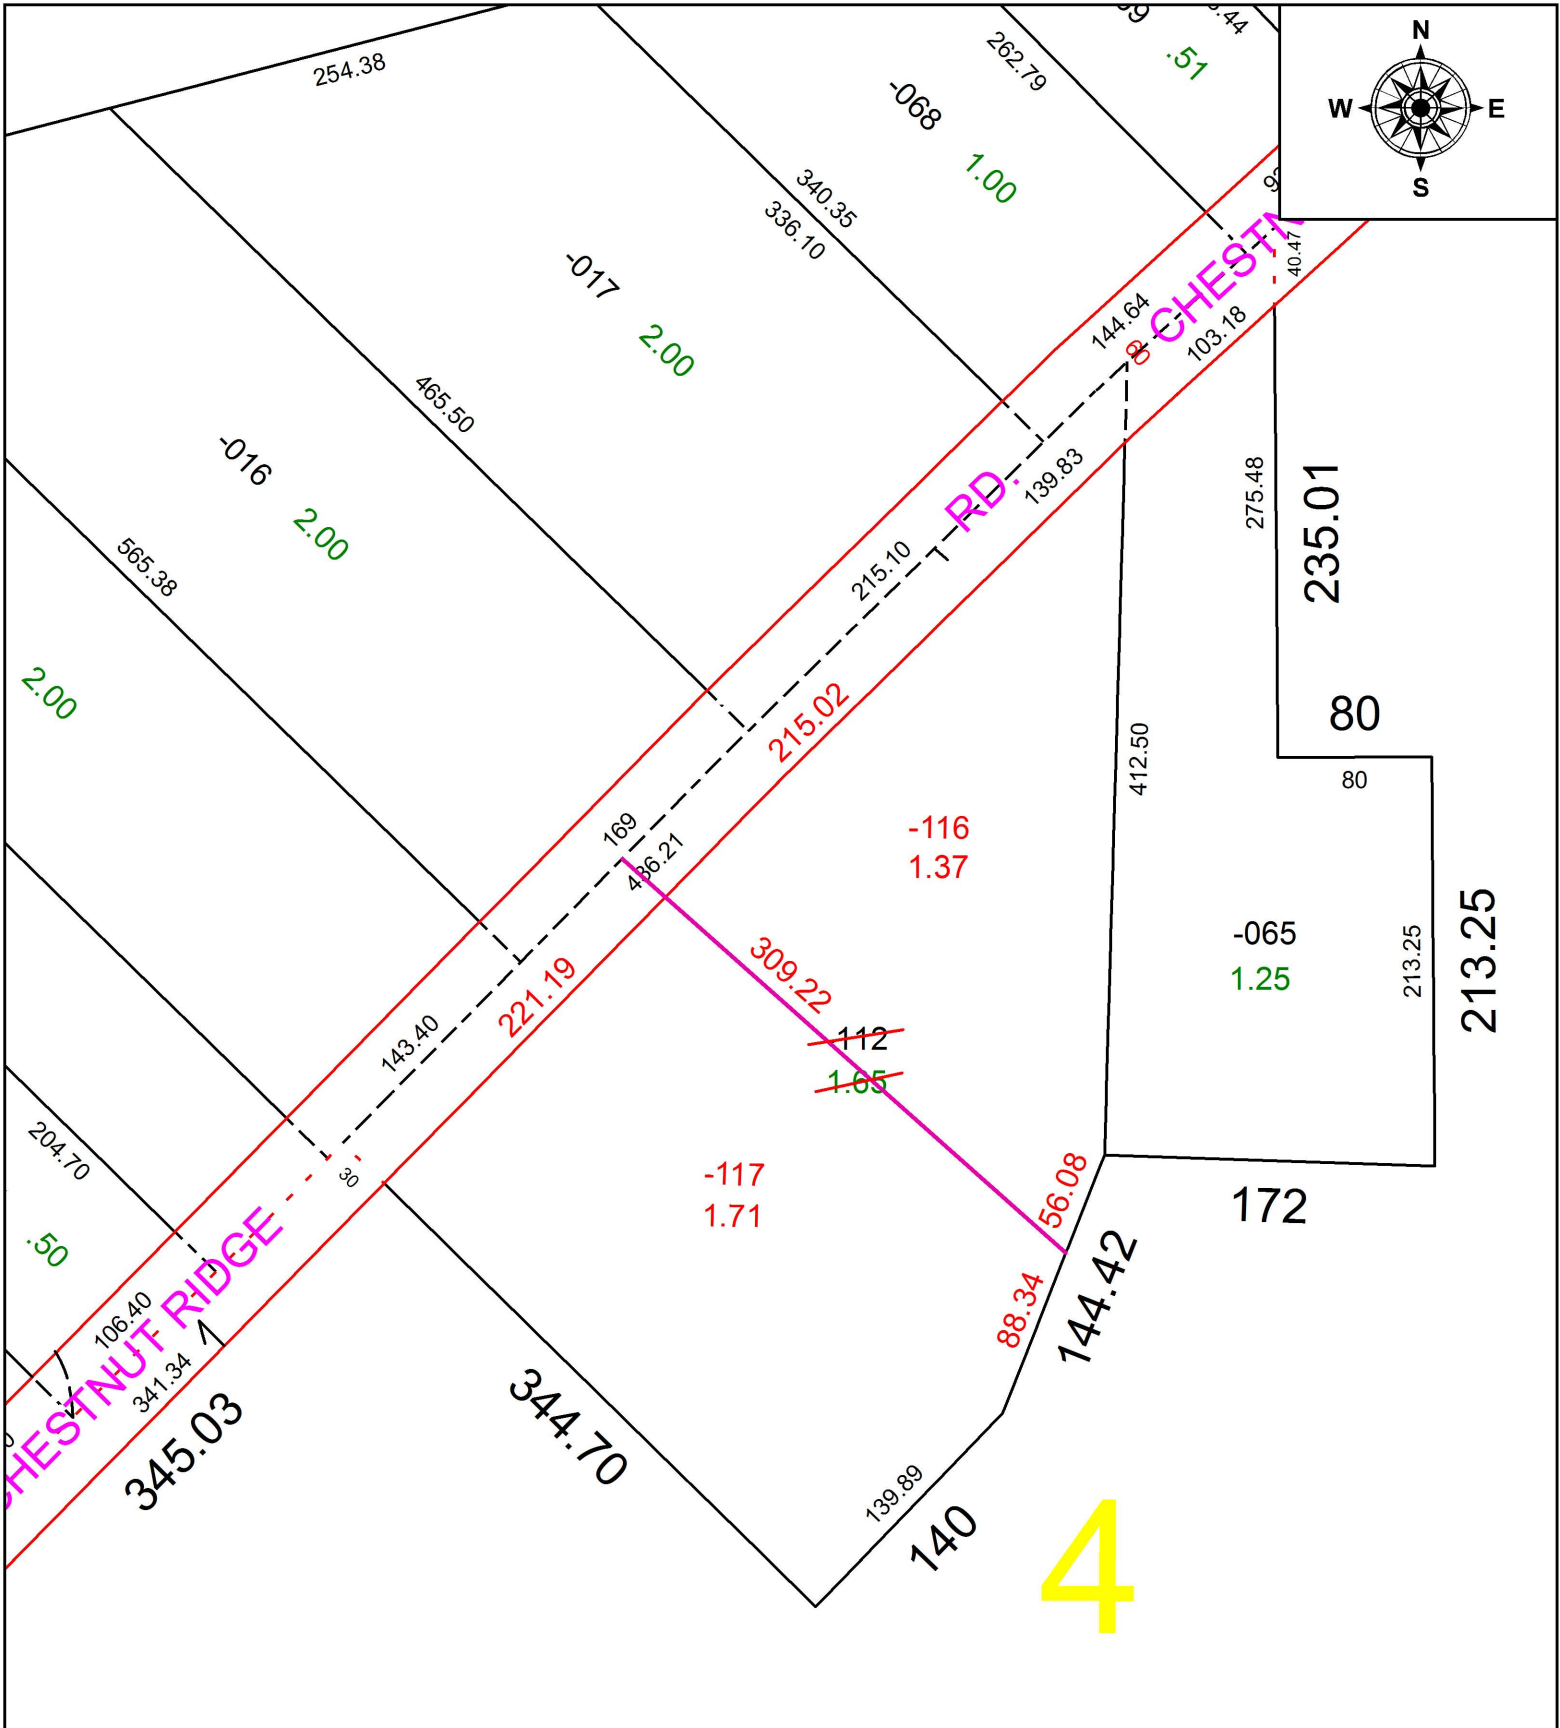

SPLITS/DEEDS PROCESSED
 LORAIN COUNTY TAX MAP DEPARTMENT
 226 MIDDLE AVE. ELYRIA, OH

SURVEYED BY: THOMAS SIMON
 CLOSURE: 1:-2147483648
 MAP PAGE(S): 07-00-004
 APPROVED BY: JAH DATE: 08-12-2016
 SCALE: 1 in = 100 ft PRIOR INSTRUMENT: 20150562471