


PARENT PARCEL: 04-00-011-107-222, -103

CHILD PARCEL: 04-00-011-107-242, -243, -244

STARTING POINT: CENTERLINE OF DETROIT RD & LONG RD

16-03555

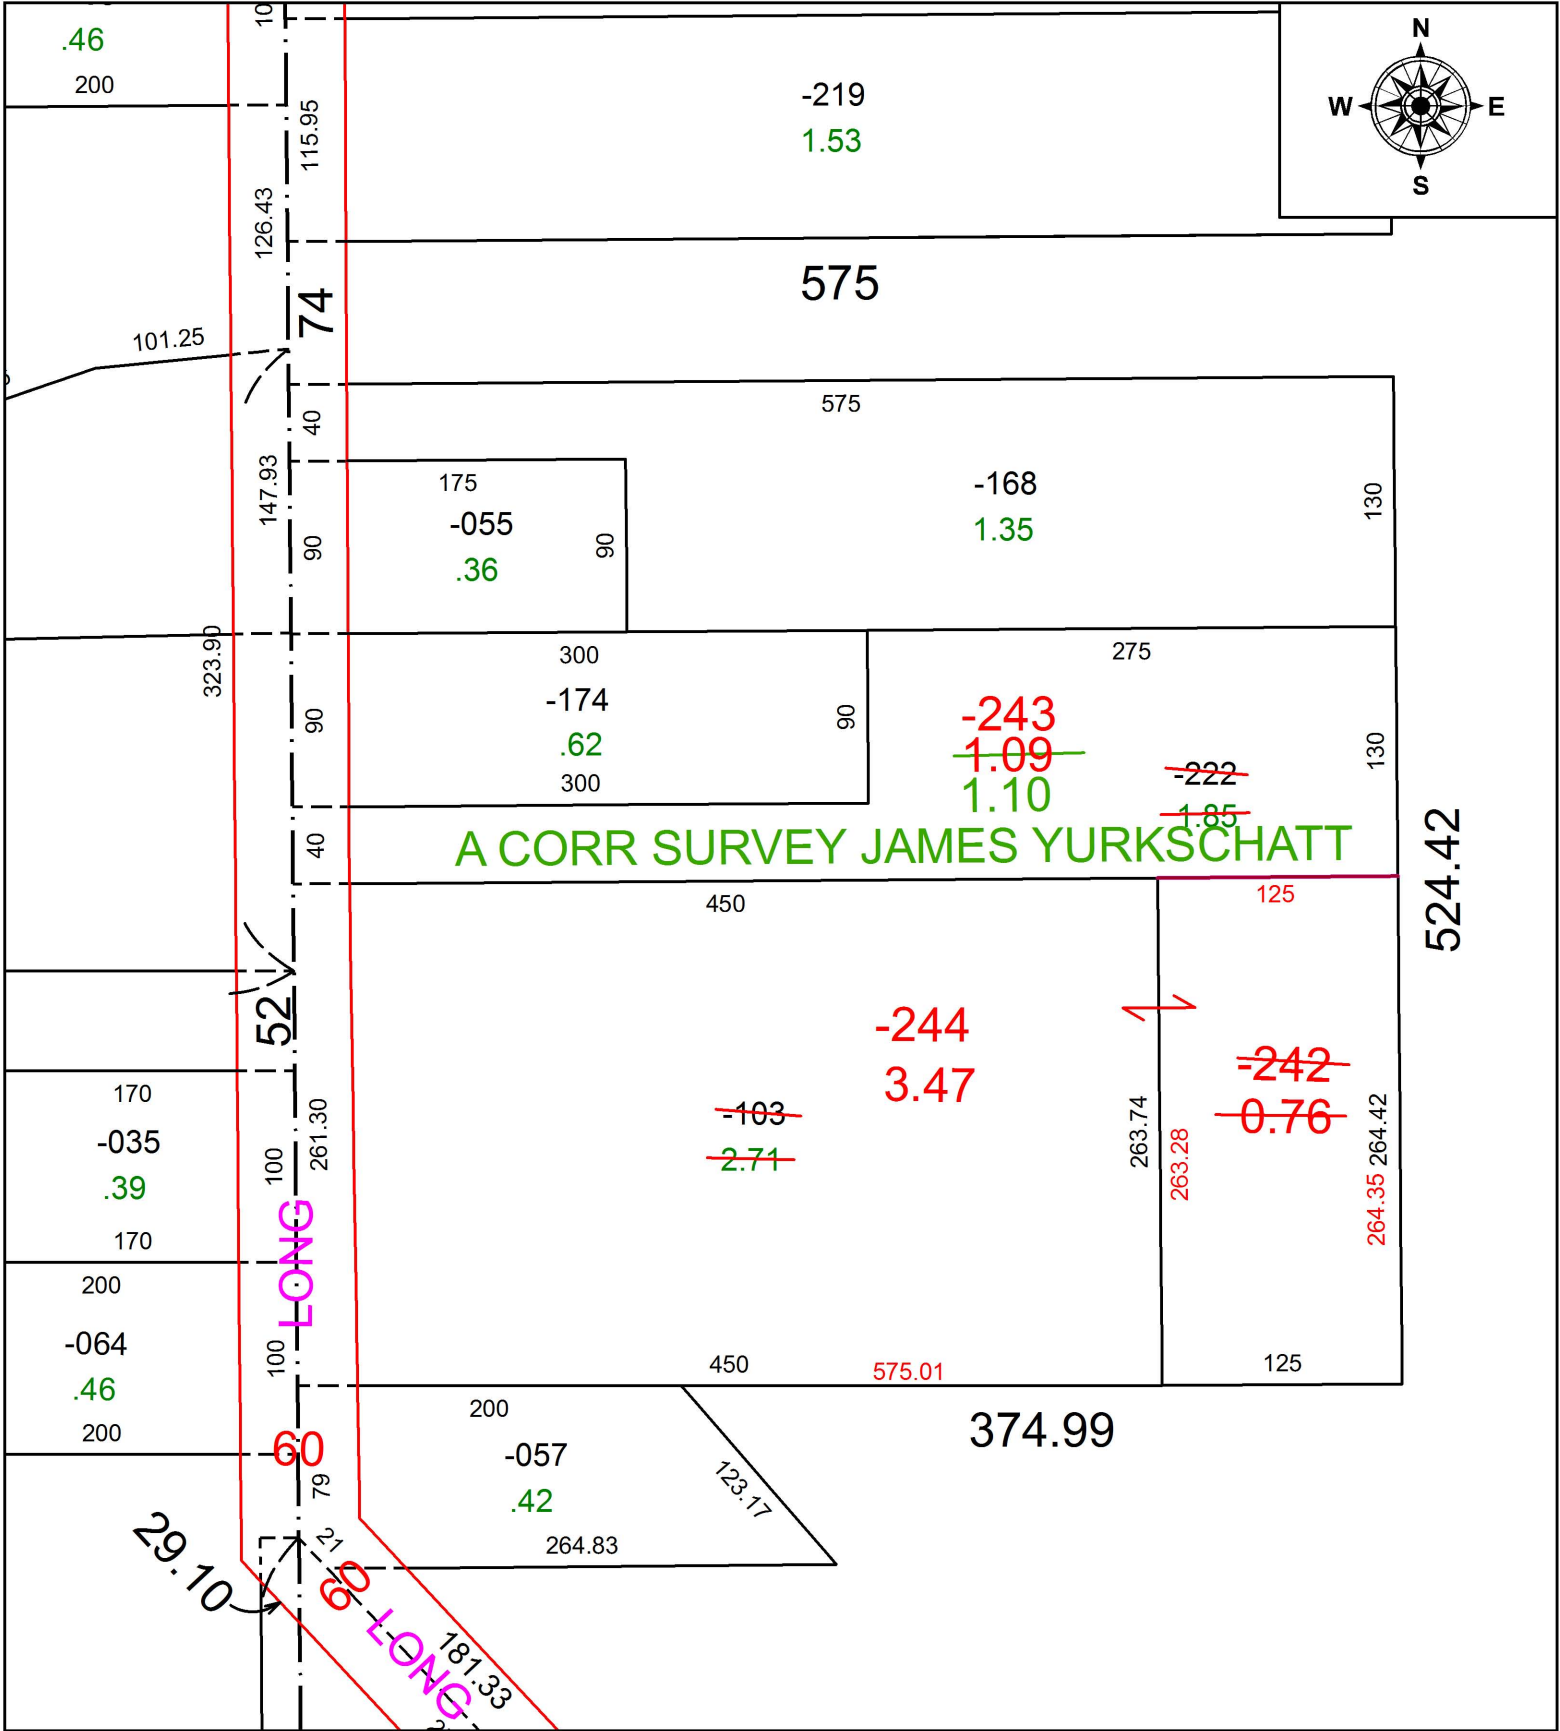


A CORR SURVEY JAMES YURKSCHATT

LONG

60

LONG

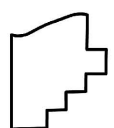

**SPLITS/DEEDS PROCESSED**  
 LORAIN COUNTY TAX MAP DEPARTMENT  
 226 MIDDLE AVE. ELYRIA, OH

SURVEYED BY: JAMES YURKSCHATT  
 CLOSURE: 1:-2147483648  
 MAP PAGE(S): 04-00-011  
 APPROVED BY: JAH DATE: 8/23/2016  
 SCALE: 1 in = 100 ft PRIOR INSTRUMENT: 20090295108