


PARENT PARCEL: 09-00-024-000-006

CHILD PARCEL: 09-00-024-000-027, -028

STARTING POINT: NORTHEAST CORNER OF O.L.24

16-03556

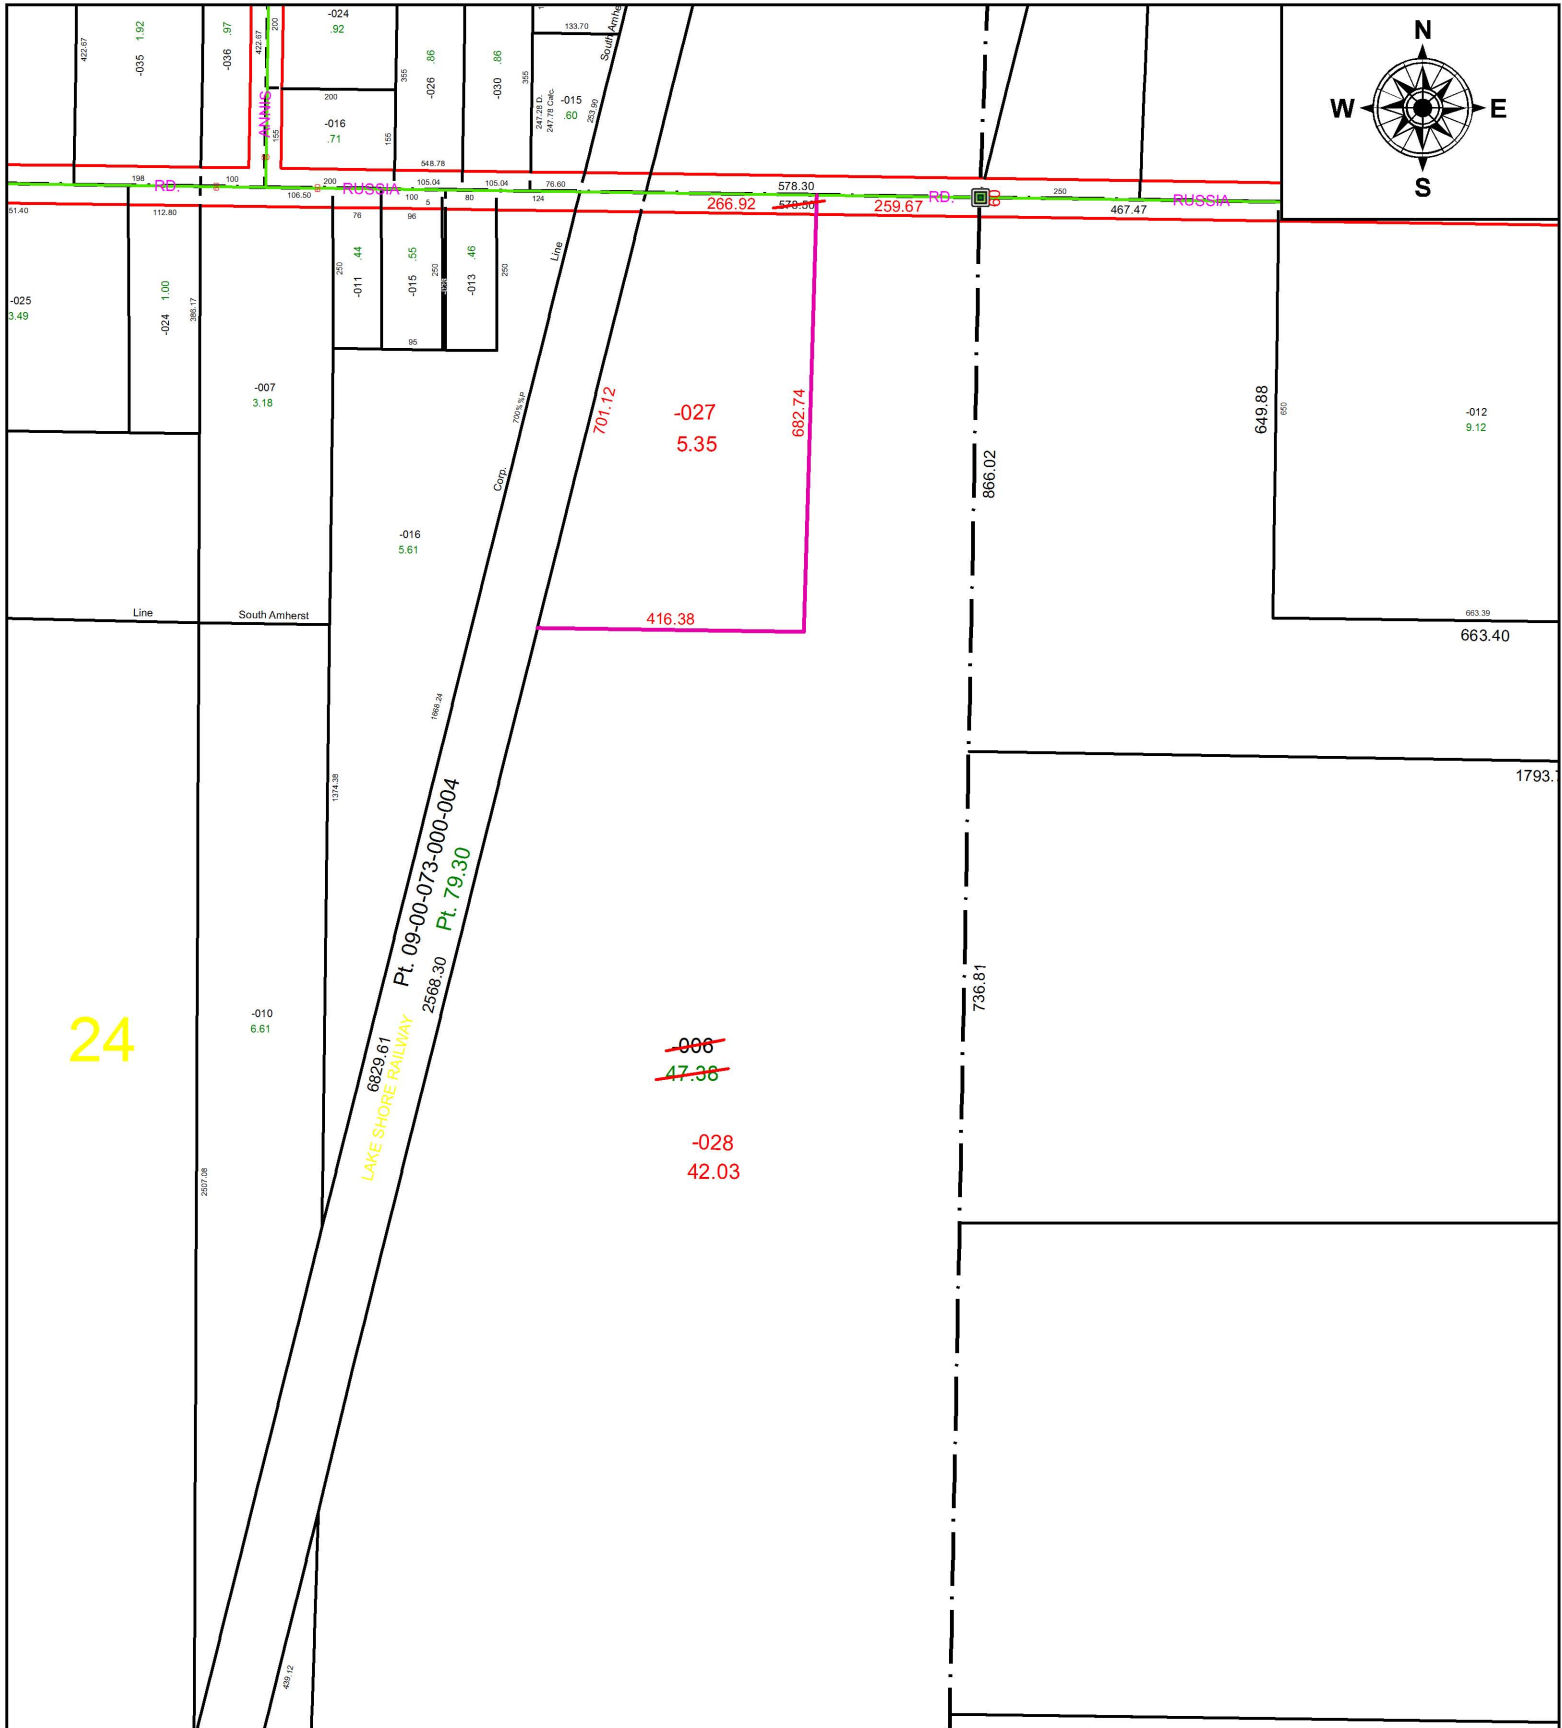

SPLITS/DEEDS PROCESSED
 LORAIN COUNTY TAX MAP DEPARTMENT
 226 MIDDLE AVE. ELYRIA, OH

SURVEYED BY: TIMOTHY D. HOZALSKI

CLOSURE: 1: 640,979

MAP PAGE(S): 9-00-024

APPROVED BY: RRM DATE: 8-18-16

SCALE: 1" = 300 PRIOR INSTRUMENT: 20160585800