
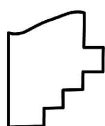


PARENT PARCEL: 07-00-037-000-004, -535

CHILD PARCEL: 07-00-037-000-930

STARTING POINT: NORTHWEST CORNER O.L. 37 AND CENTERLINE BENDER RD

16-03559

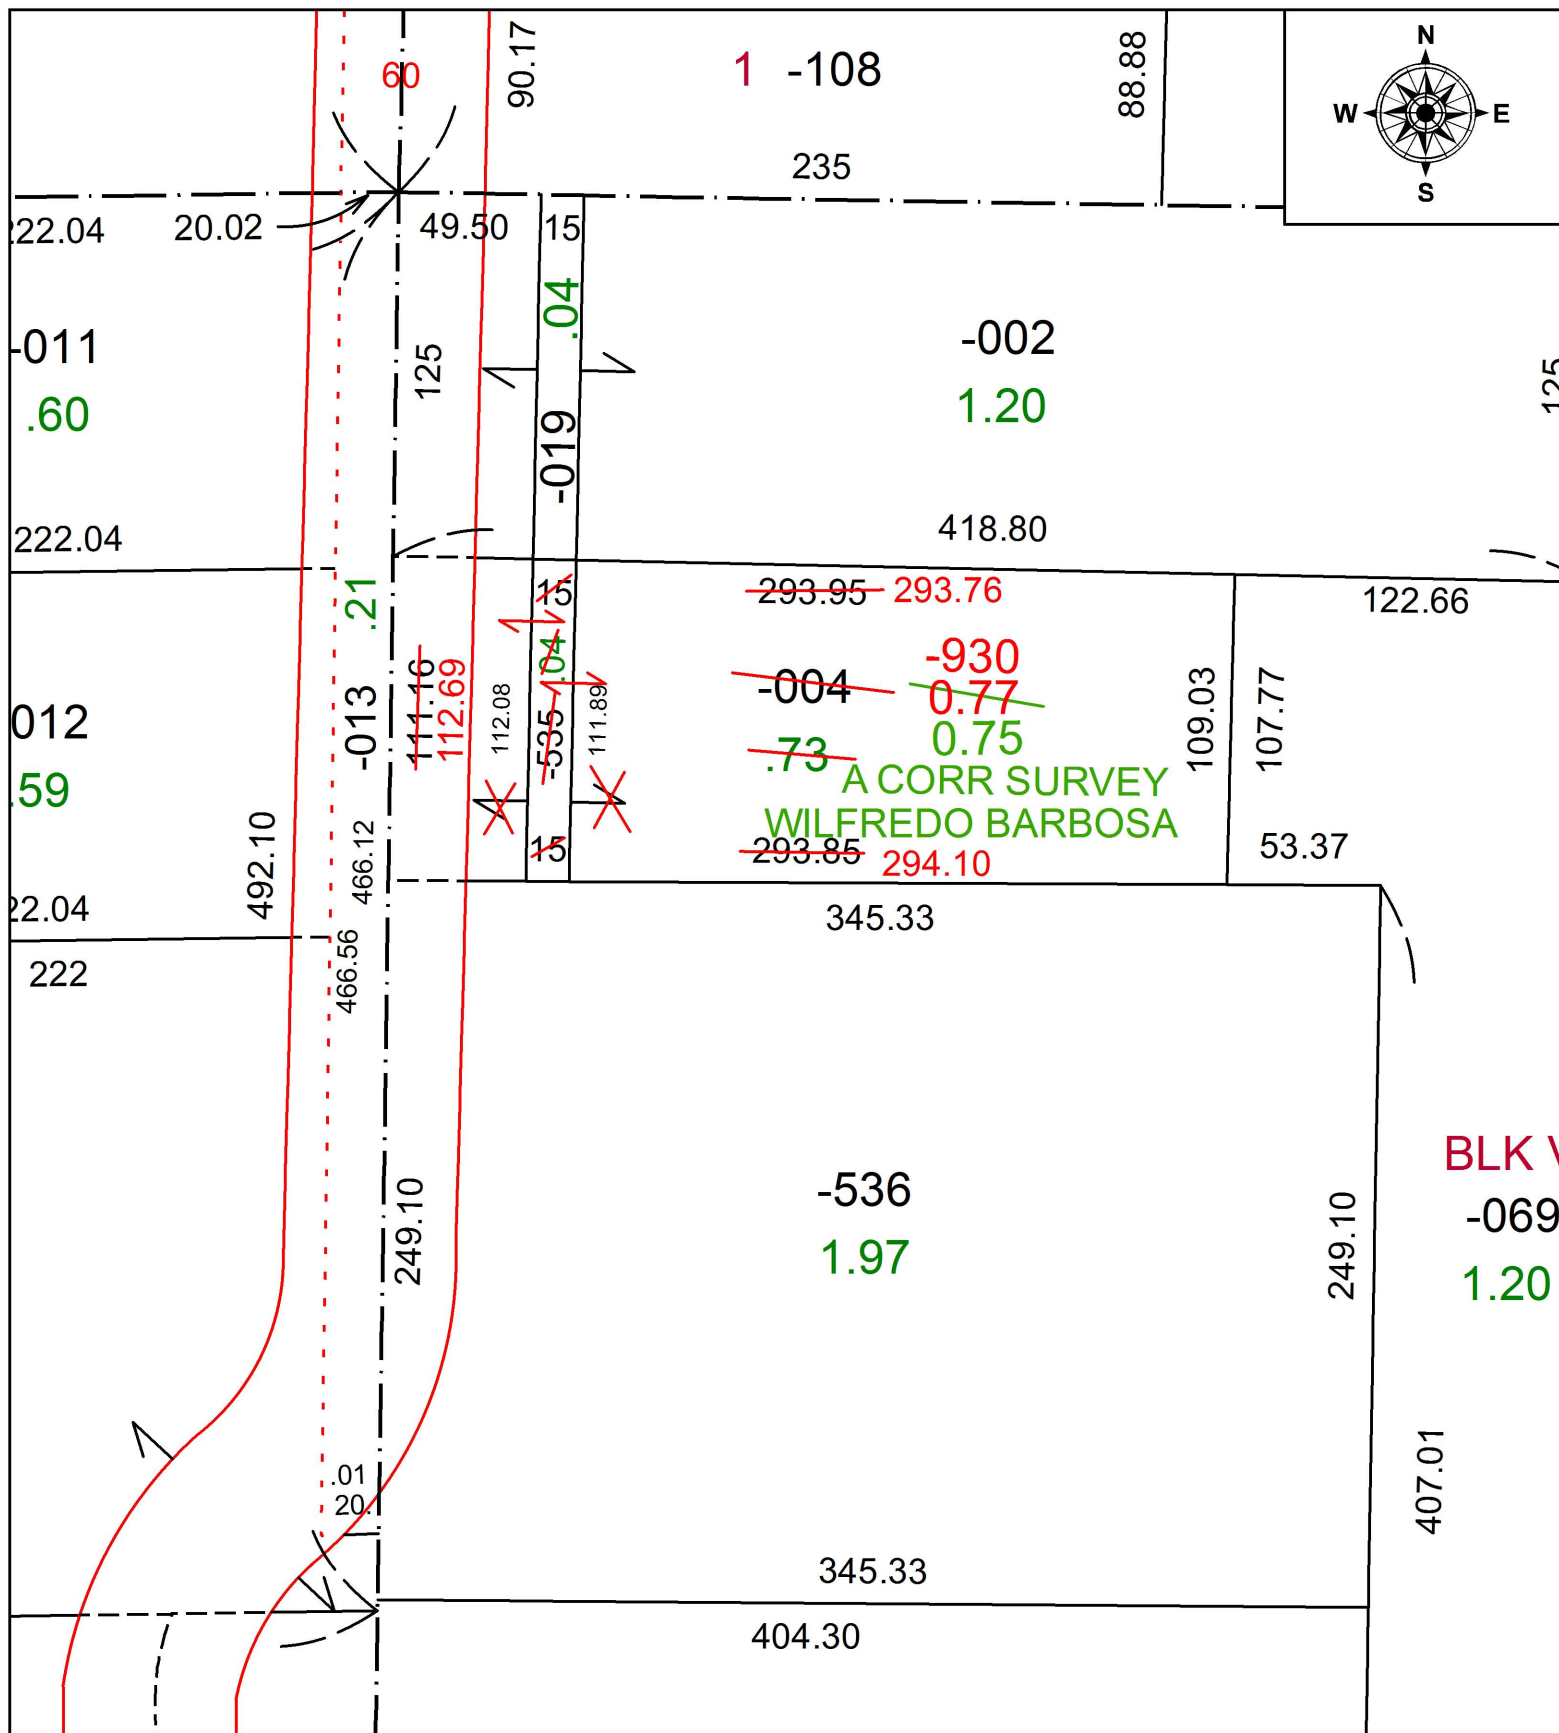

SPLITS/DEEDS PROCESSED
 LORAIN COUNTY TAX MAP DEPARTMENT
 226 MIDDLE AVE. ELYRIA, OH

SURVEYED BY: WILFREDO BARBOSA
 CLOSURE: 1:-2147483648
 MAP PAGE(S): 07-00-037
 APPROVED BY: JAH DATE: 8/23/2016
 SCALE: 1 in = 67 ft PRIOR INSTRUMENT: 20160597169