
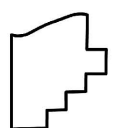


PARENT PARCEL: 05-00-016-101-005

CHILD PARCEL: 05-00-016-101-185, -186, 05-00-005-106-043

STARTING POINT: NORTHWEST CORNER OF S/L 28 IN KEMPTON WOODS ESTATES SUB. NO.2

16-03563

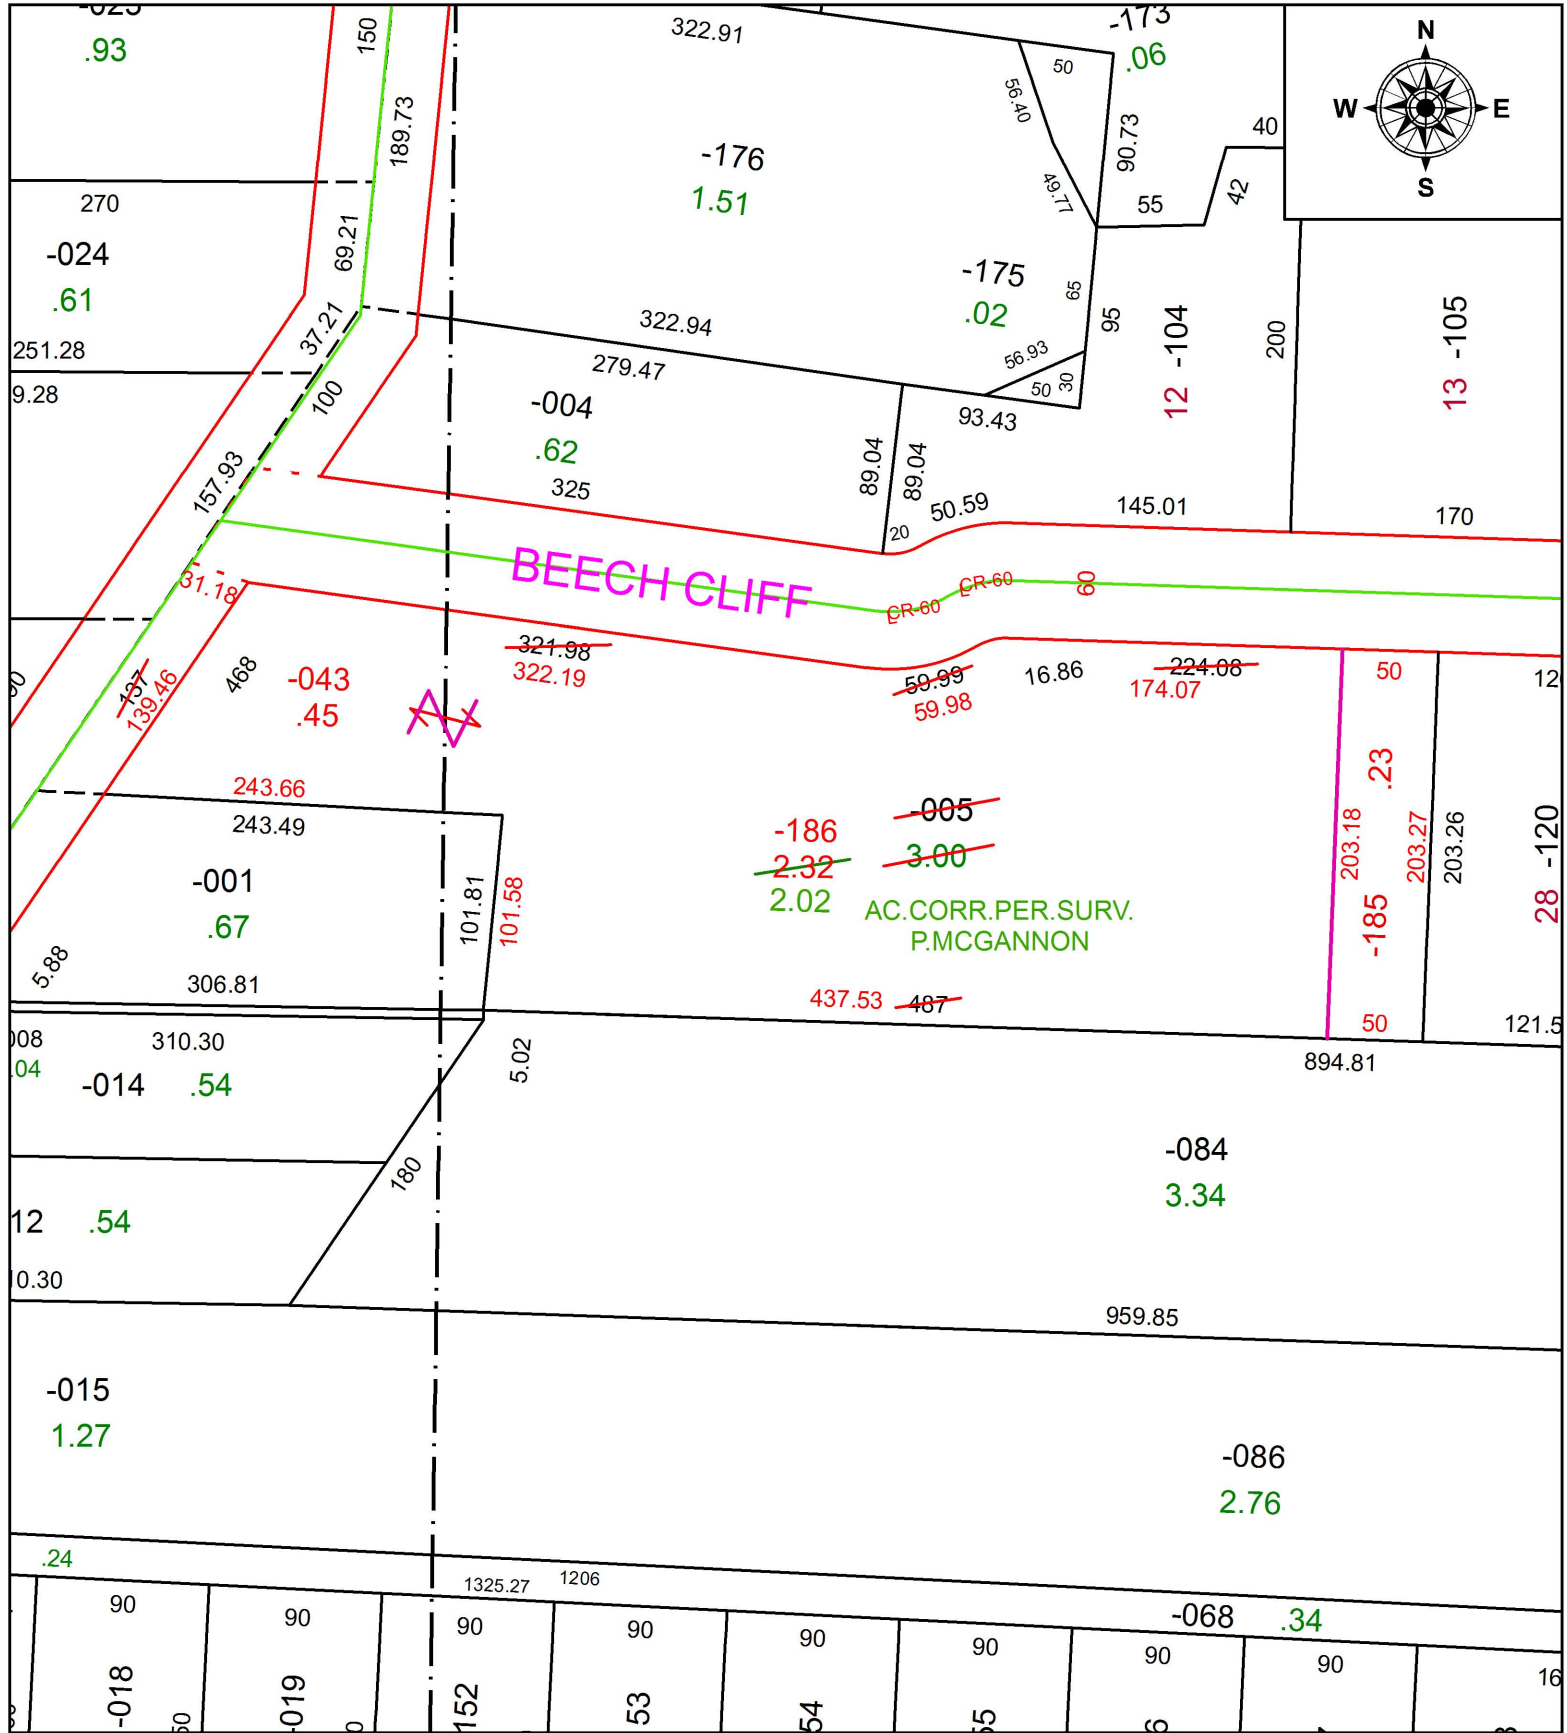

SPLITS/DEEDS PROCESSED
 LORAIN COUNTY TAX MAP DEPARTMENT
 226 MIDDLE AVE. ELYRIA, OH

SURVEYED BY: PATRICK A. MCGANNON
CLOSURE: 1: 244,396
MAP PAGE(S): 5-00-016
APPROVED BY: RRM **DATE:** 8-30-16
SCALE: 1" = 100 **PRIOR INSTRUMENT:** OR VOL. 1358/730