


PARENT PARCEL: 07-00-003-102-048 & -049



CHILD PARCEL: XX-XX-XXX-XXX-XXX

STARTING POINT: CL OF LORAIN RD. & CL OF COOK RD.

16-03568-X

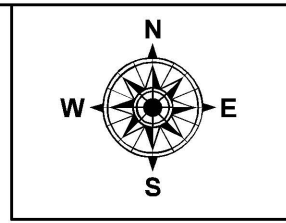

MAP CORR. ONLY

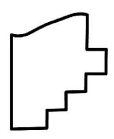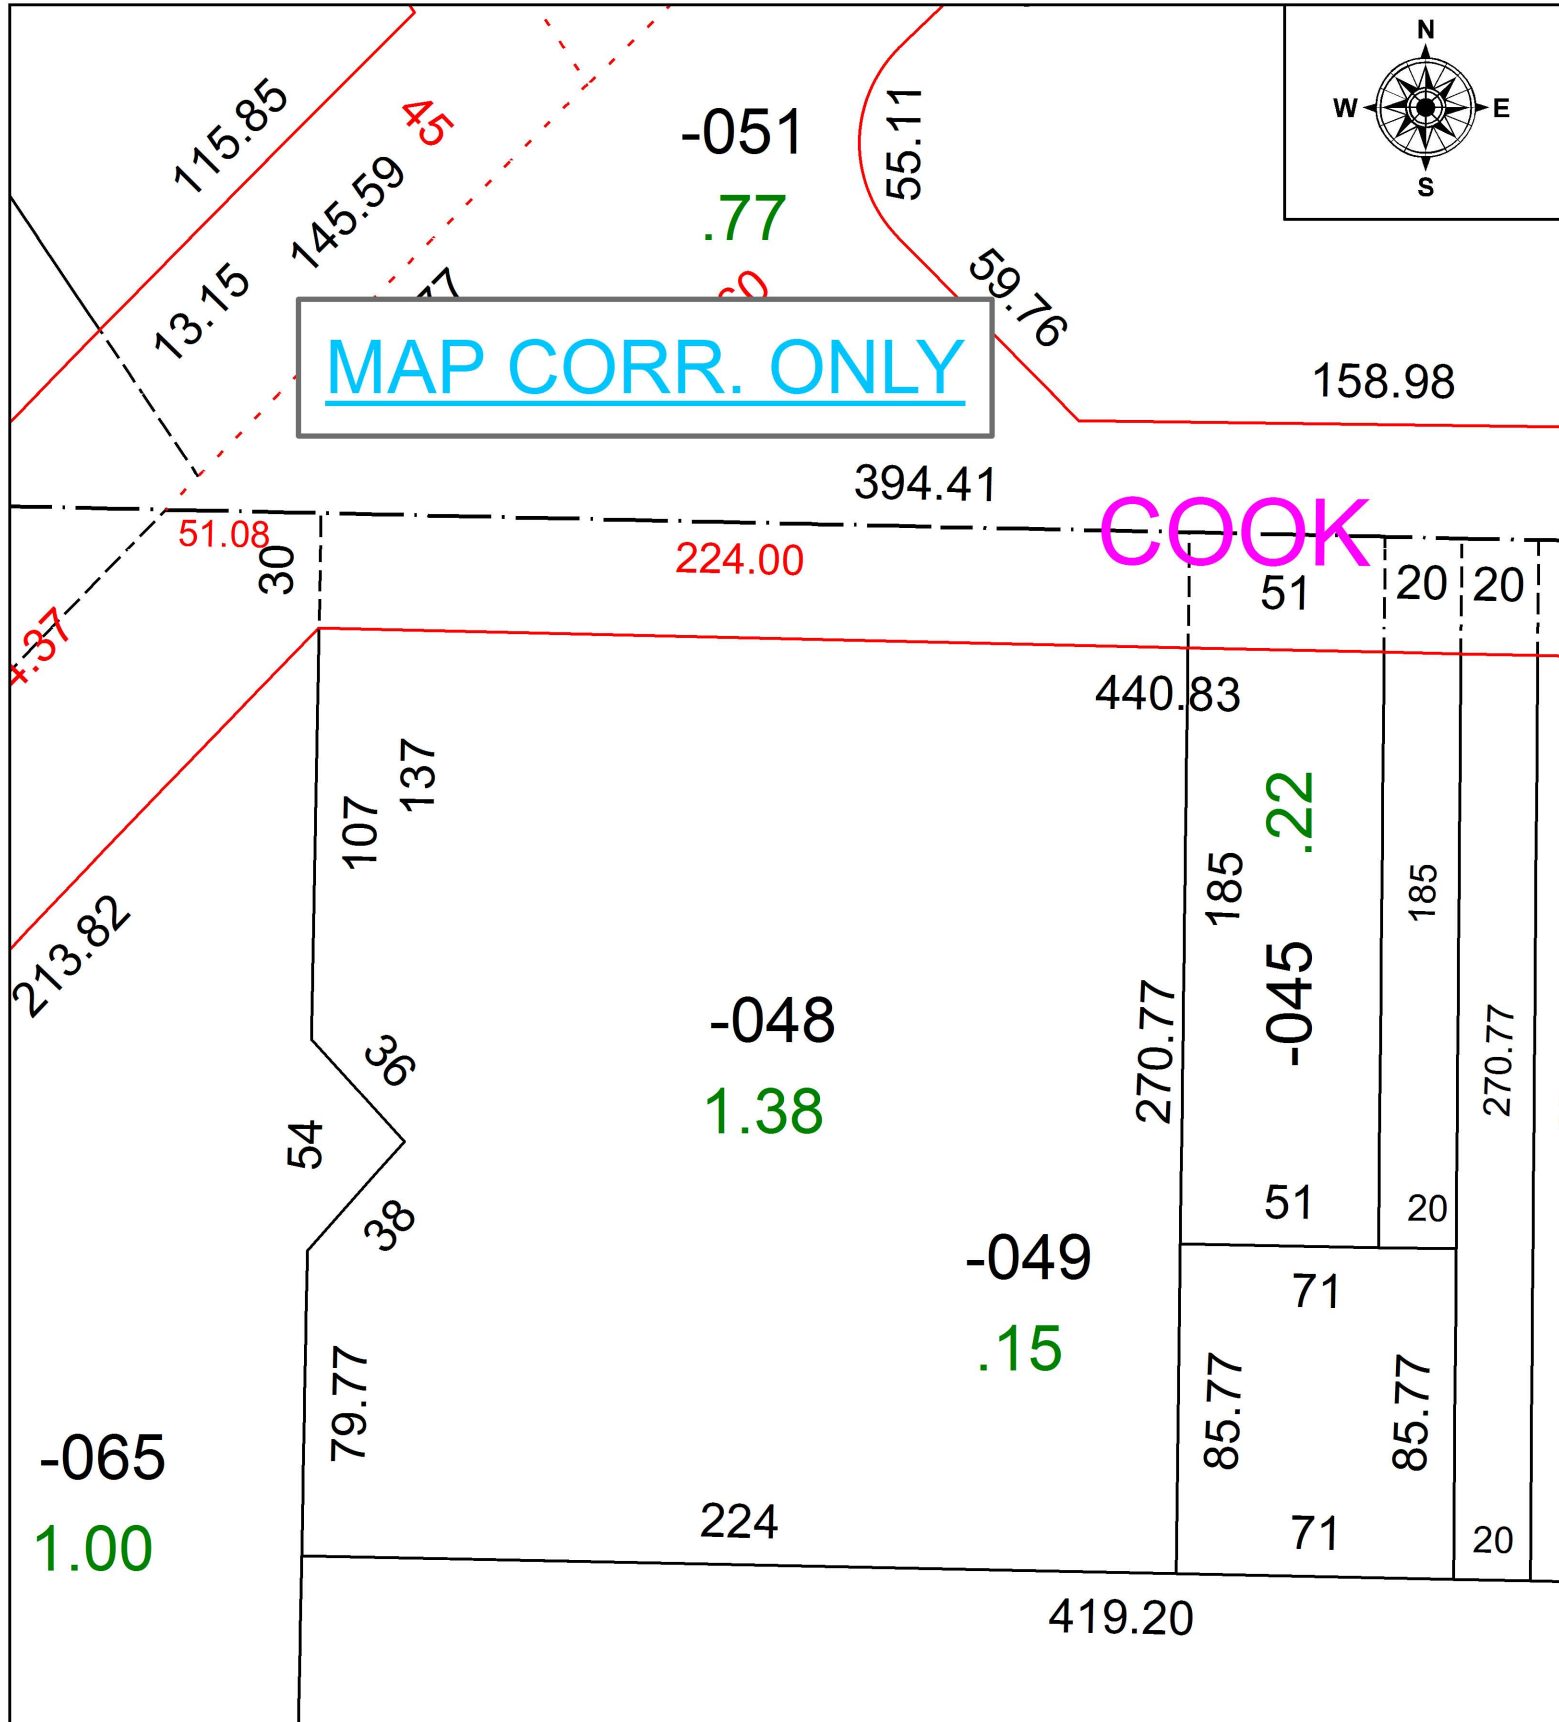

SPLITS/DEEDS PROCESSED
LORAIN COUNTY TAX MAP DEPARTMENT
226 MIDDLE AVE. ELYRIA, OH

SURVEYED BY: RYAN A. SNEZEK
CLOSURE: 1: 33,000
MAP PAGE(S): 07-00-003
APPROVED BY: TJS DATE: 12/15/16
SCALE: 1" = 200 PRIOR INSTRUMENT: OR 549/472