


PARENT PARCEL: 14-00-016-000-032

CHILD PARCEL: 14-00-016-000-033, -034

STARTING POINT: INTERSECTION OF C/L OF S.R. 58 AND SOUTH LINE OF O.L.16

16-03568

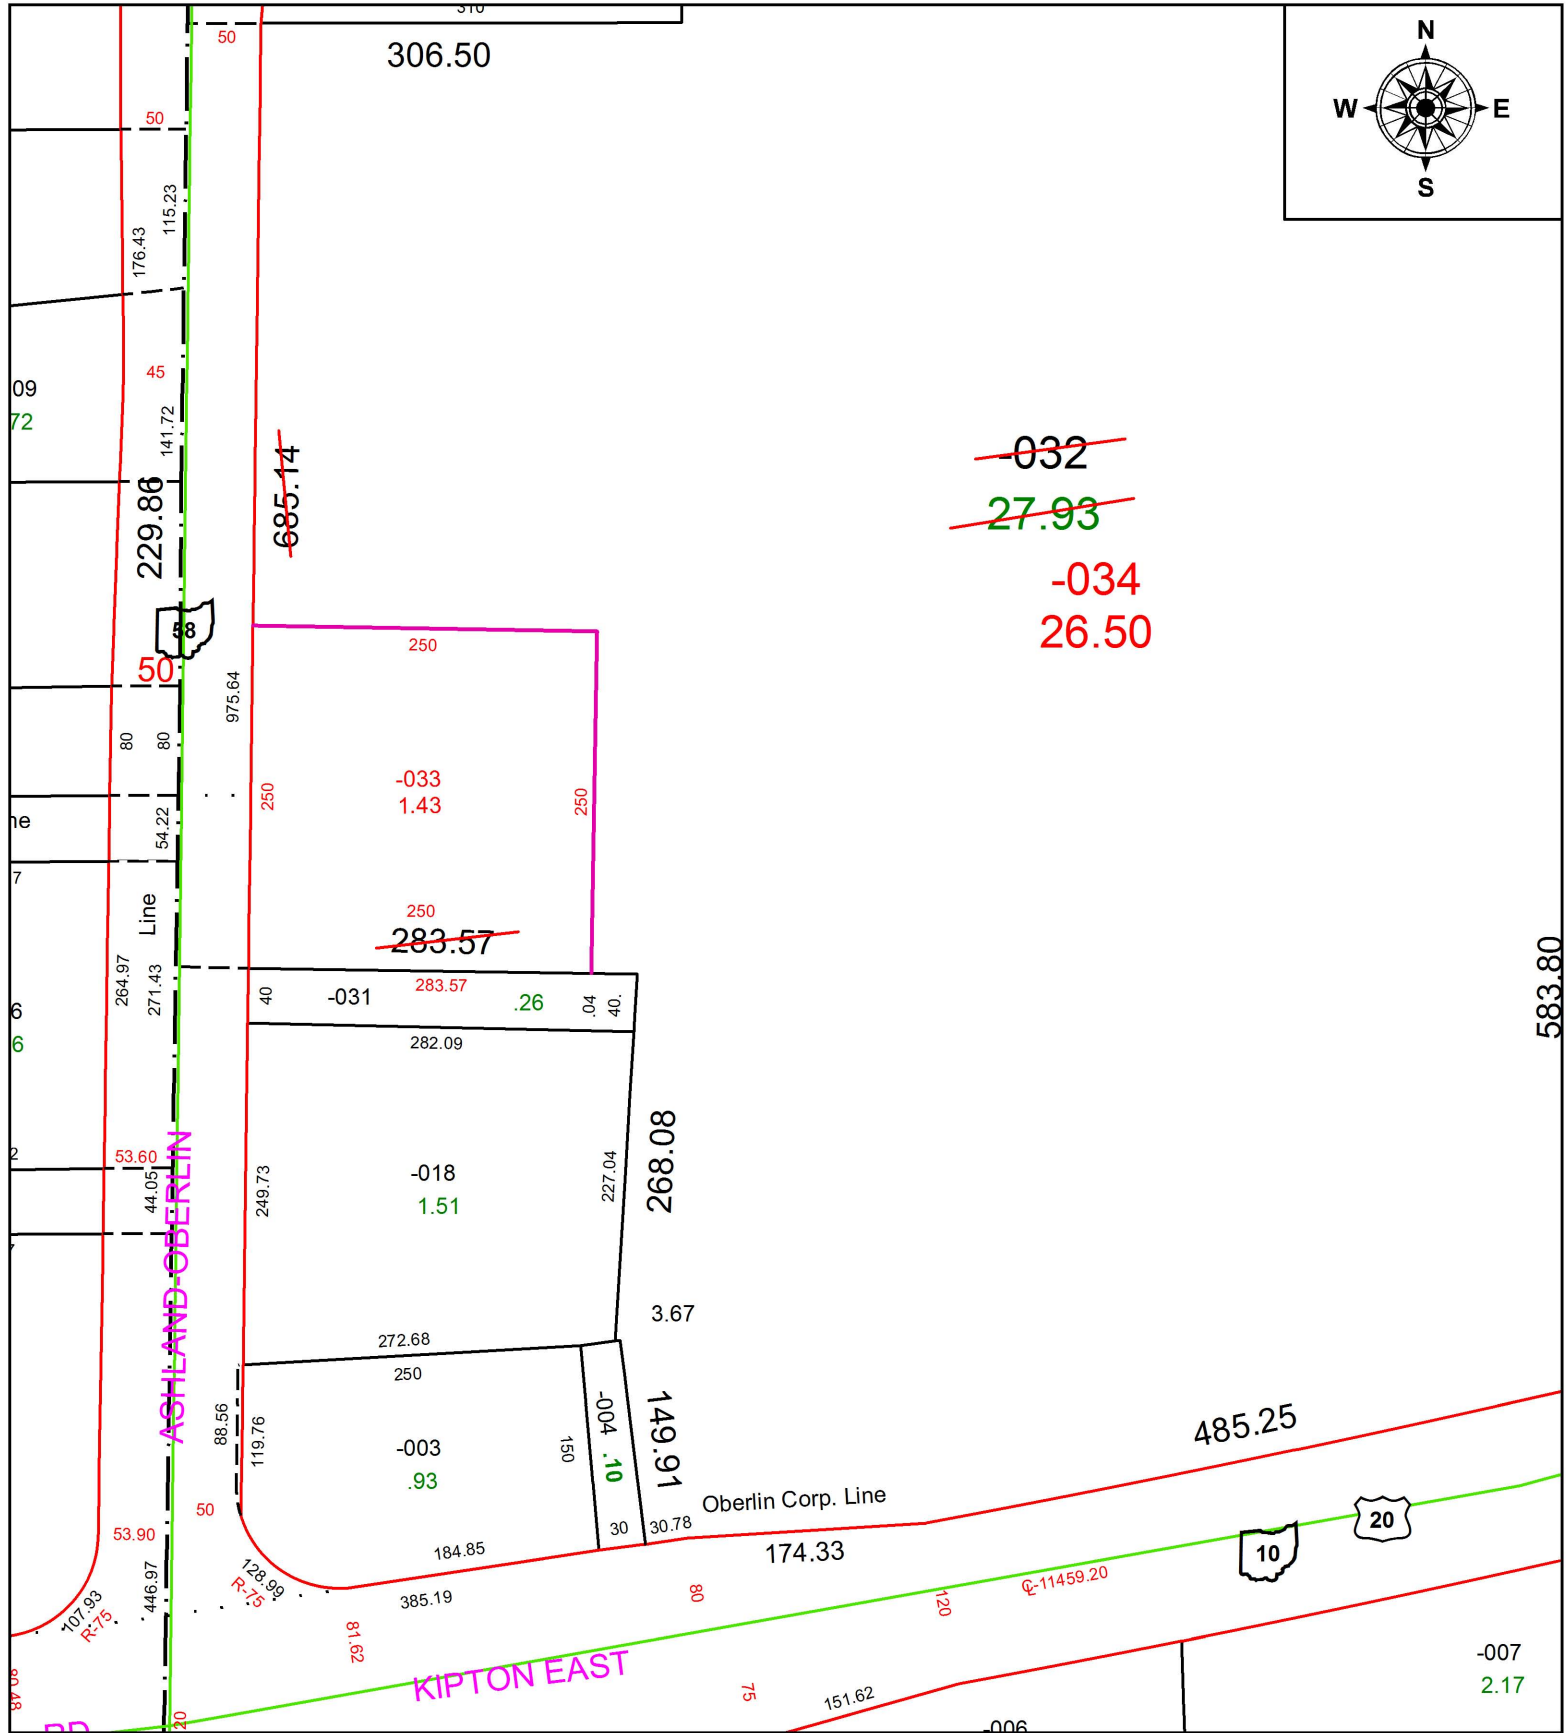


~~-032~~
~~27.93~~
-034
26.50

~~283.57~~

ASHLAND-OBERLIN

KIPTON EAST

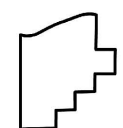

SPLITS/DEEDS PROCESSED
LORAIN COUNTY TAX MAP DEPARTMENT
226 MIDDLE AVE. ELYRIA, OH

SURVEYED BY: BRIAN R. JOHNSON
CLOSURE: 1: 2,489,381,471
MAP PAGE(S): 14-C
APPROVED BY: RRM DATE: 9-19-16
SCALE: 1" = 140 PRIOR INSTRUMENT: 20110370207