




PARENT PARCEL: ADD TO DUPLICATE - 05-00-018-900-003
CHILD PARCEL: 05-00-018-900-004, & 05-00-018-106-094
STARTING POINT: CITY OF AMHERST STREET VACATION - ORD. # 0-15-18, # 0-15-20, & # 0-16-51

16-03570-V

ADD TO DUPLICATE
~~05-00-018-900-003~~
~~1.46 A.~~

STREET VACATION
05-00-018-106-094
0.05 A.
PER ORD. # 0-15-20
CORR. PER ORD. # 0-16-51

REMAINDER
05-00-018-900-004
1.41 A.

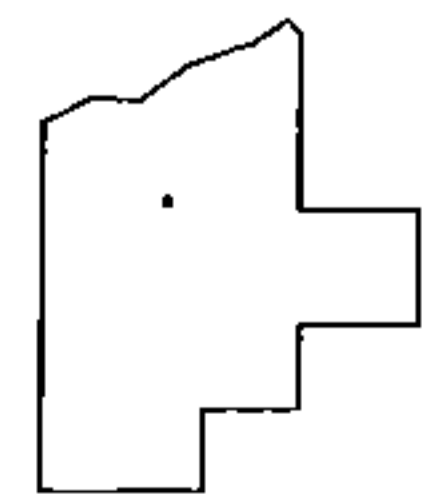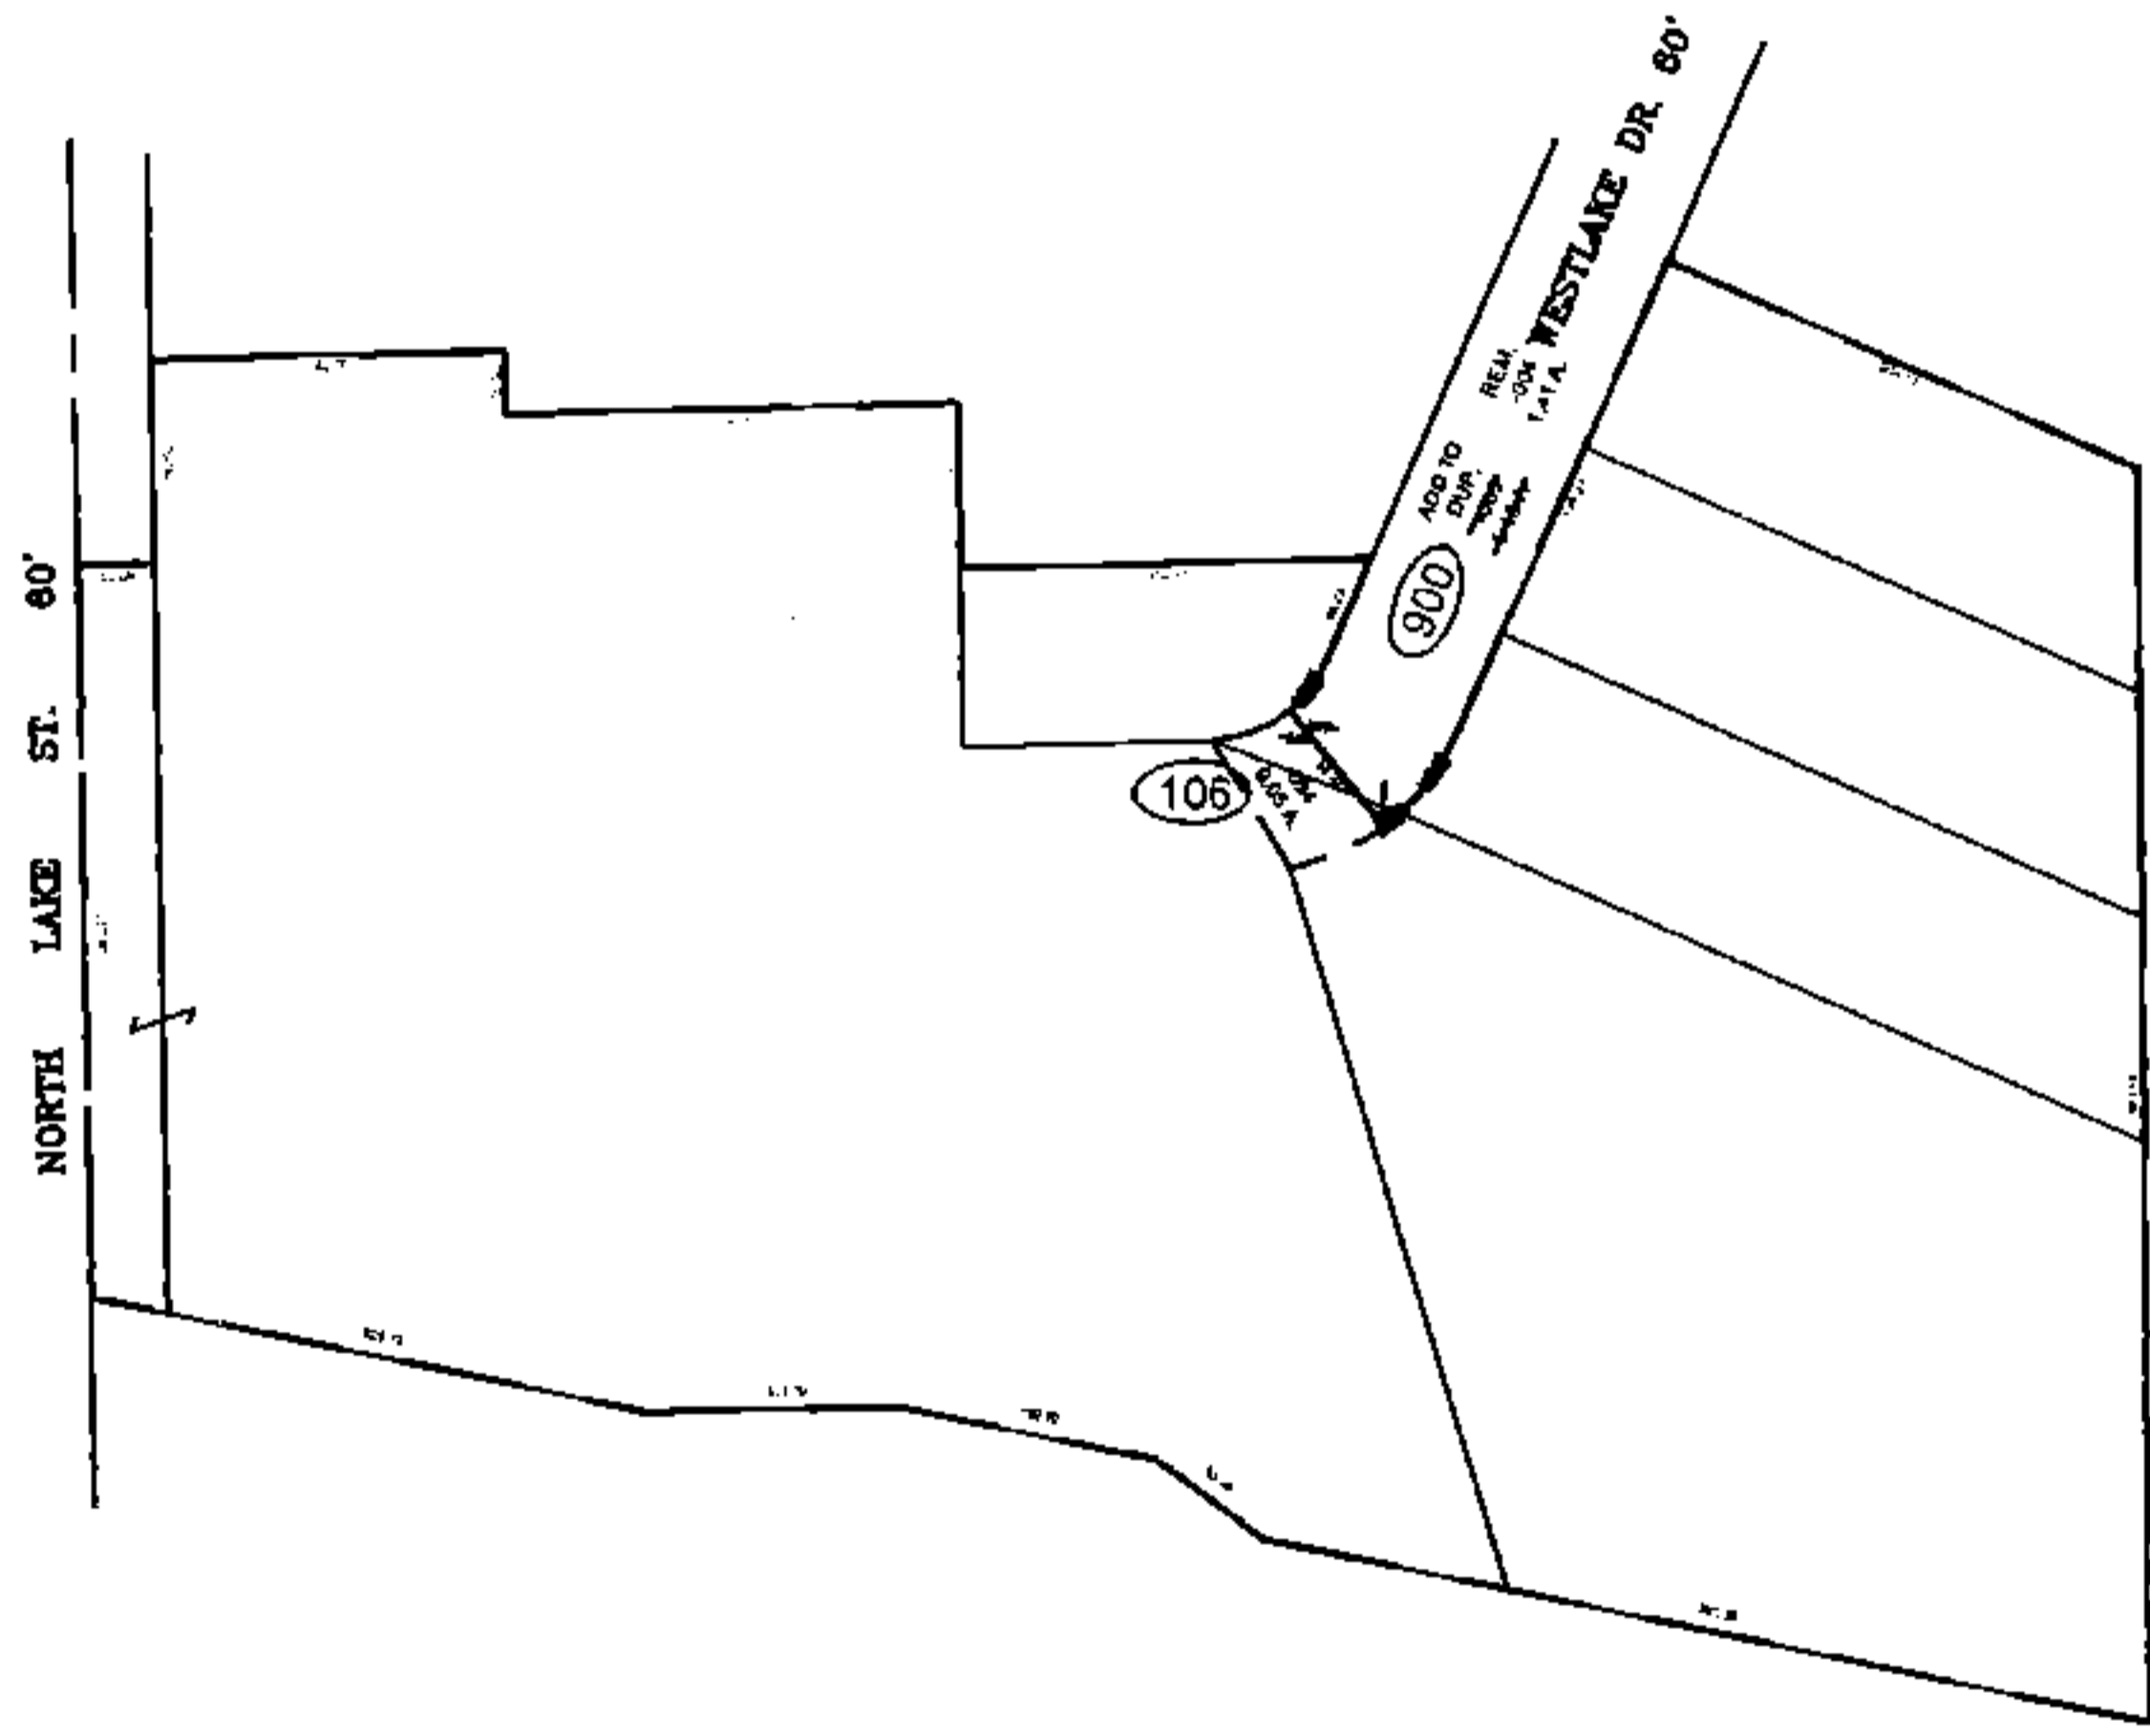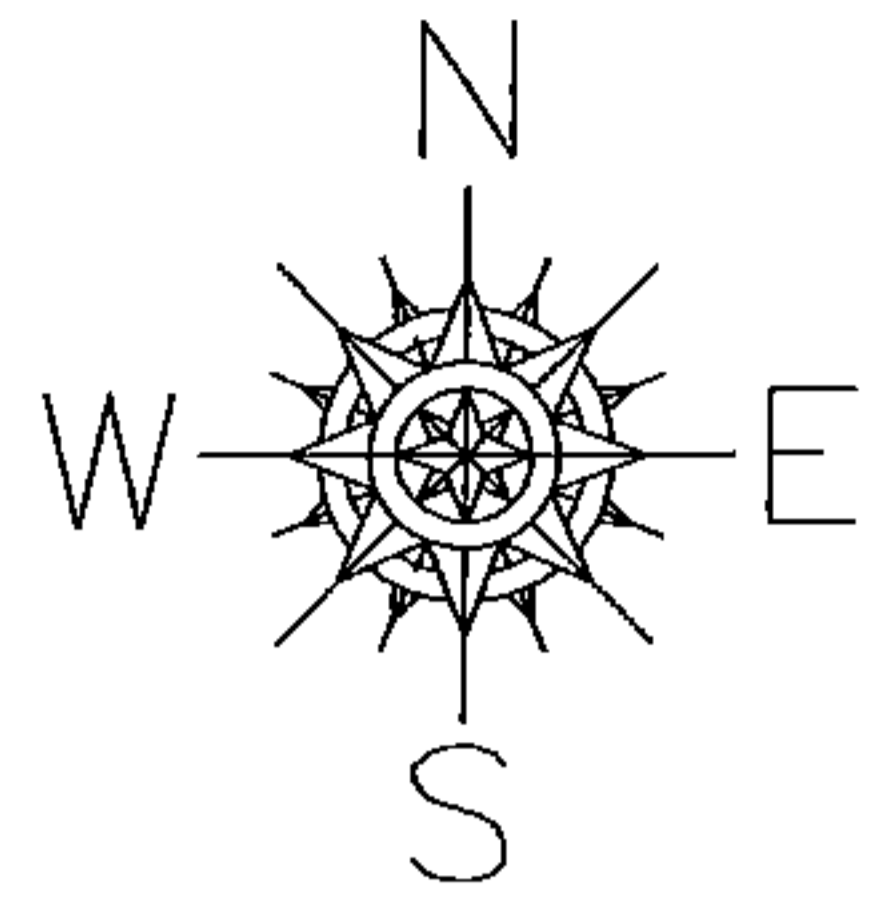

SPLITS/DEEDS PROCESSED
LORAIN COUNTY TAX MAP DEPARTMENT
226 MIDDLE AVE. ELYRIA, OHIO

SURVEYED BY: ANDREW PLANET
CLOSURE: 0.01 : 10,000
MAP PAGE(S): 05-00-018
APPROVED BY: TJS DATE: 1/3/16
SCALE: 1" = 200' PRIOR INSTRUMENT: DV XXXX/XXX