
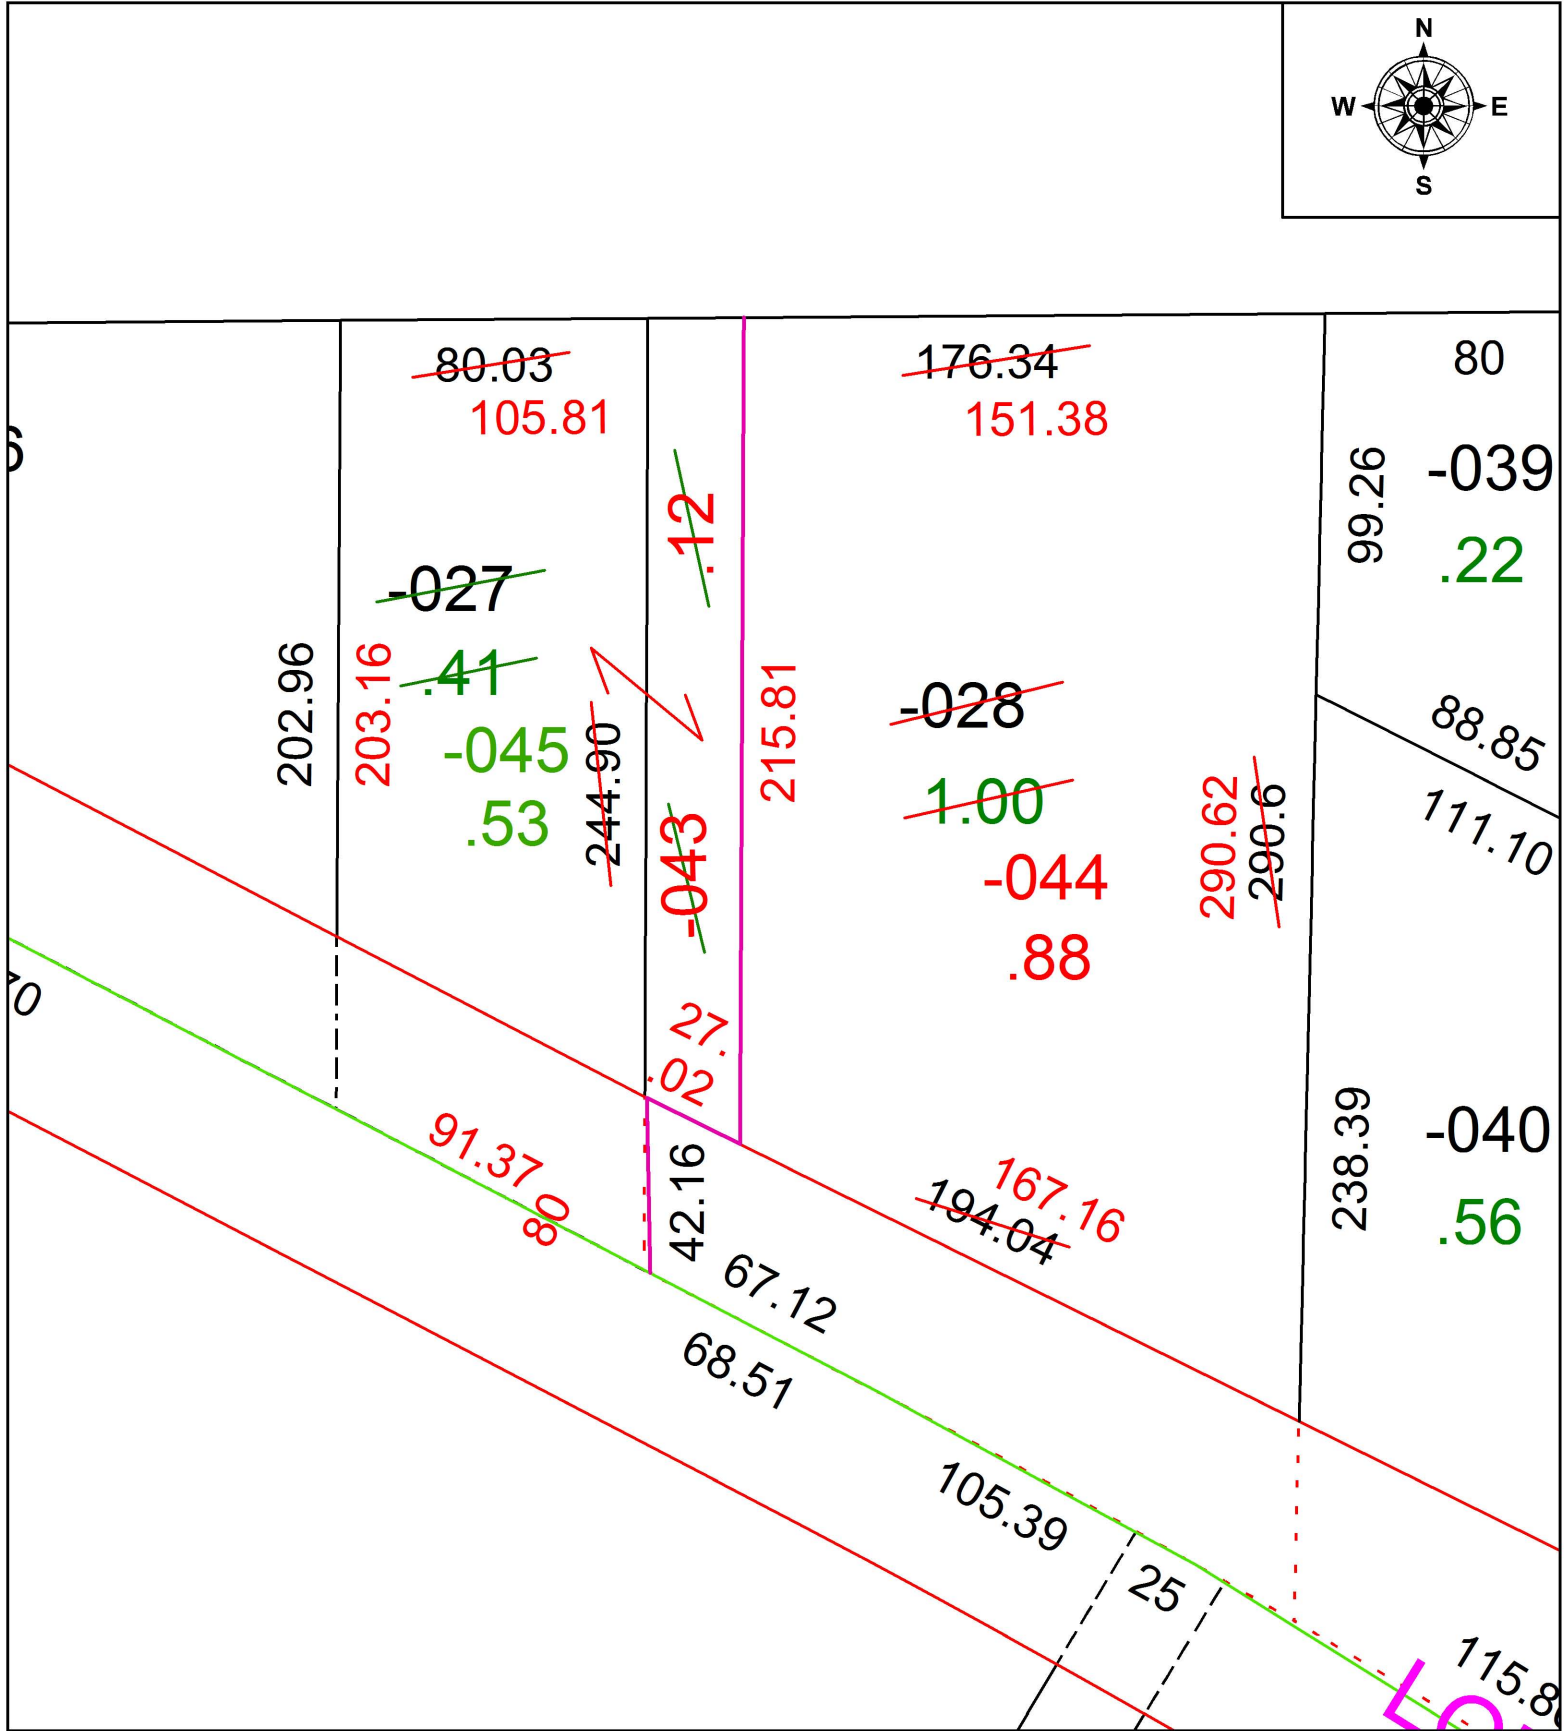


PARENT PARCEL: 04-00-010-106-027, -028

CHILD PARCEL: 04-00-010-106-043, -044, -045

STARTING POINT: SOUTHEAST CORNER OF S/L 114 IN EATON SUB. NO.3

16-03571

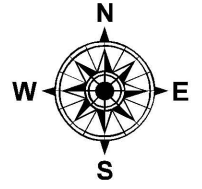

SPLITS/DEEDS PROCESSED
 LORAIN COUNTY TAX MAP DEPARTMENT
 226 MIDDLE AVE. ELYRIA, OH

SURVEYED BY: AMY M. KELLY
 CLOSURE: 1: 93,367
 MAP PAGE(S): 4-00-010
 APPROVED BY: RRM DATE: 9-22-16
 SCALE: 1" = 50 PRIOR INSTRUMENT: 20140518034