


PARENT PARCEL: 10-00-004-132-018

CHILD PARCEL: XX-XX-XXX-XXX-XXX

STARTING POINT: I.P. CL OF CHESTNUT RIDGE RD. & CL OF EAST RIVER RD.

16-03578-A

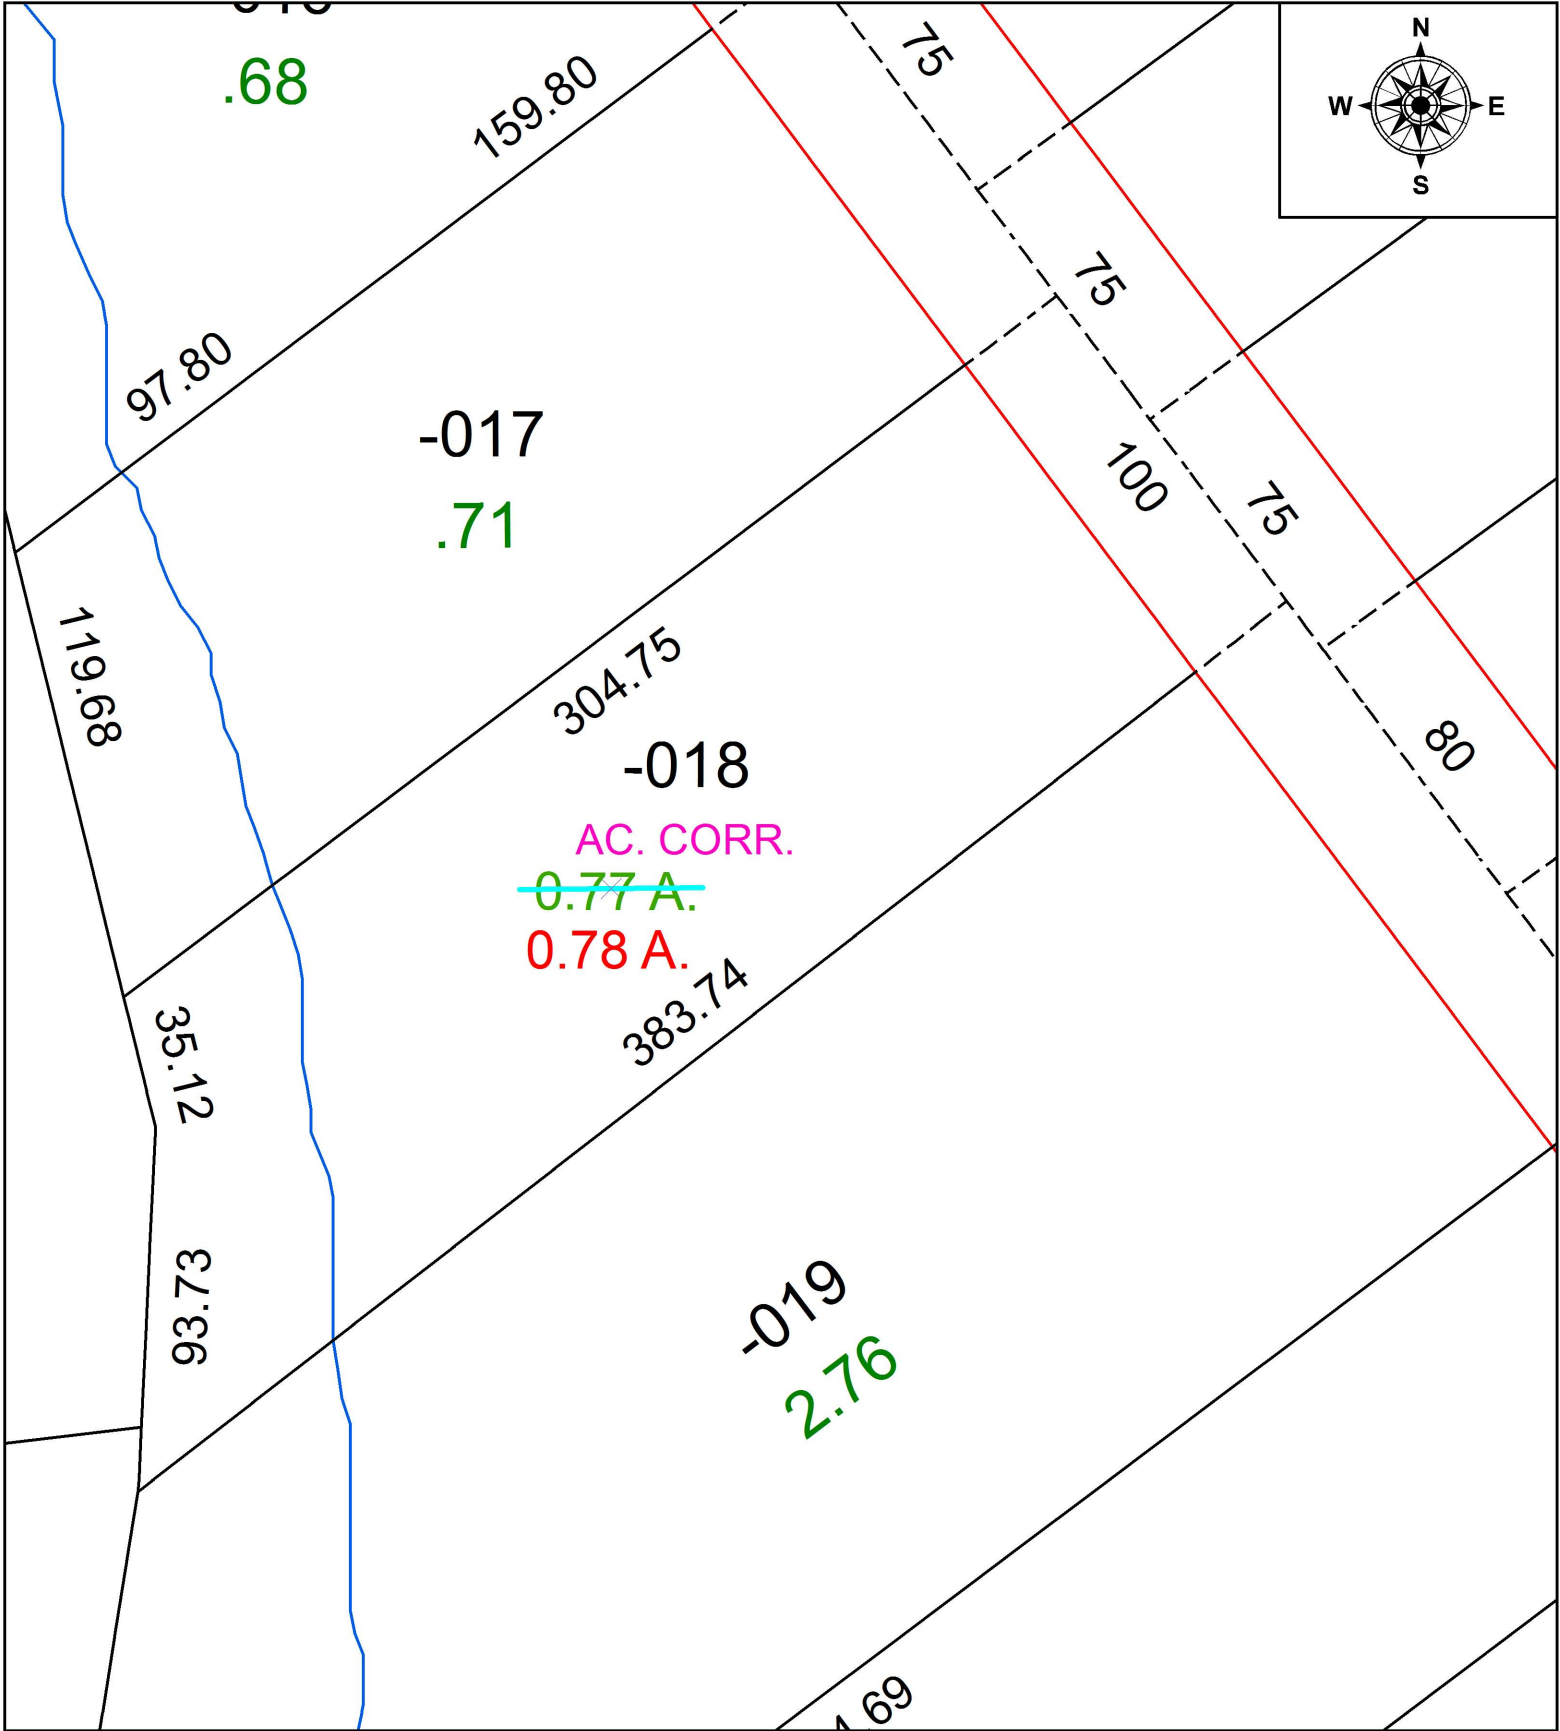

SPLITS/DEEDS PROCESSED
 LORAIN COUNTY TAX MAP DEPARTMENT
 226 MIDDLE AVE. ELYRIA, OH

SURVEYED BY: _____ NA _____
 CLOSURE: _____ 1: 100,000 _____
 MAP PAGE(S): _____ 10-00-004 _____
 APPROVED BY: _____ TJS _____ DATE: _____ 1/9/17 _____
 SCALE: _____ 1" = 50' _____ PRIOR INSTRUMENT: _____ 2014-0492501 _____