


PARENT PARCEL: 15-00-054-000-010, 038

CHILD PARCEL: 15-00-054-000-040

STARTING POINT: INTERSECTION OF C/L OF WHEELER RD. AND C/L OF S.R. 303

16-03580

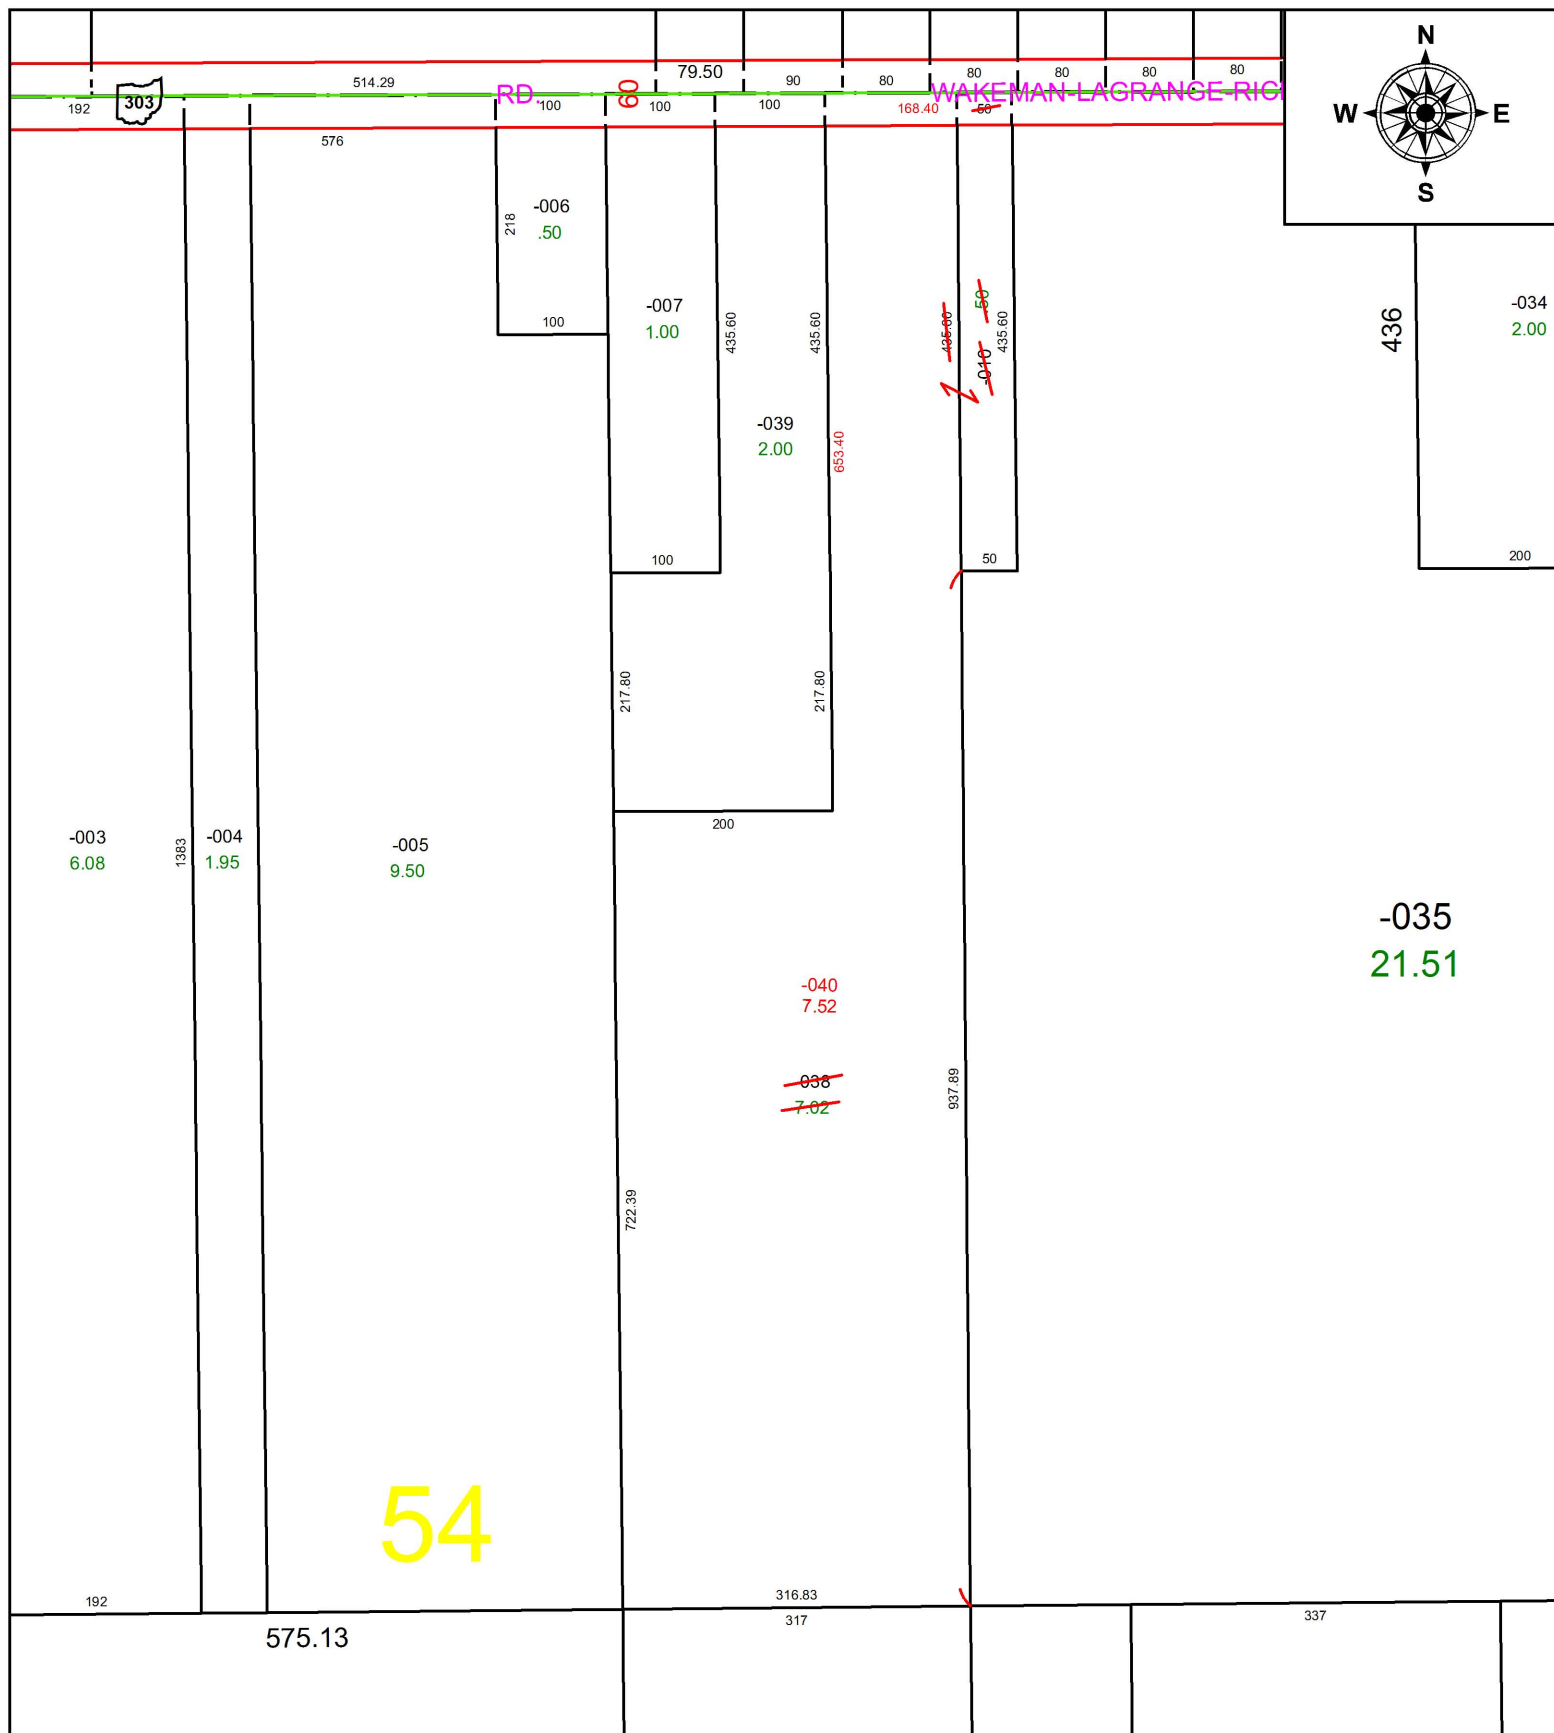

SPLITS/DEEDS PROCESSED
 LORAIN COUNTY TAX MAP DEPARTMENT
 226 MIDDLE AVE. ELYRIA, OH

SURVEYED BY: RICHARD A. FREDRICKSON
CLOSURE: 1: 280,420
MAP PAGE(S): 15-00-054
APPROVED BY: RRM **DATE:** 10-7-16
SCALE: 1" = 175 **PRIOR INSTRUMENT:** 20020852710