
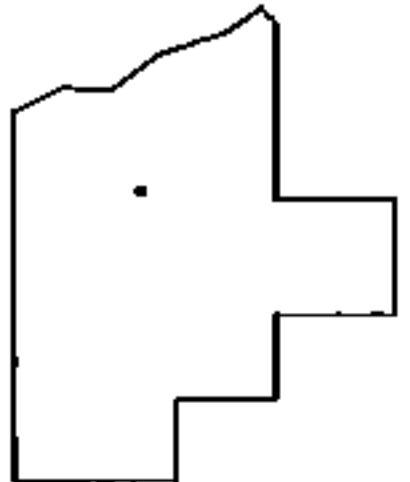
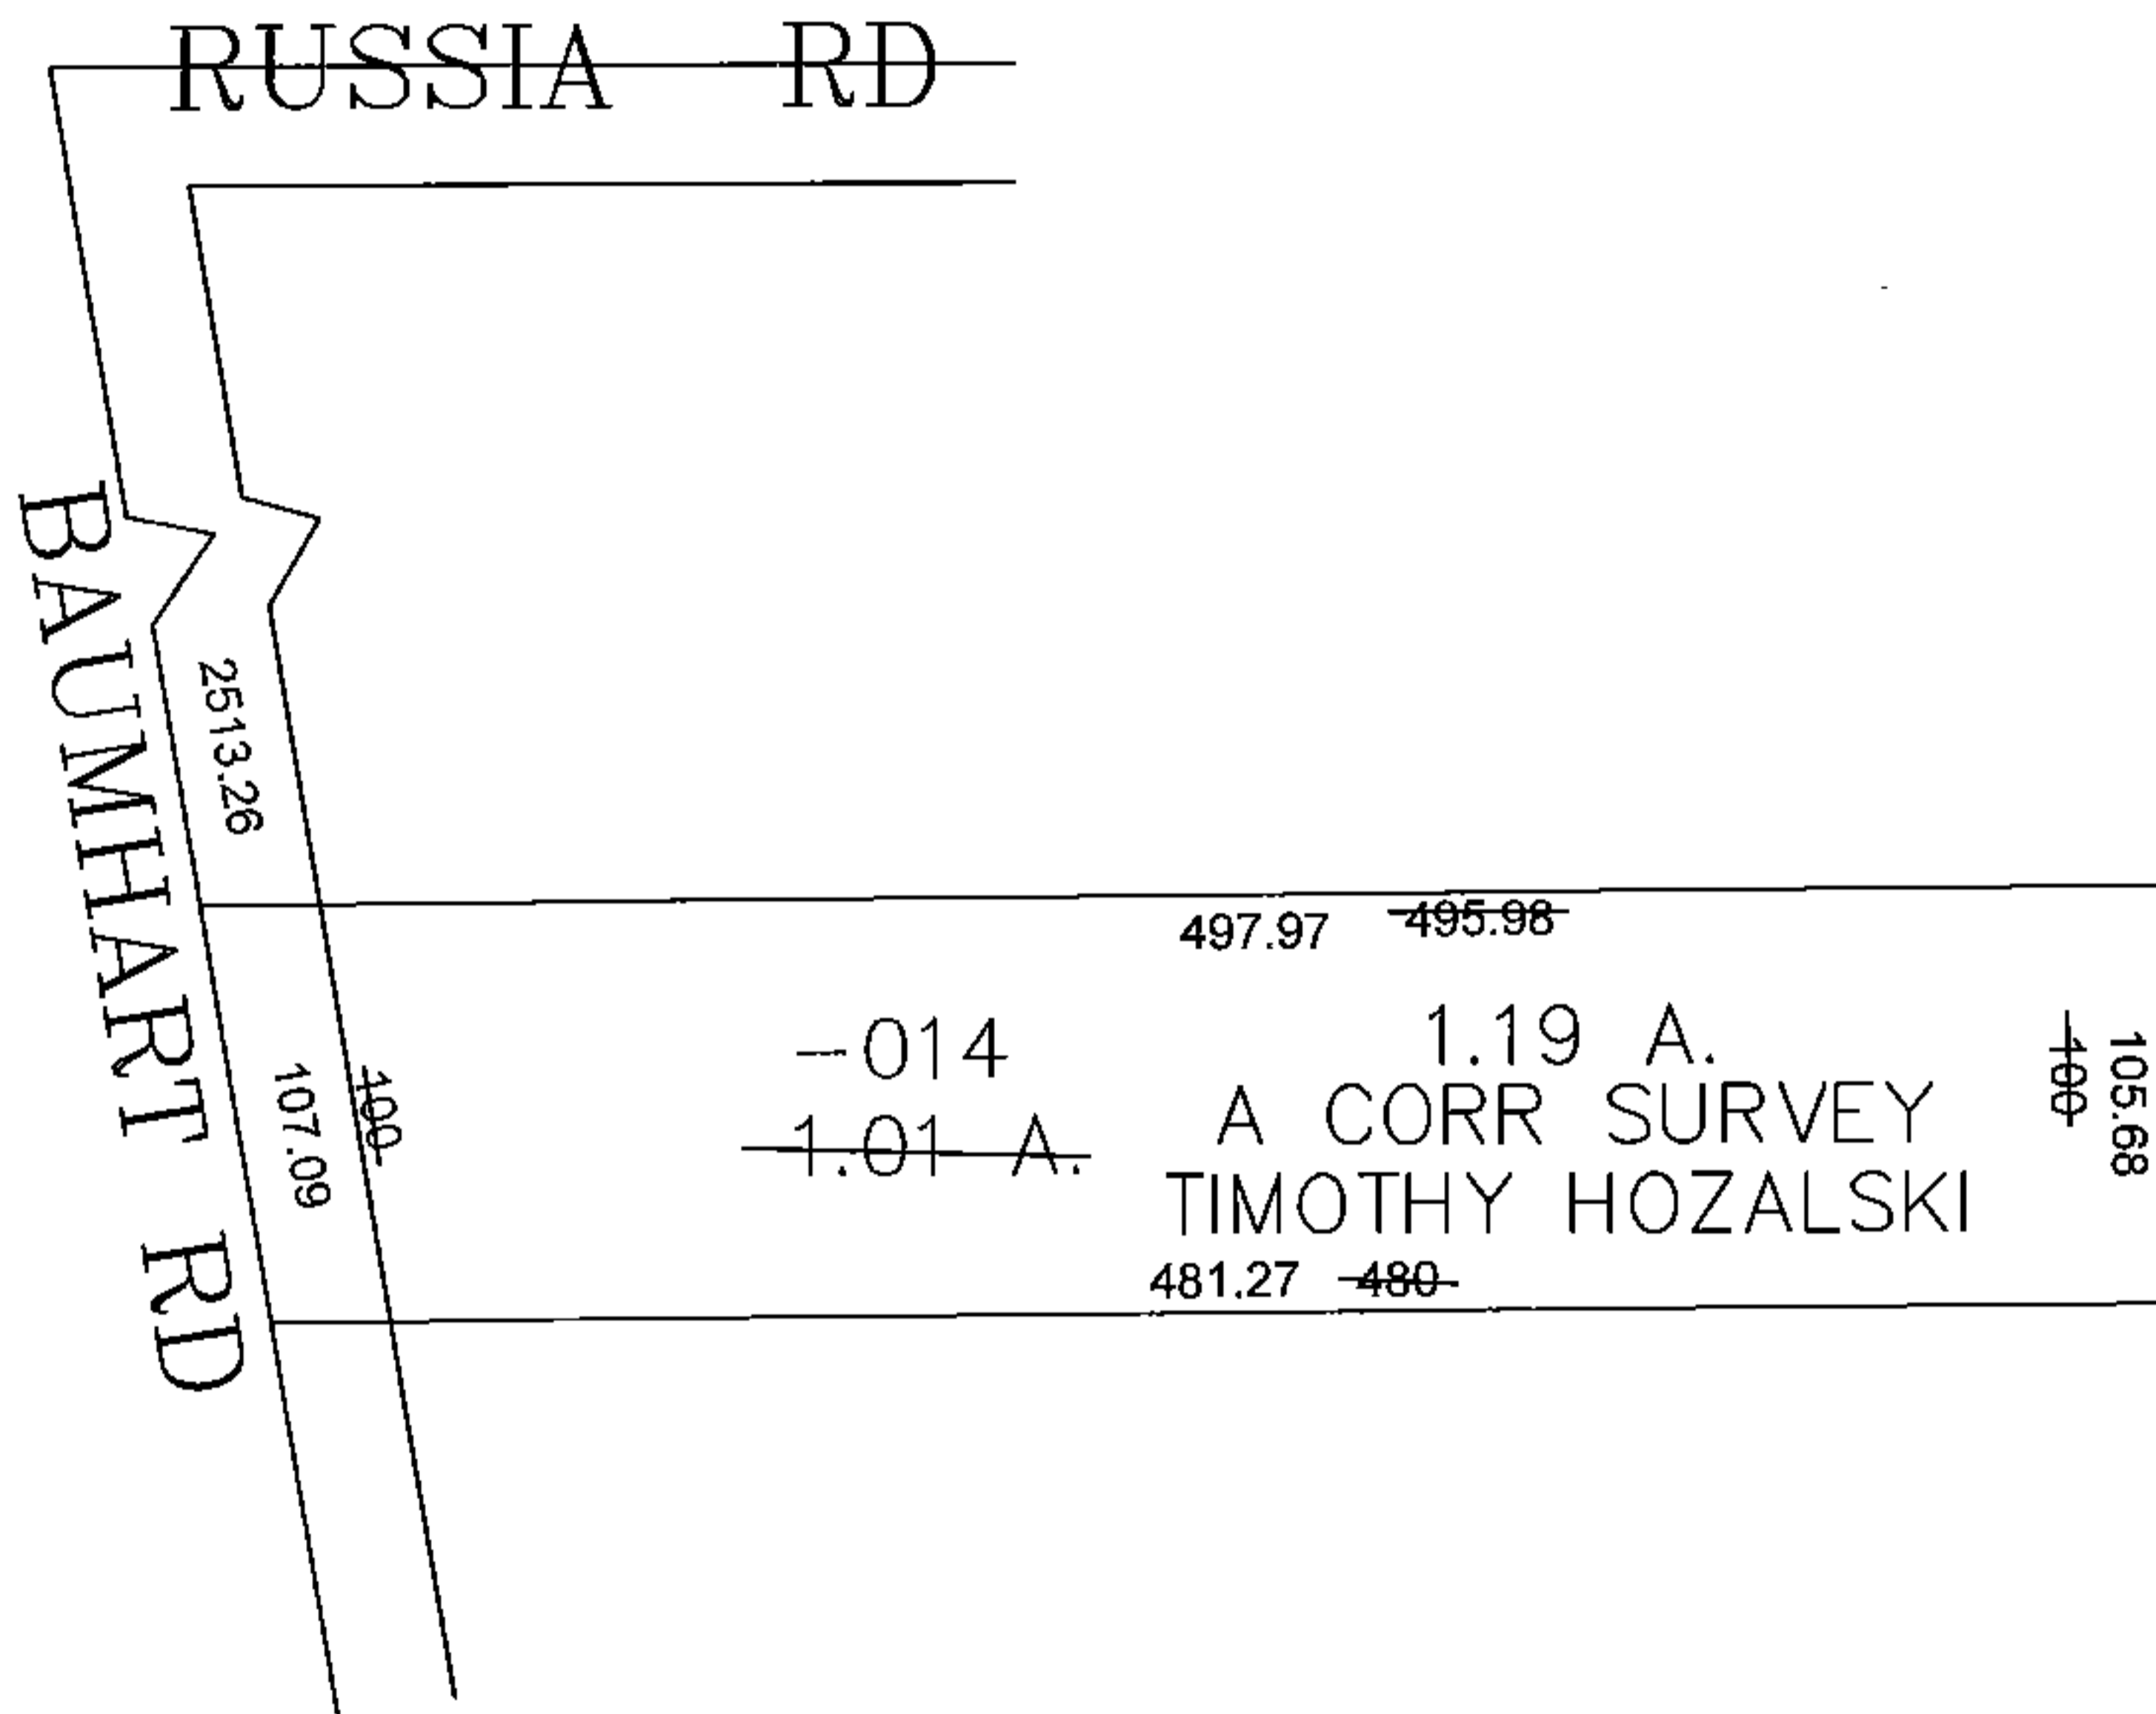


PARENT PARCEL: 08-00-103-000-014

CHILD PARCEL: SAME

STARTING POINT: CENTERLINE OF RUSSIA RD & BAUMHART RD

17-03582-X

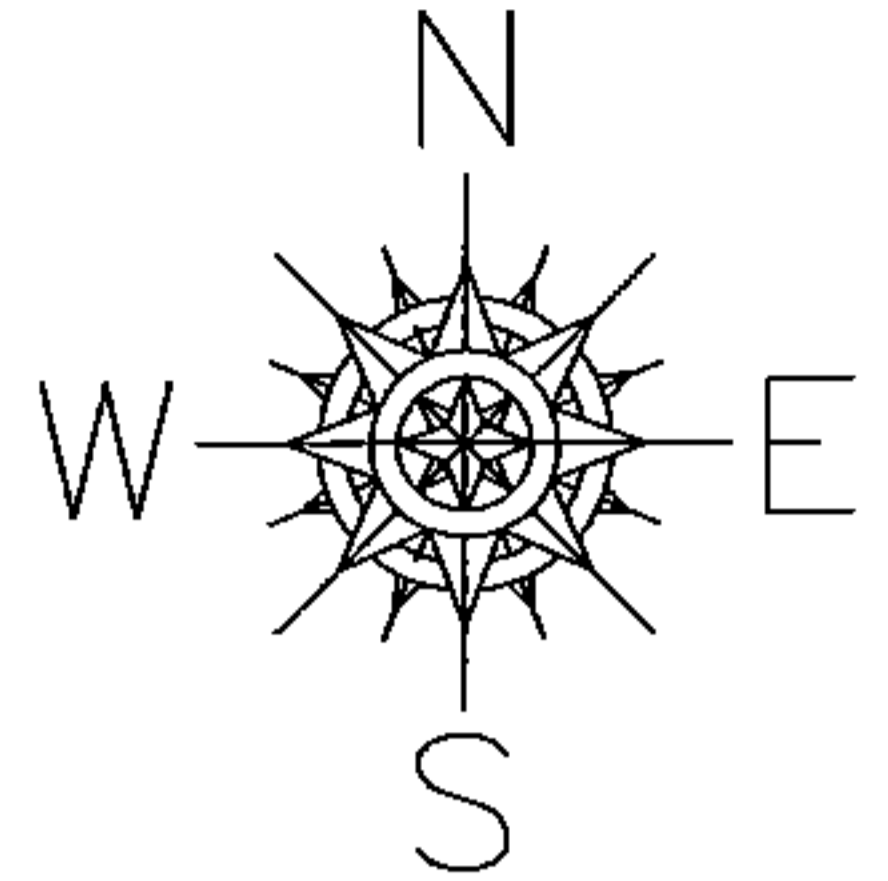

SPLITS/DEEDS PROCESSED

LORAIN COUNTY TAX MAP DEPARTMENT  
226 MIDDLE AVE. ELYRIA, OHIO

SURVEYED BY: TIMOTHY HOZALSKI  
 CLOSURE: 0.00 : 10,000  
 MAP PAGE(S): 8-A  
 APPROVED BY: JAH DATE: 1/4/2017  
 SCALE: 1" = 100 PRIOR INSTRUMENT: 20050087600