


PARENT PARCEL: 06-24-157-000-004

CHILD PARCEL: MAP CORRECTION ONLY

STARTING POINT: CL OF WEST RIVER RD. & CL OF FURNACE ST.

17-03584-C

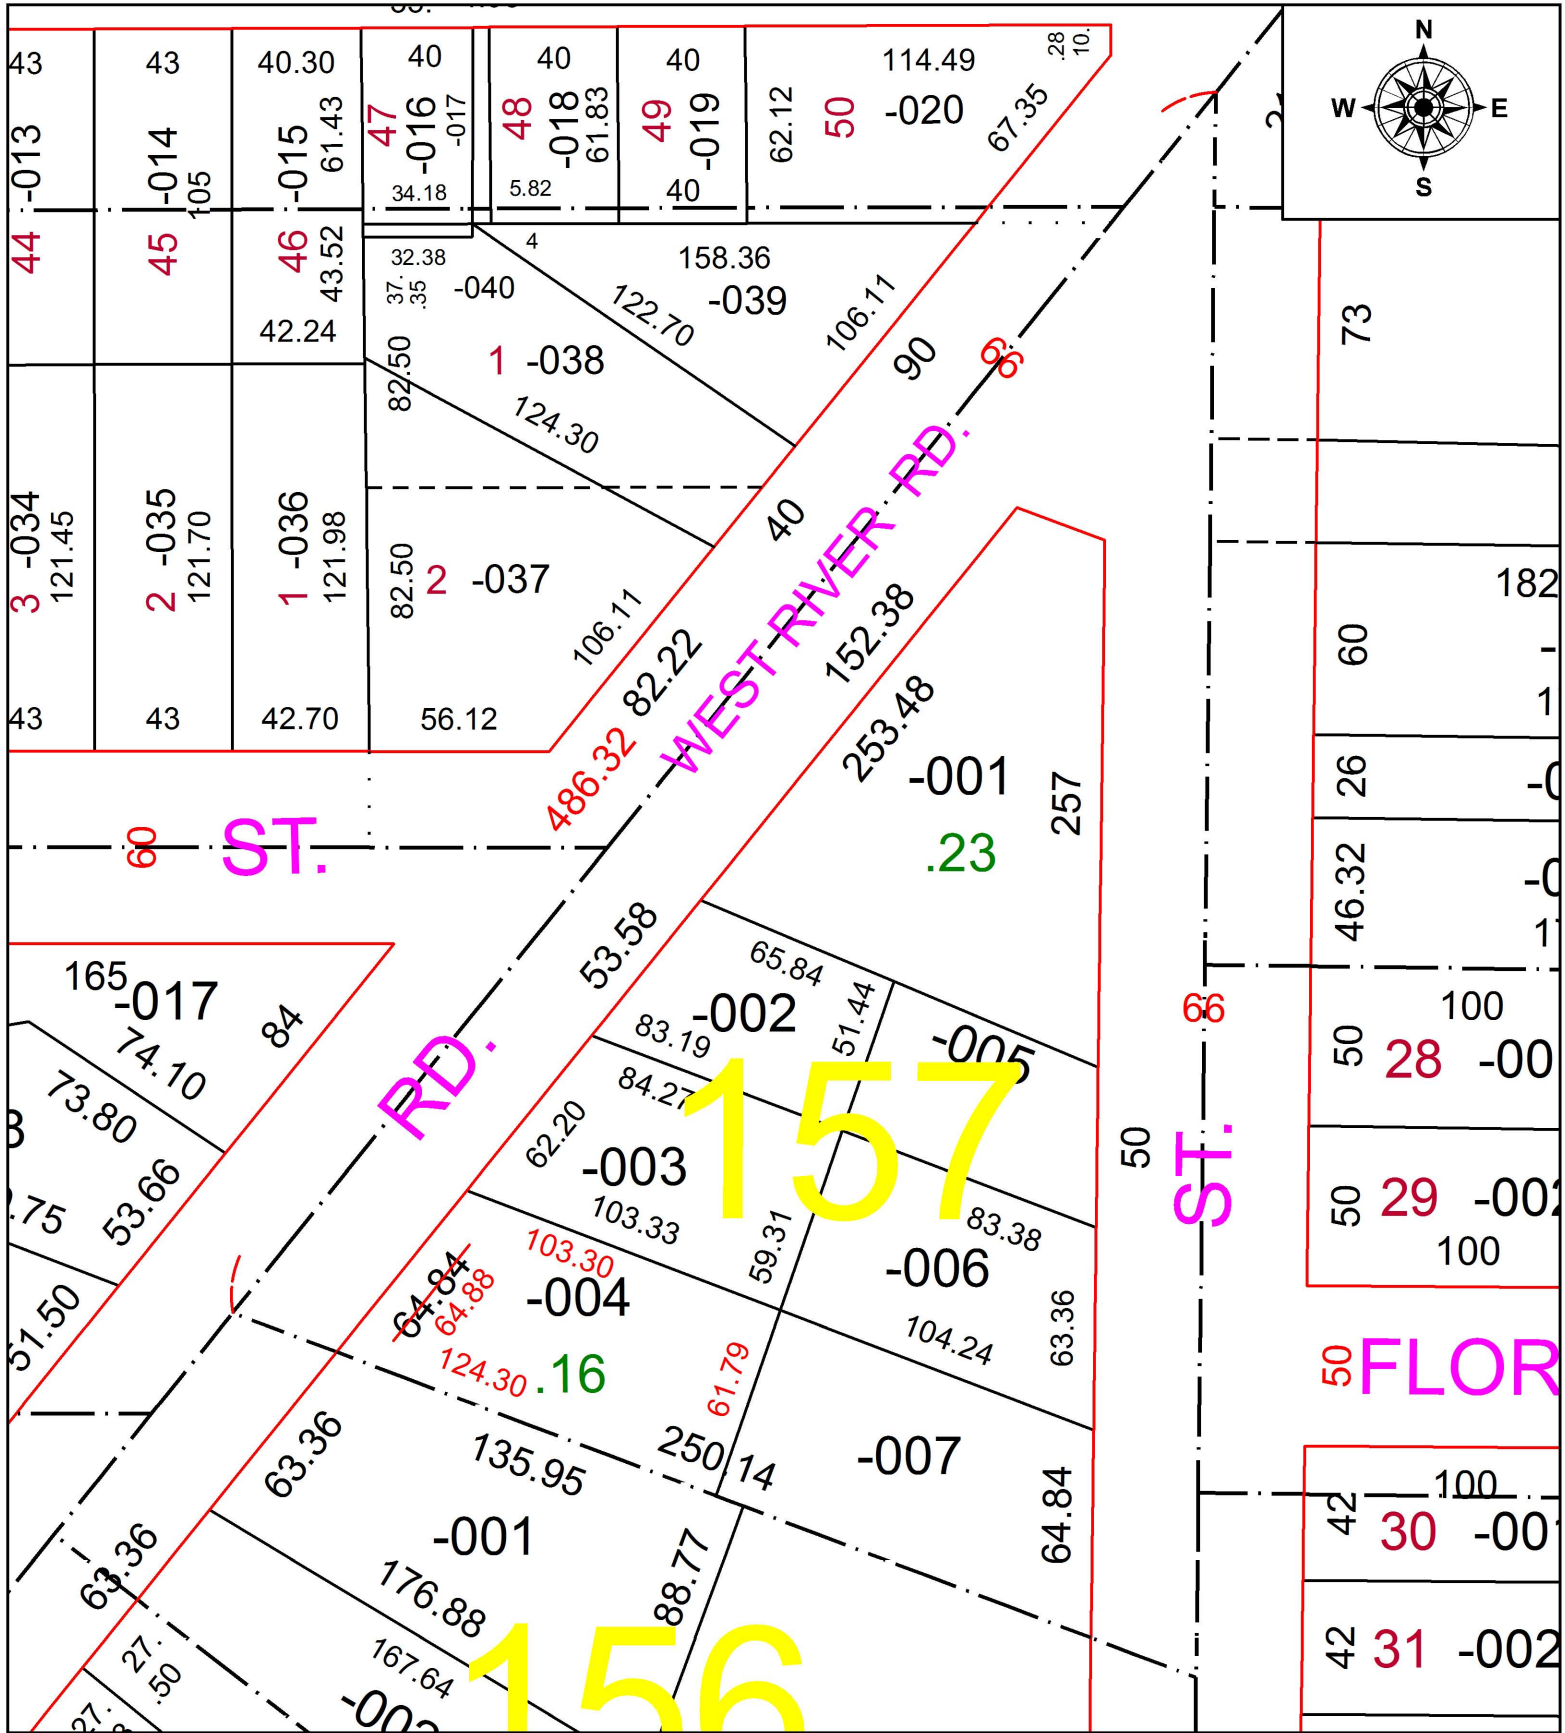

SPLITS/DEEDS PROCESSED
 LORAIN COUNTY TAX MAP DEPARTMENT
 226 MIDDLE AVE. ELYRIA, OH

SURVEYED BY: WILFREDO BARBOSA

CLOSURE: 1: 48,000

MAP PAGE(S): 06-24-157

APPROVED BY: TJS DATE: 1/12/17

SCALE: 1" = 60 PRIOR INSTRUMENT: 2012-0434100