
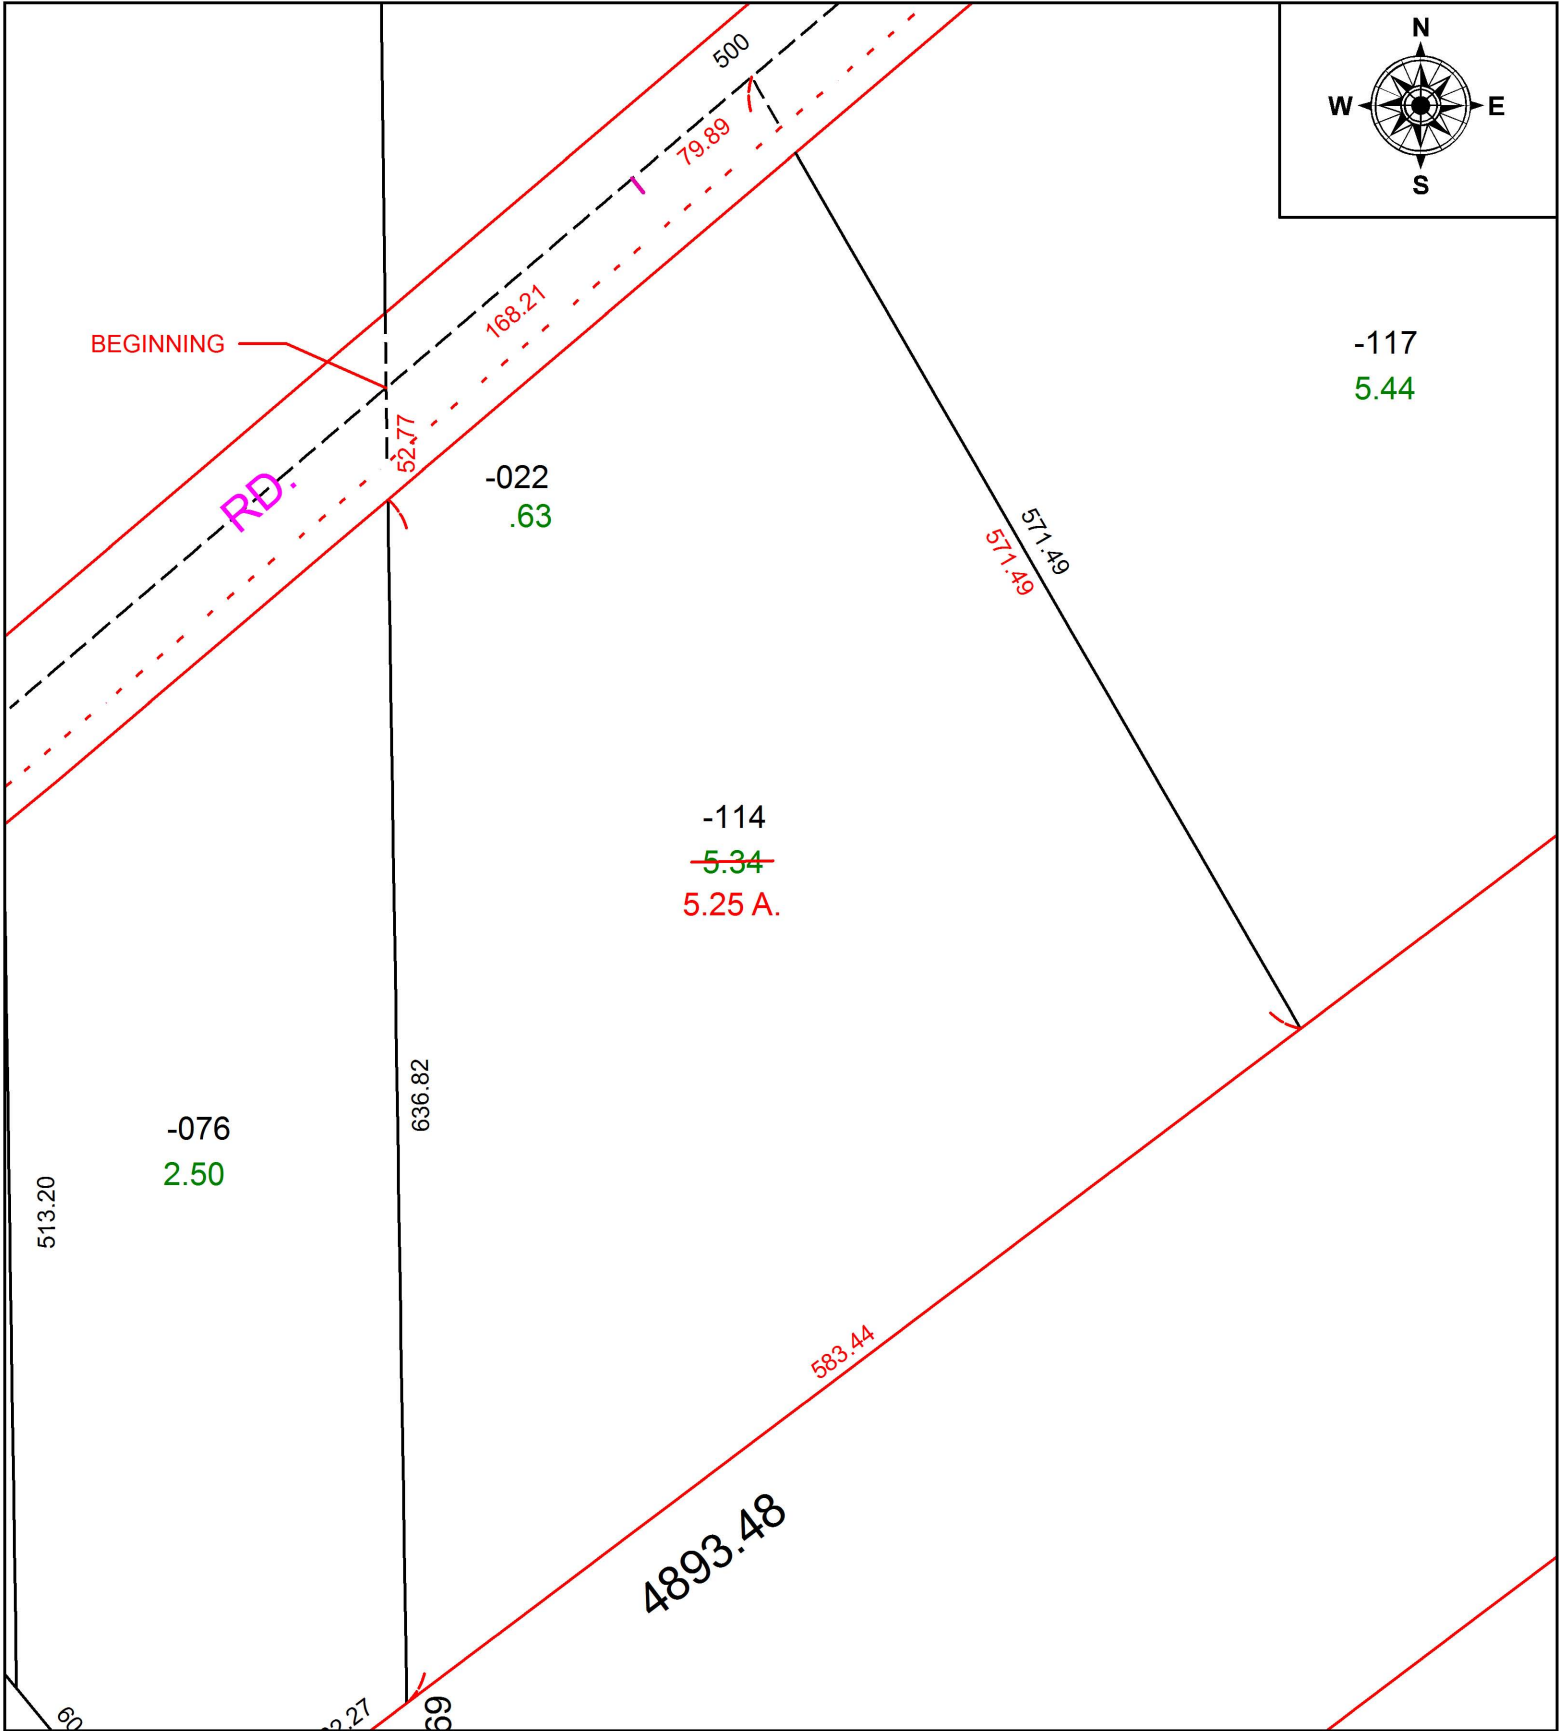


PARENT PARCEL: 10-00-020-102-114

CHILD PARCEL: ACREAGE CORR. PER SURV. MINUS EXCEPTION

STARTING POINT: CL OF OBERLIN-ELYRIA RD. & N.E. CORNER OF EVA HUNGERFORD BERG DV 1046/331

17-03585-A

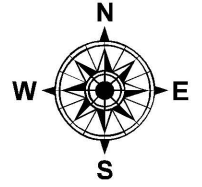

**SPLITS/DEEDS PROCESSED**  
 LORAIN COUNTY TAX MAP DEPARTMENT  
 226 MIDDLE AVE. ELYRIA, OH

SURVEYED BY:           K.S. ASSOC.            
 CLOSURE:           1: 34,000            
 MAP PAGE(S):           10-00-020            
 APPROVED BY:           TJS           DATE:           1/17/17            
 SCALE:           1" = 100           PRIOR INSTRUMENT:           2016-0571637