
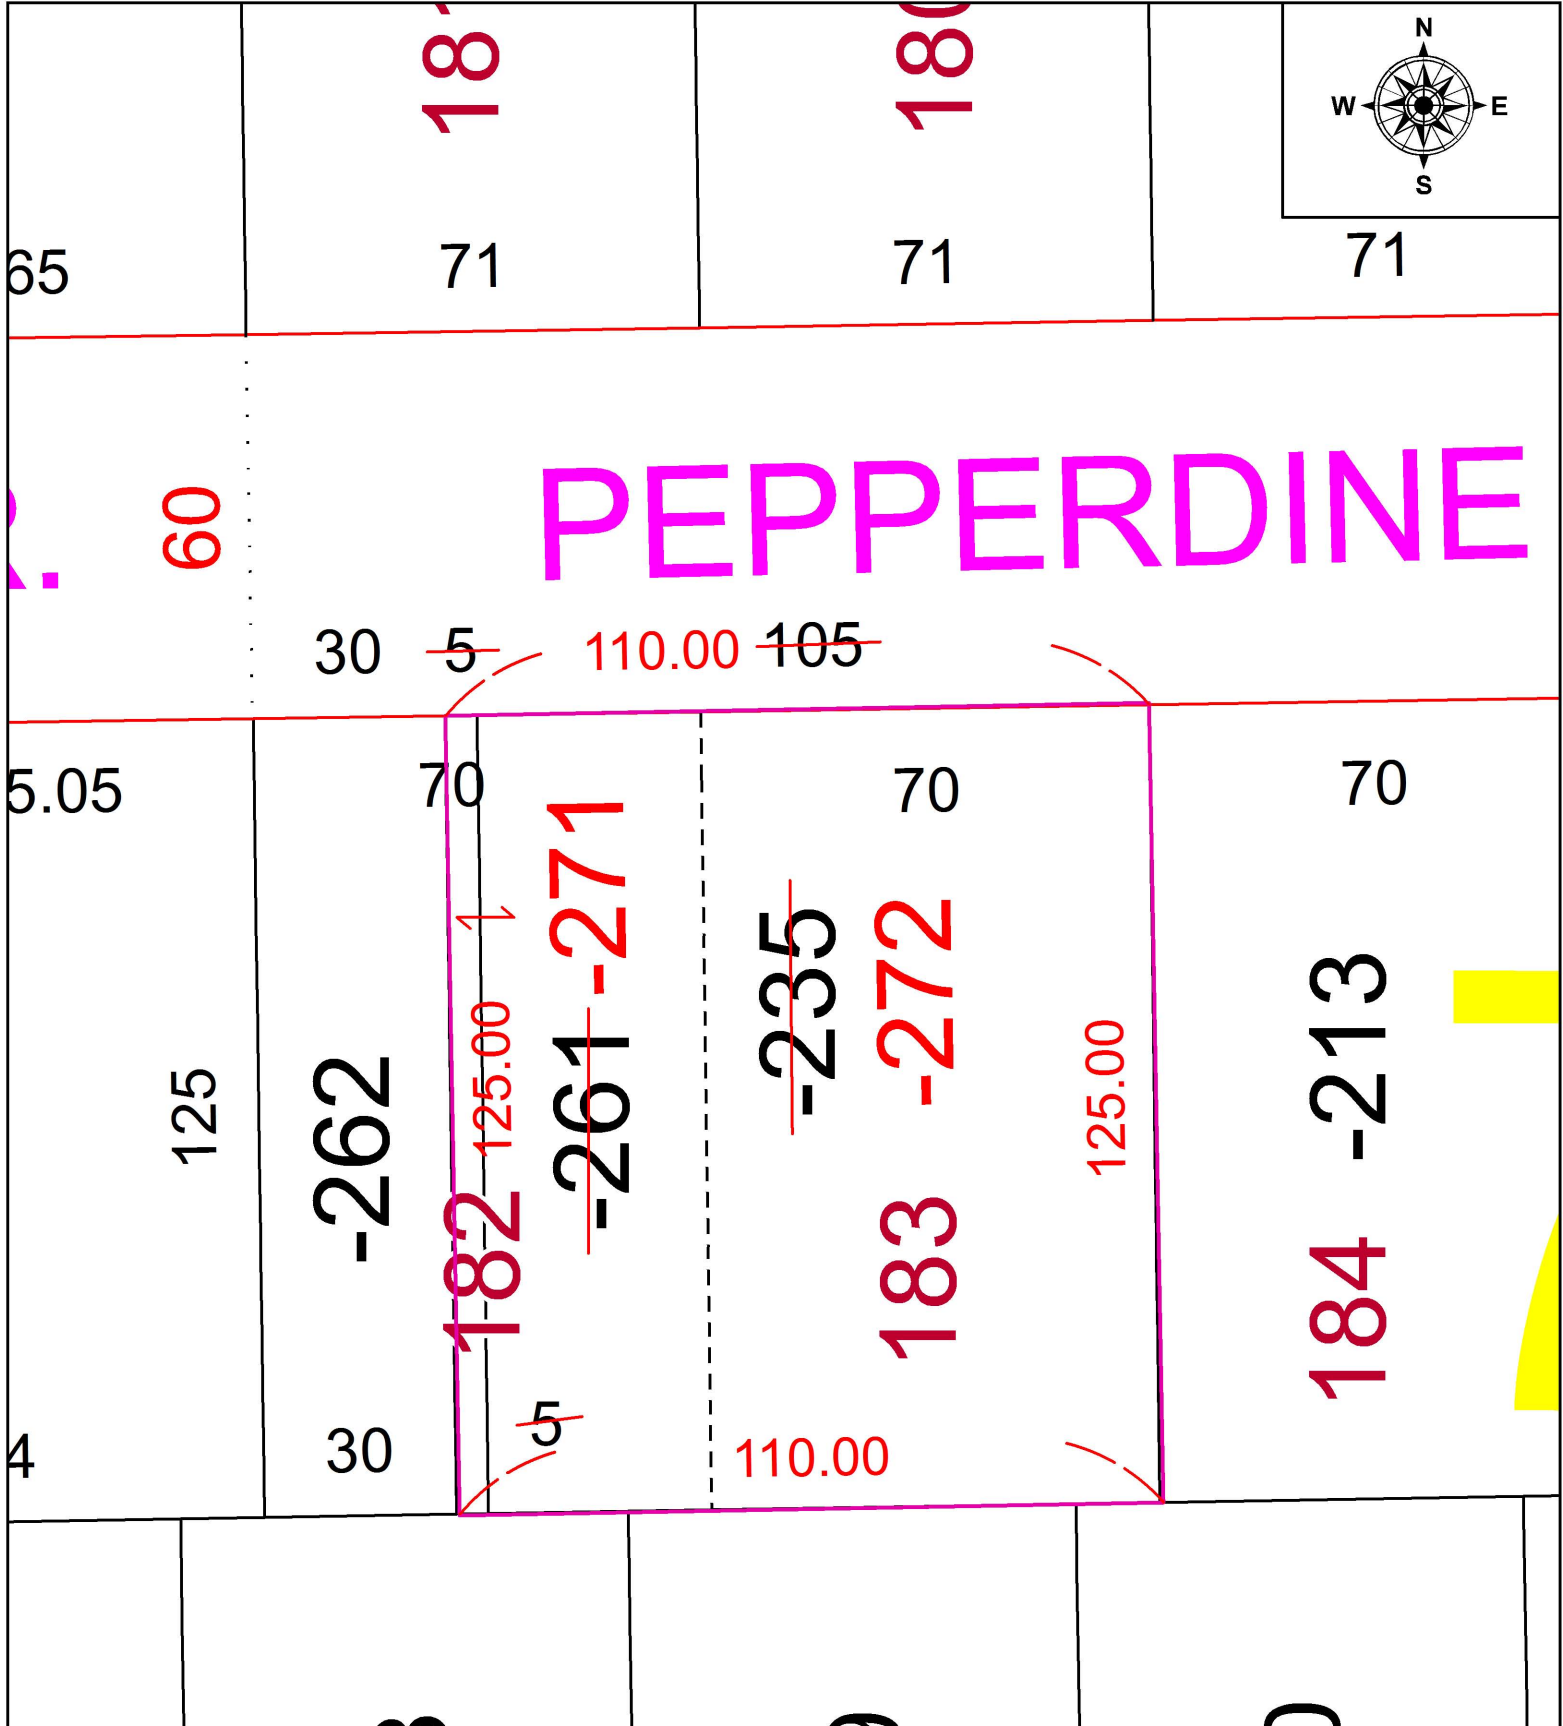


PARENT PARCEL: 06-22-007-000-235 & -261

CHILD PARCEL: 06-22-007-000-271 & -272

STARTING POINT: N.W. CORNER OF S/L 182

17-03588-C

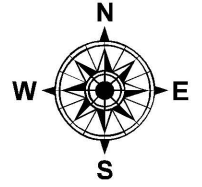

**SPLITS/DEEDS PROCESSED**  
 LORAIN COUNTY TAX MAP DEPARTMENT  
 226 MIDDLE AVE. ELYRIA, OH

SURVEYED BY: DAVID ELWELL  
 CLOSURE: 1: INF.  
 MAP PAGE(S): 06-22-007  
 APPROVED BY: TJS DATE: 1/24/17  
 SCALE: 1" = 30' PRIOR INSTRUMENT: 2015-036540