
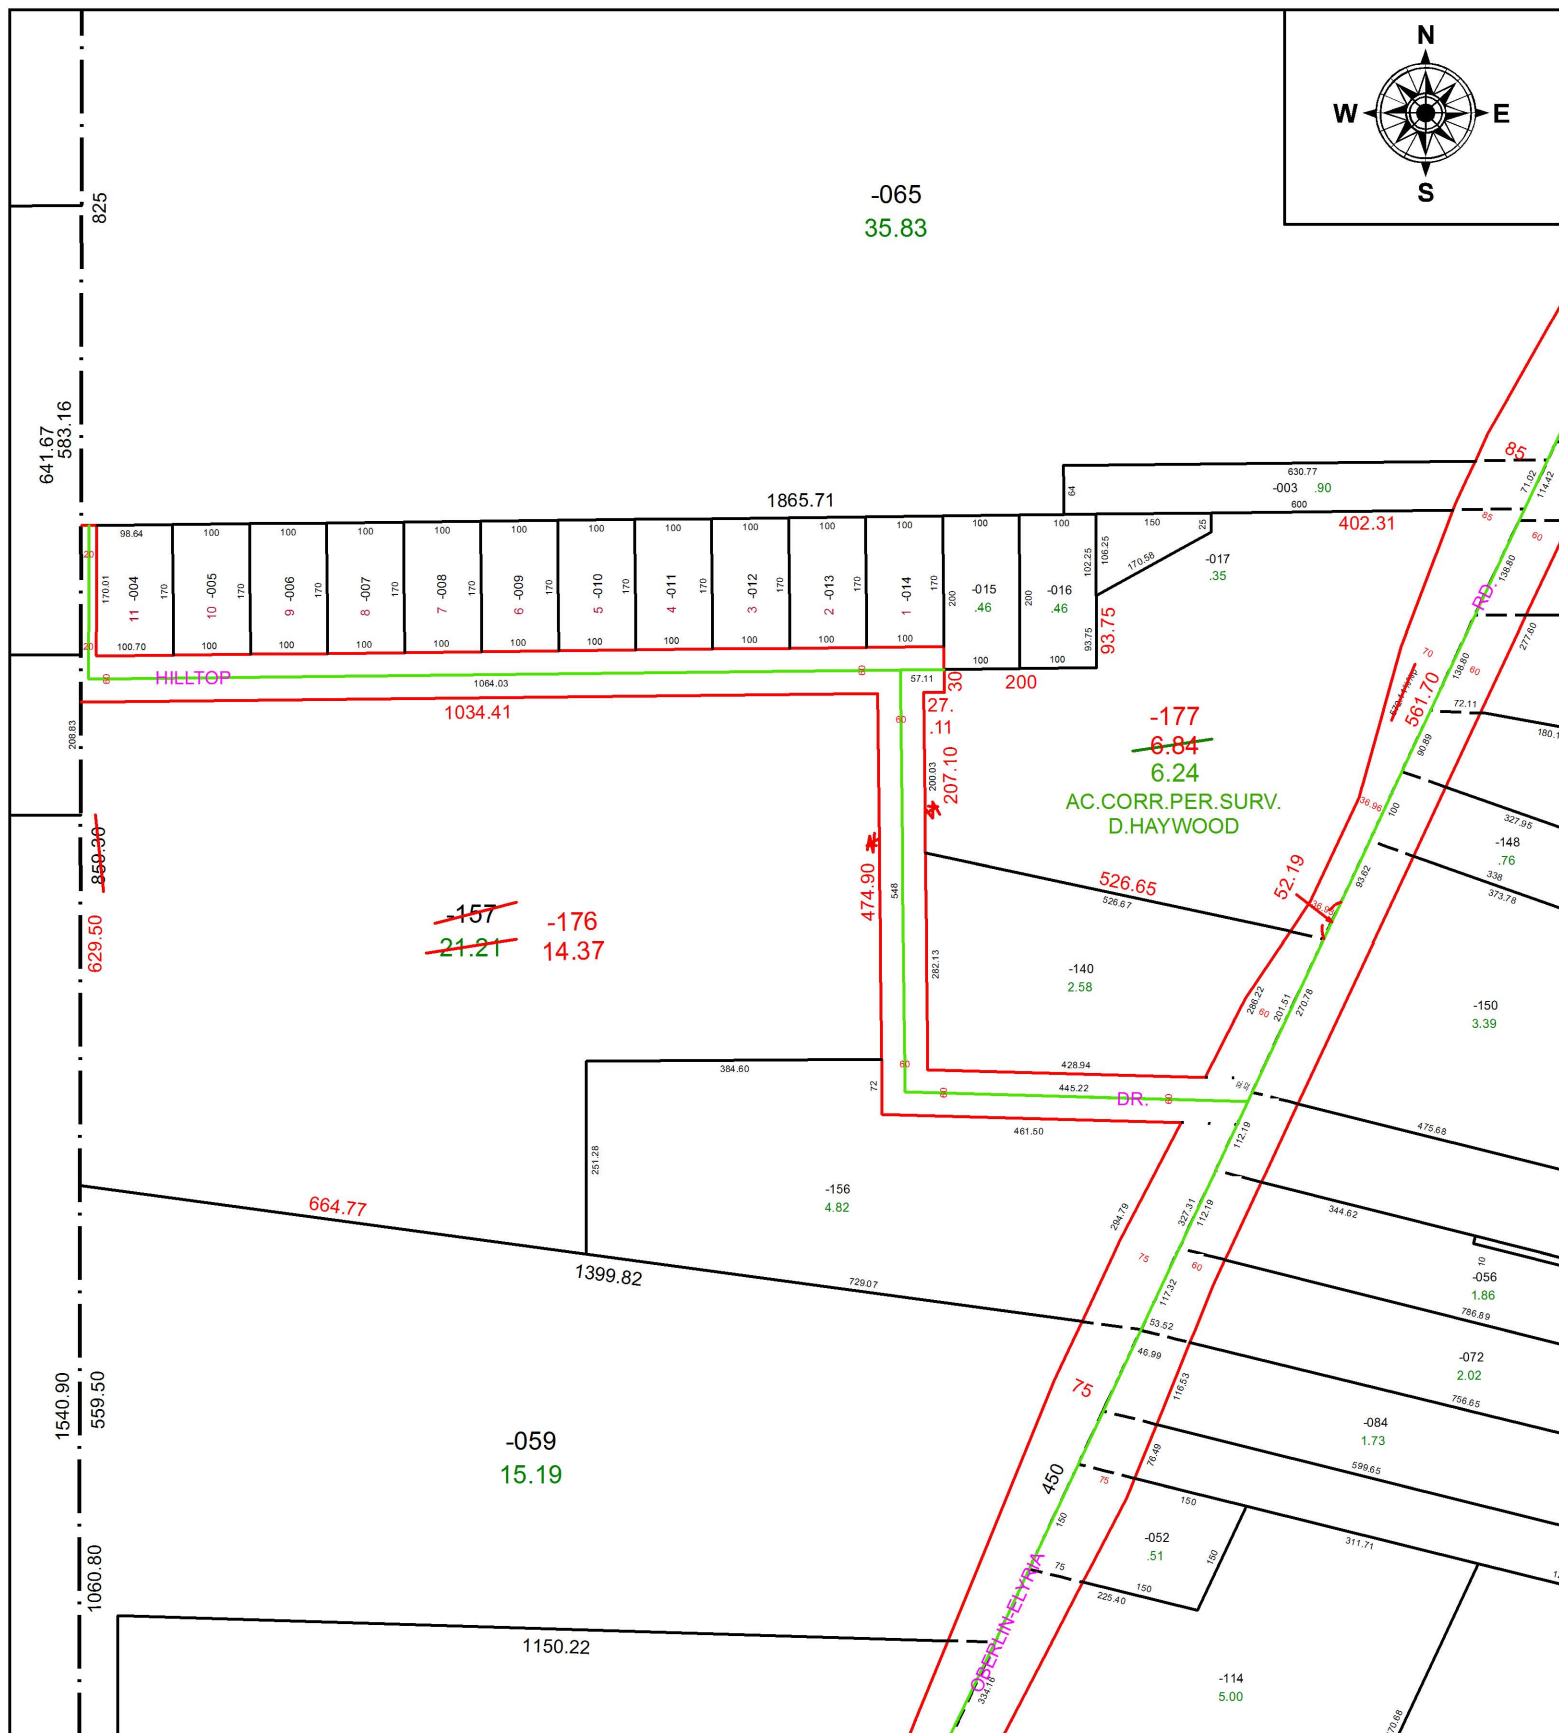


PARENT PARCEL: 10-00-012-000-157

CHILD PARCEL: 10-00-012-000-176, -177


16-03588

STARTING POINT: INTERSECTION OF C/L OF HILL TOP DR AND C/L OF OBERLIN-ELYRIA RD.

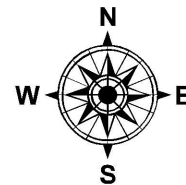

~~157~~ -176
~~21.21~~ 14.37

-177
~~6.84~~
6.24
AC. CORR. PER. SURV.
D. HAYWOOD

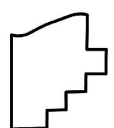

SPLITS/DEEDS PROCESSED
LORAIN COUNTY TAX MAP DEPARTMENT
226 MIDDLE AVE. ELYRIA, OH

SURVEYED BY: DALE R. HAYWOOD
CLOSURE: 1: 17,967
MAP PAGE(S): 10-00-012
APPROVED BY: RRM DATE: 10-21-16
SCALE: 1" = 250 PRIOR INSTRUMENT: 20060128386