

PARENT PARCEL: 10-00-016-000-062, -063





CHILD PARCEL: 10-00-016-000-187

STARTING POINT: INTERSECTION OF C/L OF SLIFE RD. AND C/L OF INDIAN HOLLOW RD.

16-03594



-064
9.11

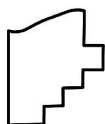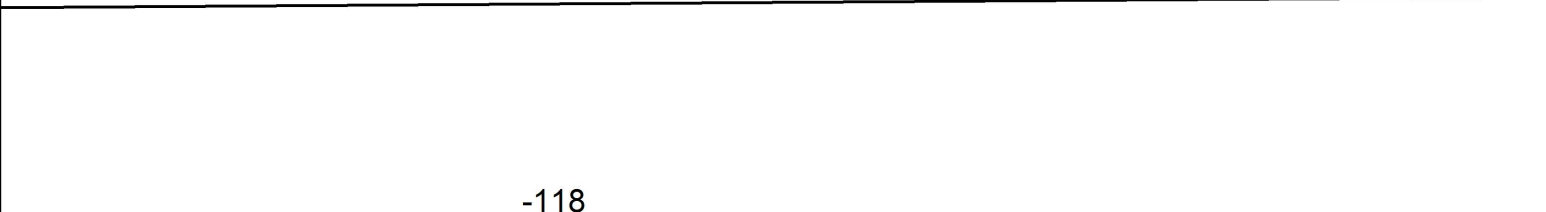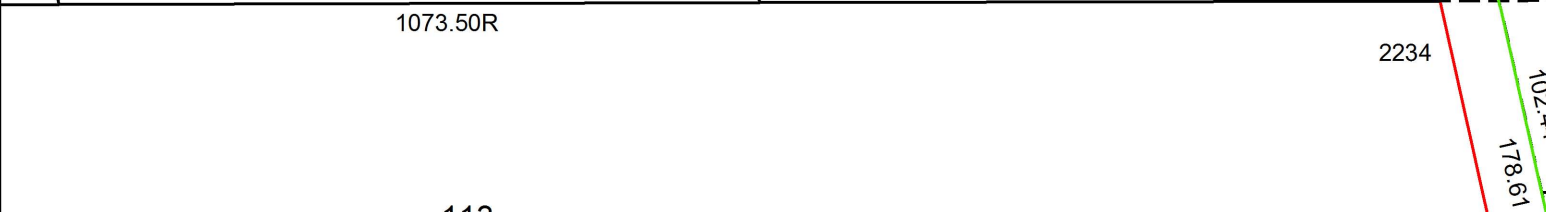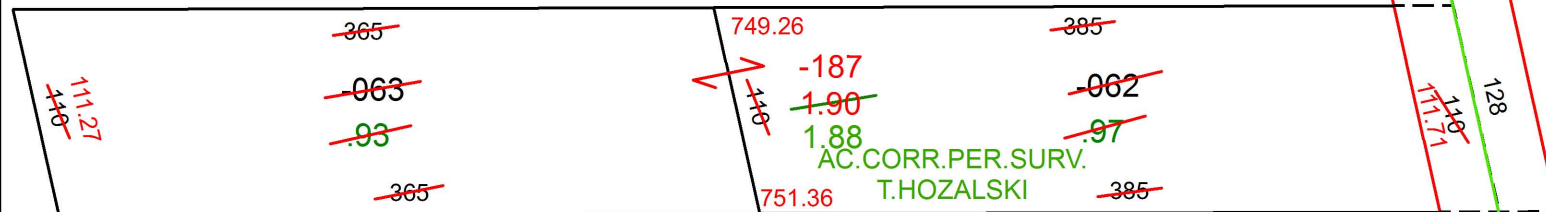

SPLITS/DEEDS PROCESSED
LORAIN COUNTY TAX MAP DEPARTMENT
226 MIDDLE AVE. ELYRIA, OH

SURVEYED BY: TIMOTHY D. HOZALSKI
 CLOSURE: 1: 214,822
 MAP PAGE(S): 10-00-016
 APPROVED BY: RRM DATE: 11-2-16
 SCALE: 1" = 100 PRIOR INSTRUMENT: OR 453/23