


PARENT PARCEL: 15-00-055-102-001

CHILD PARCEL: FR. & DEPTH CORR. FROM 114 X IRR. TO 121.82 X 147.00

STARTING POINT: DRILL HOLE, N.W. CORNER OF O.L. 55

17-03596-C

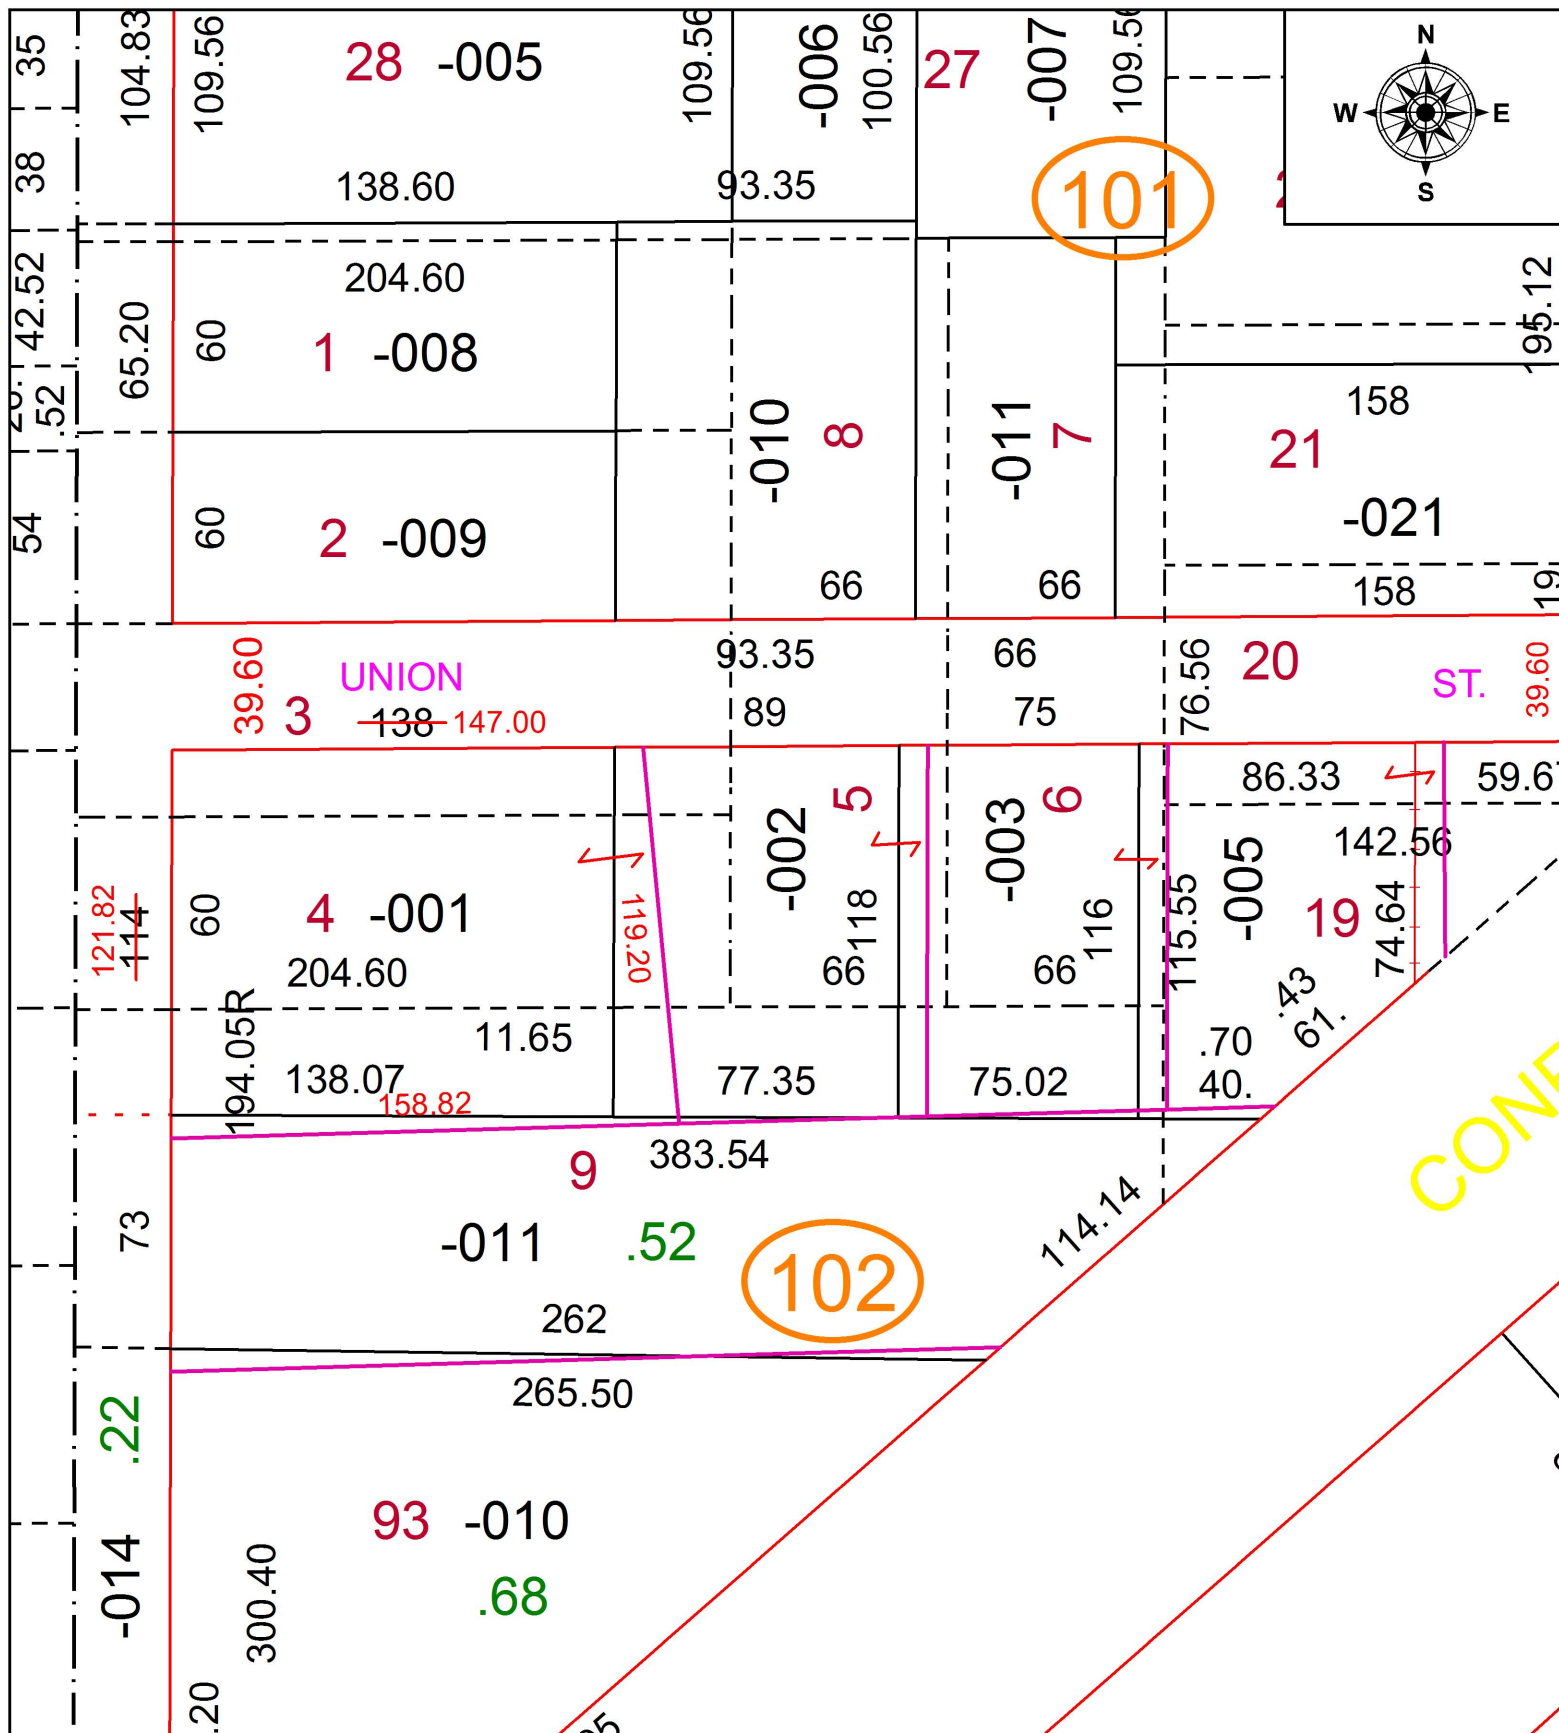

SPLITS/DEEDS PROCESSED
 LORAIN COUNTY TAX MAP DEPARTMENT
 226 MIDDLE AVE. ELYRIA, OH

SURVEYED BY: THOMAS SIMON
 CLOSURE: 1: 33,000
 MAP PAGE(S): 15-00-055
 APPROVED BY: TJS DATE: 1/17/17
 SCALE: 1" = 60 PRIOR INSTRUMENT: 2001-0725709