

PARENT PARCEL: 14-00-133-000-003, -008

CHILD PARCEL: 14-00-133-000-009 THRU -013



STARTING POINT: INTERSECTION OF C/L OF PITTS RD. AND C/L OF MERRIAM RD.

16-03597



133

~~008~~
~~94.58~~
~~010~~
~~92.49~~
-013
89.05

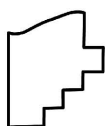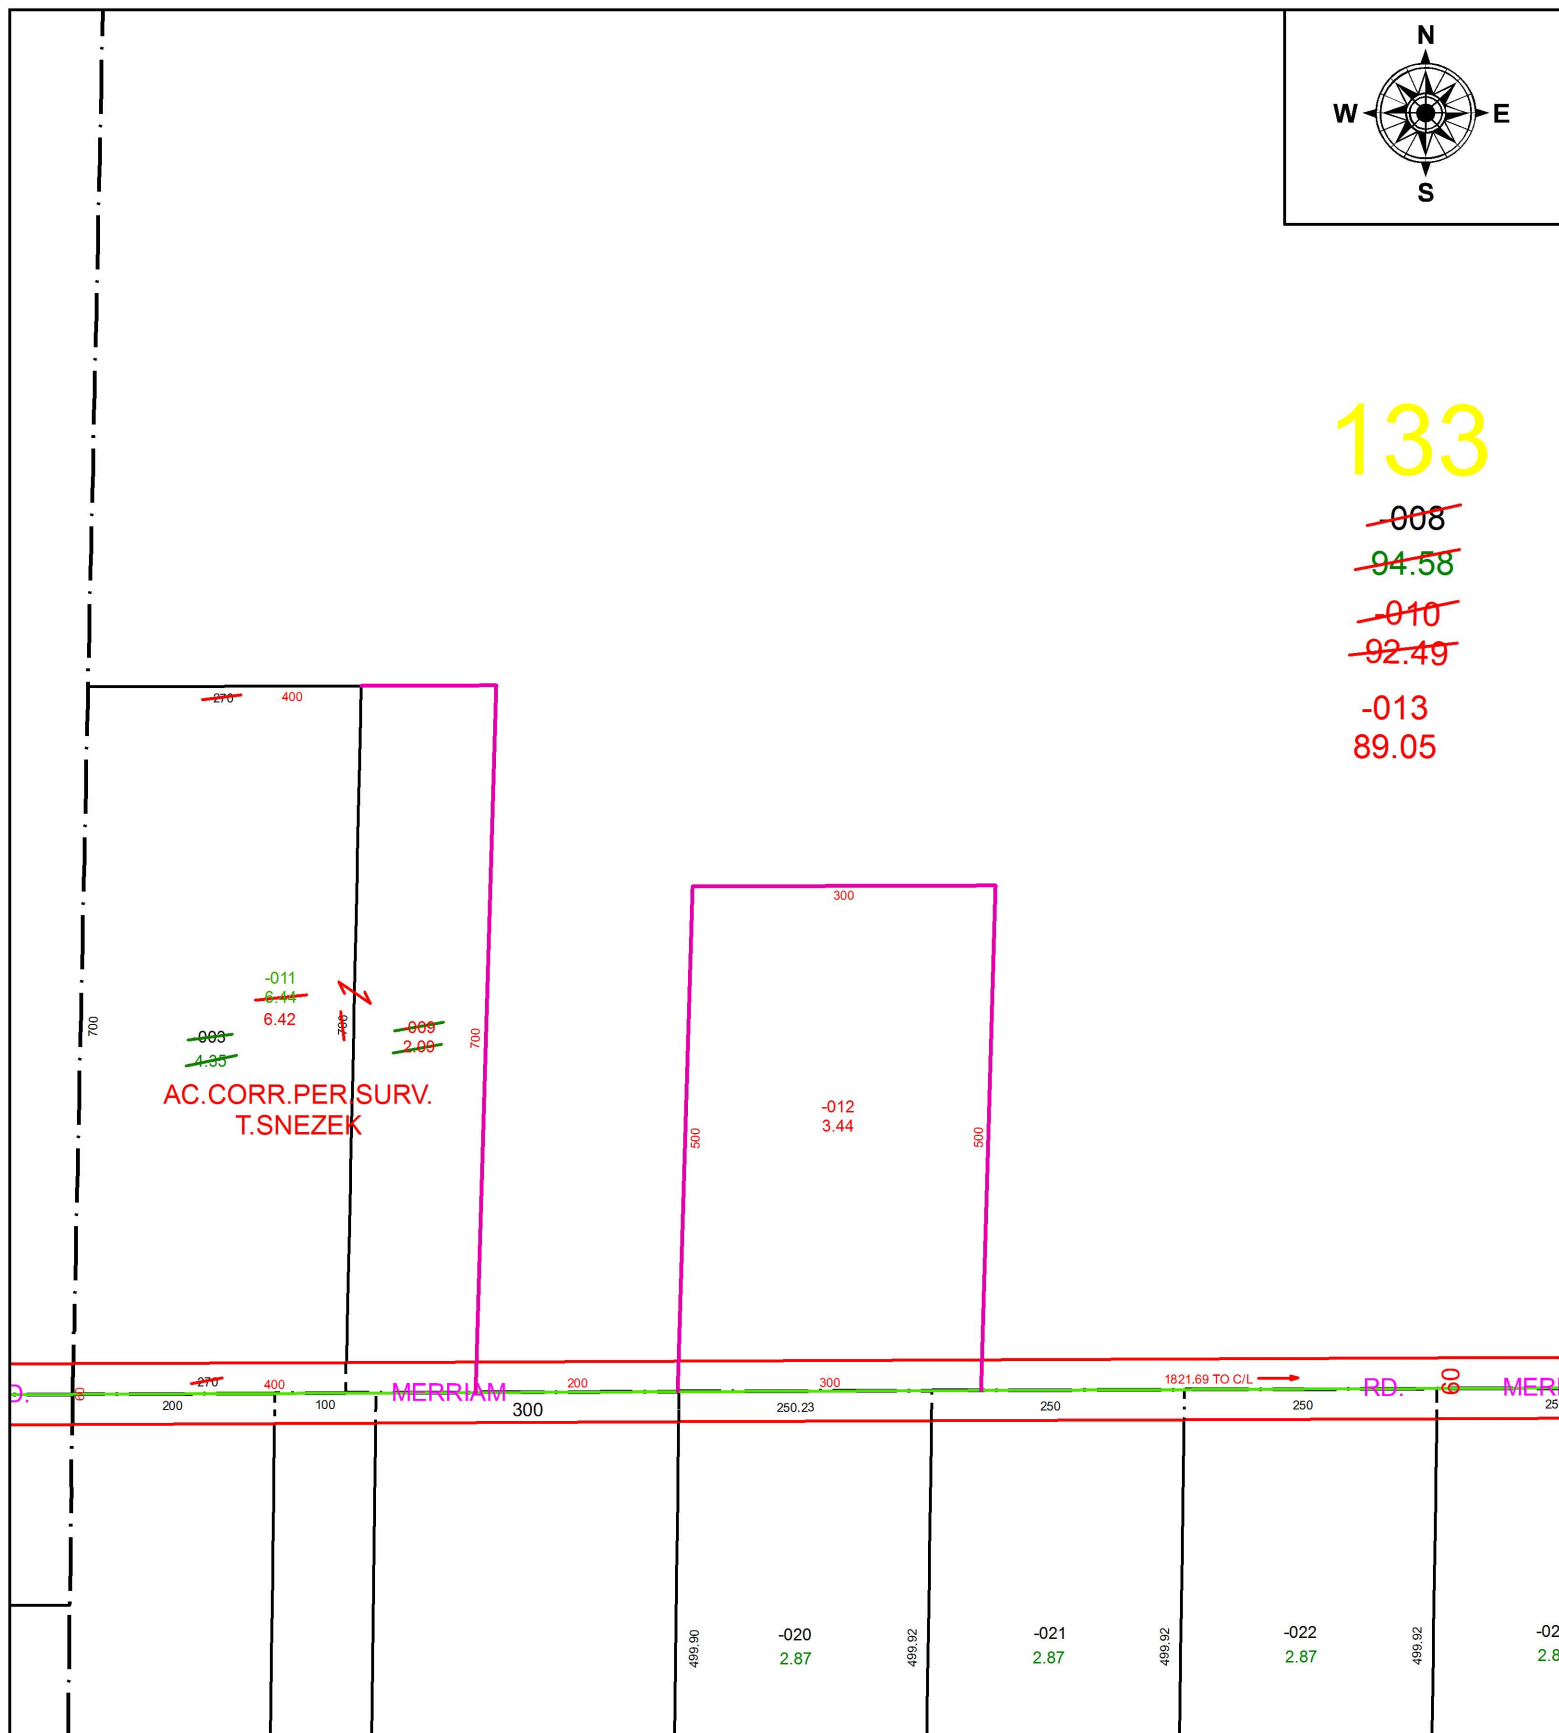

SPLITS/DEEDS PROCESSED
LORAIN COUNTY TAX MAP DEPARTMENT
226 MIDDLE AVE. ELYRIA, OH

SURVEYED BY: THOMAS M. SNEZEK
CLOSURE: 1: 2147483648
MAP PAGE(S): 14-00-133
APPROVED BY: RRM DATE: 11-14-16
SCALE: 1" = 190 PRIOR INSTRUMENT: OR 604/573