
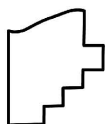


PARENT PARCEL: 16-00-091-000-046

CHILD PARCEL: ACREAGE CORR. PER EXCEPTION DV 219 PG. 616

STARTING POINT: S.W CORNER OF HAURY DV 389/301

17-03600-C

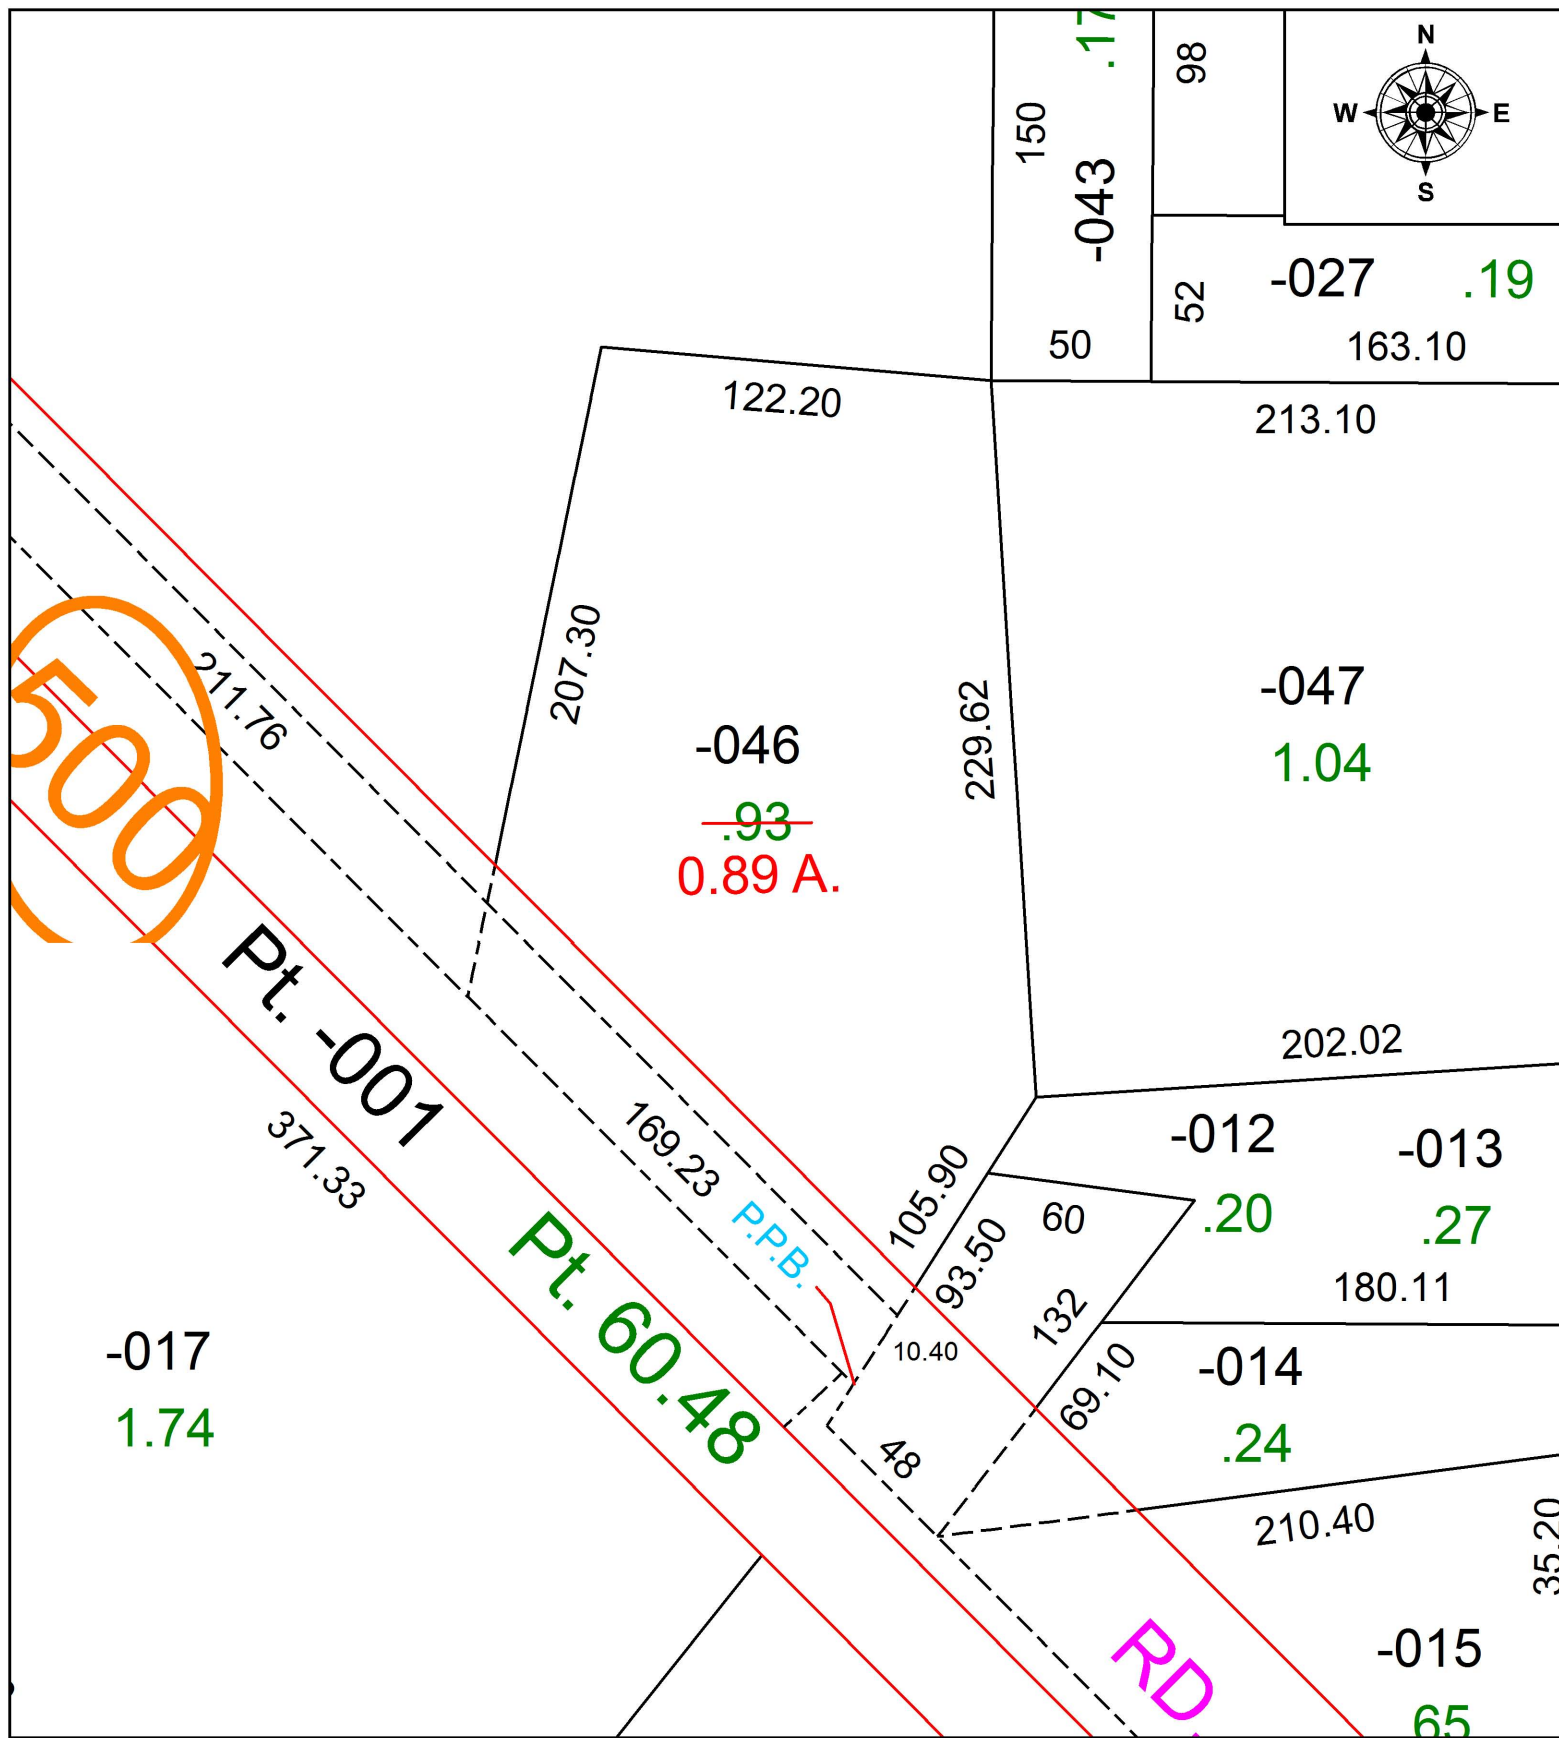

SPLITS/DEEDS PROCESSED
 LORAIN COUNTY TAX MAP DEPARTMENT
 226 MIDDLE AVE. ELYRIA, OH

SURVEYED BY: DAVID ELWELL
 CLOSURE: 1: 33,000
 MAP PAGE(S): 16-00-091
 APPROVED BY: TJS DATE: 1/26/17
 SCALE: 1" = 60' PRIOR INSTRUMENT: 1997-0445575