

PARENT PARCEL: 06-25-163-000-002

CHILD PARCEL: 06-25-163-000-002, 06-25-162-101-063

STARTING POINT: SOUTHEAST CORNER OF O.L.163


17-03602-C



163


-035
1.98

ADD TO DUP.
06-25-162-101-063
0.26 A.
IN THE NAME OF:
JAMES LOUIS DALL TRUSTEE

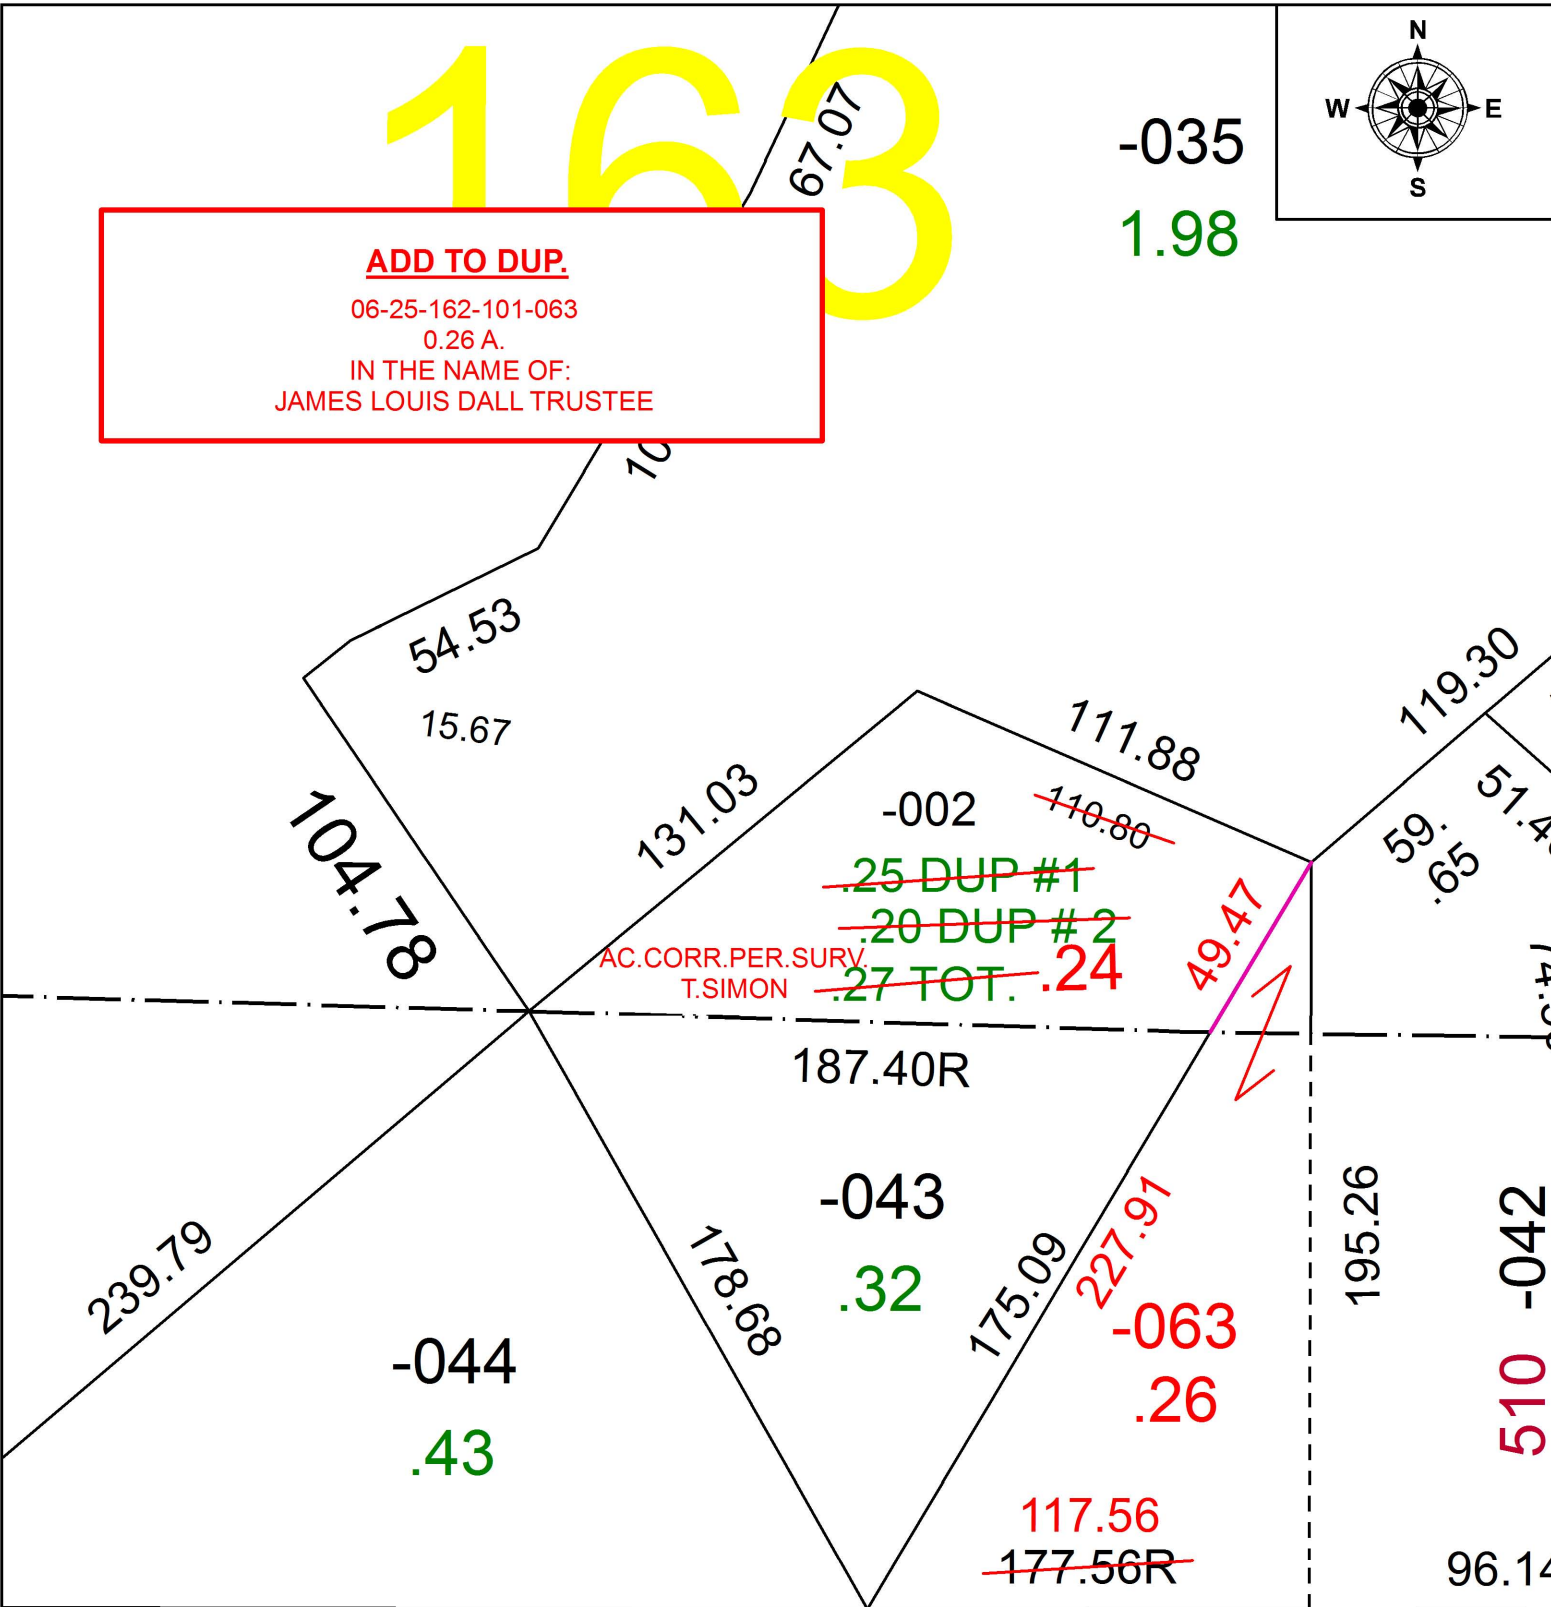

AC. CORR. PER. SURV.
T. SIMON

~~.25 DUP #1~~
~~.20 DUP #2~~
~~.27 TOT. .24~~

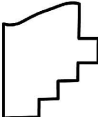
SPLITS/DEEDS PROCESSED
LORAIN COUNTY TAX MAP DEPARTMENT
226 MIDDLE AVE. ELYRIA, OH

SURVEYED BY: THOMAS A SIMON
CLOSURE: 1: 588,052
MAP PAGE(S): 6-67
APPROVED BY: RRM DATE: 2-8-17
SCALE: 1" = 50 PRIOR INSTRUMENT: 20090281919