
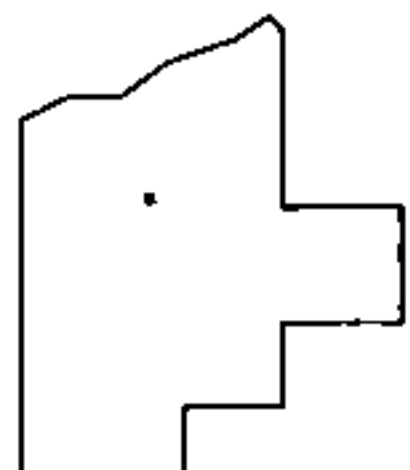
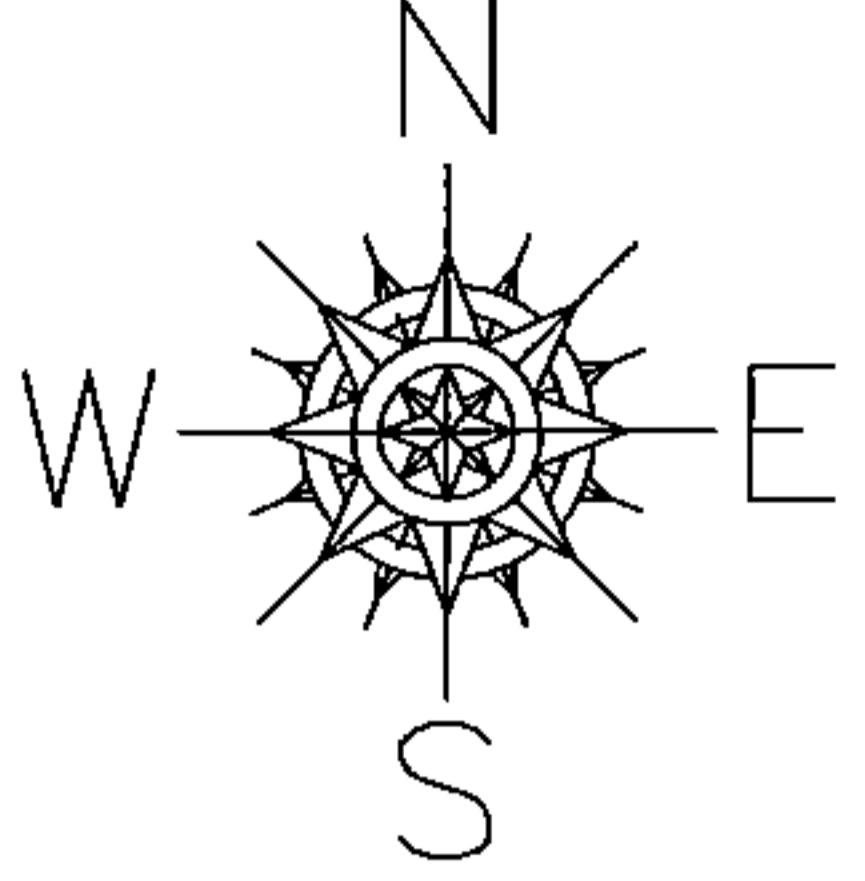


PARENT PARCEL: 04-00-007-101-044
 CHILD PARCEL: 04-00-007-101-051 & -052
 STARTING POINT: I.P. FOUND, NORTHERLY R.O.W OF LAKE RD. & EAST LINE OF KOPF LAND INST. # 2007-0216630

16-03606

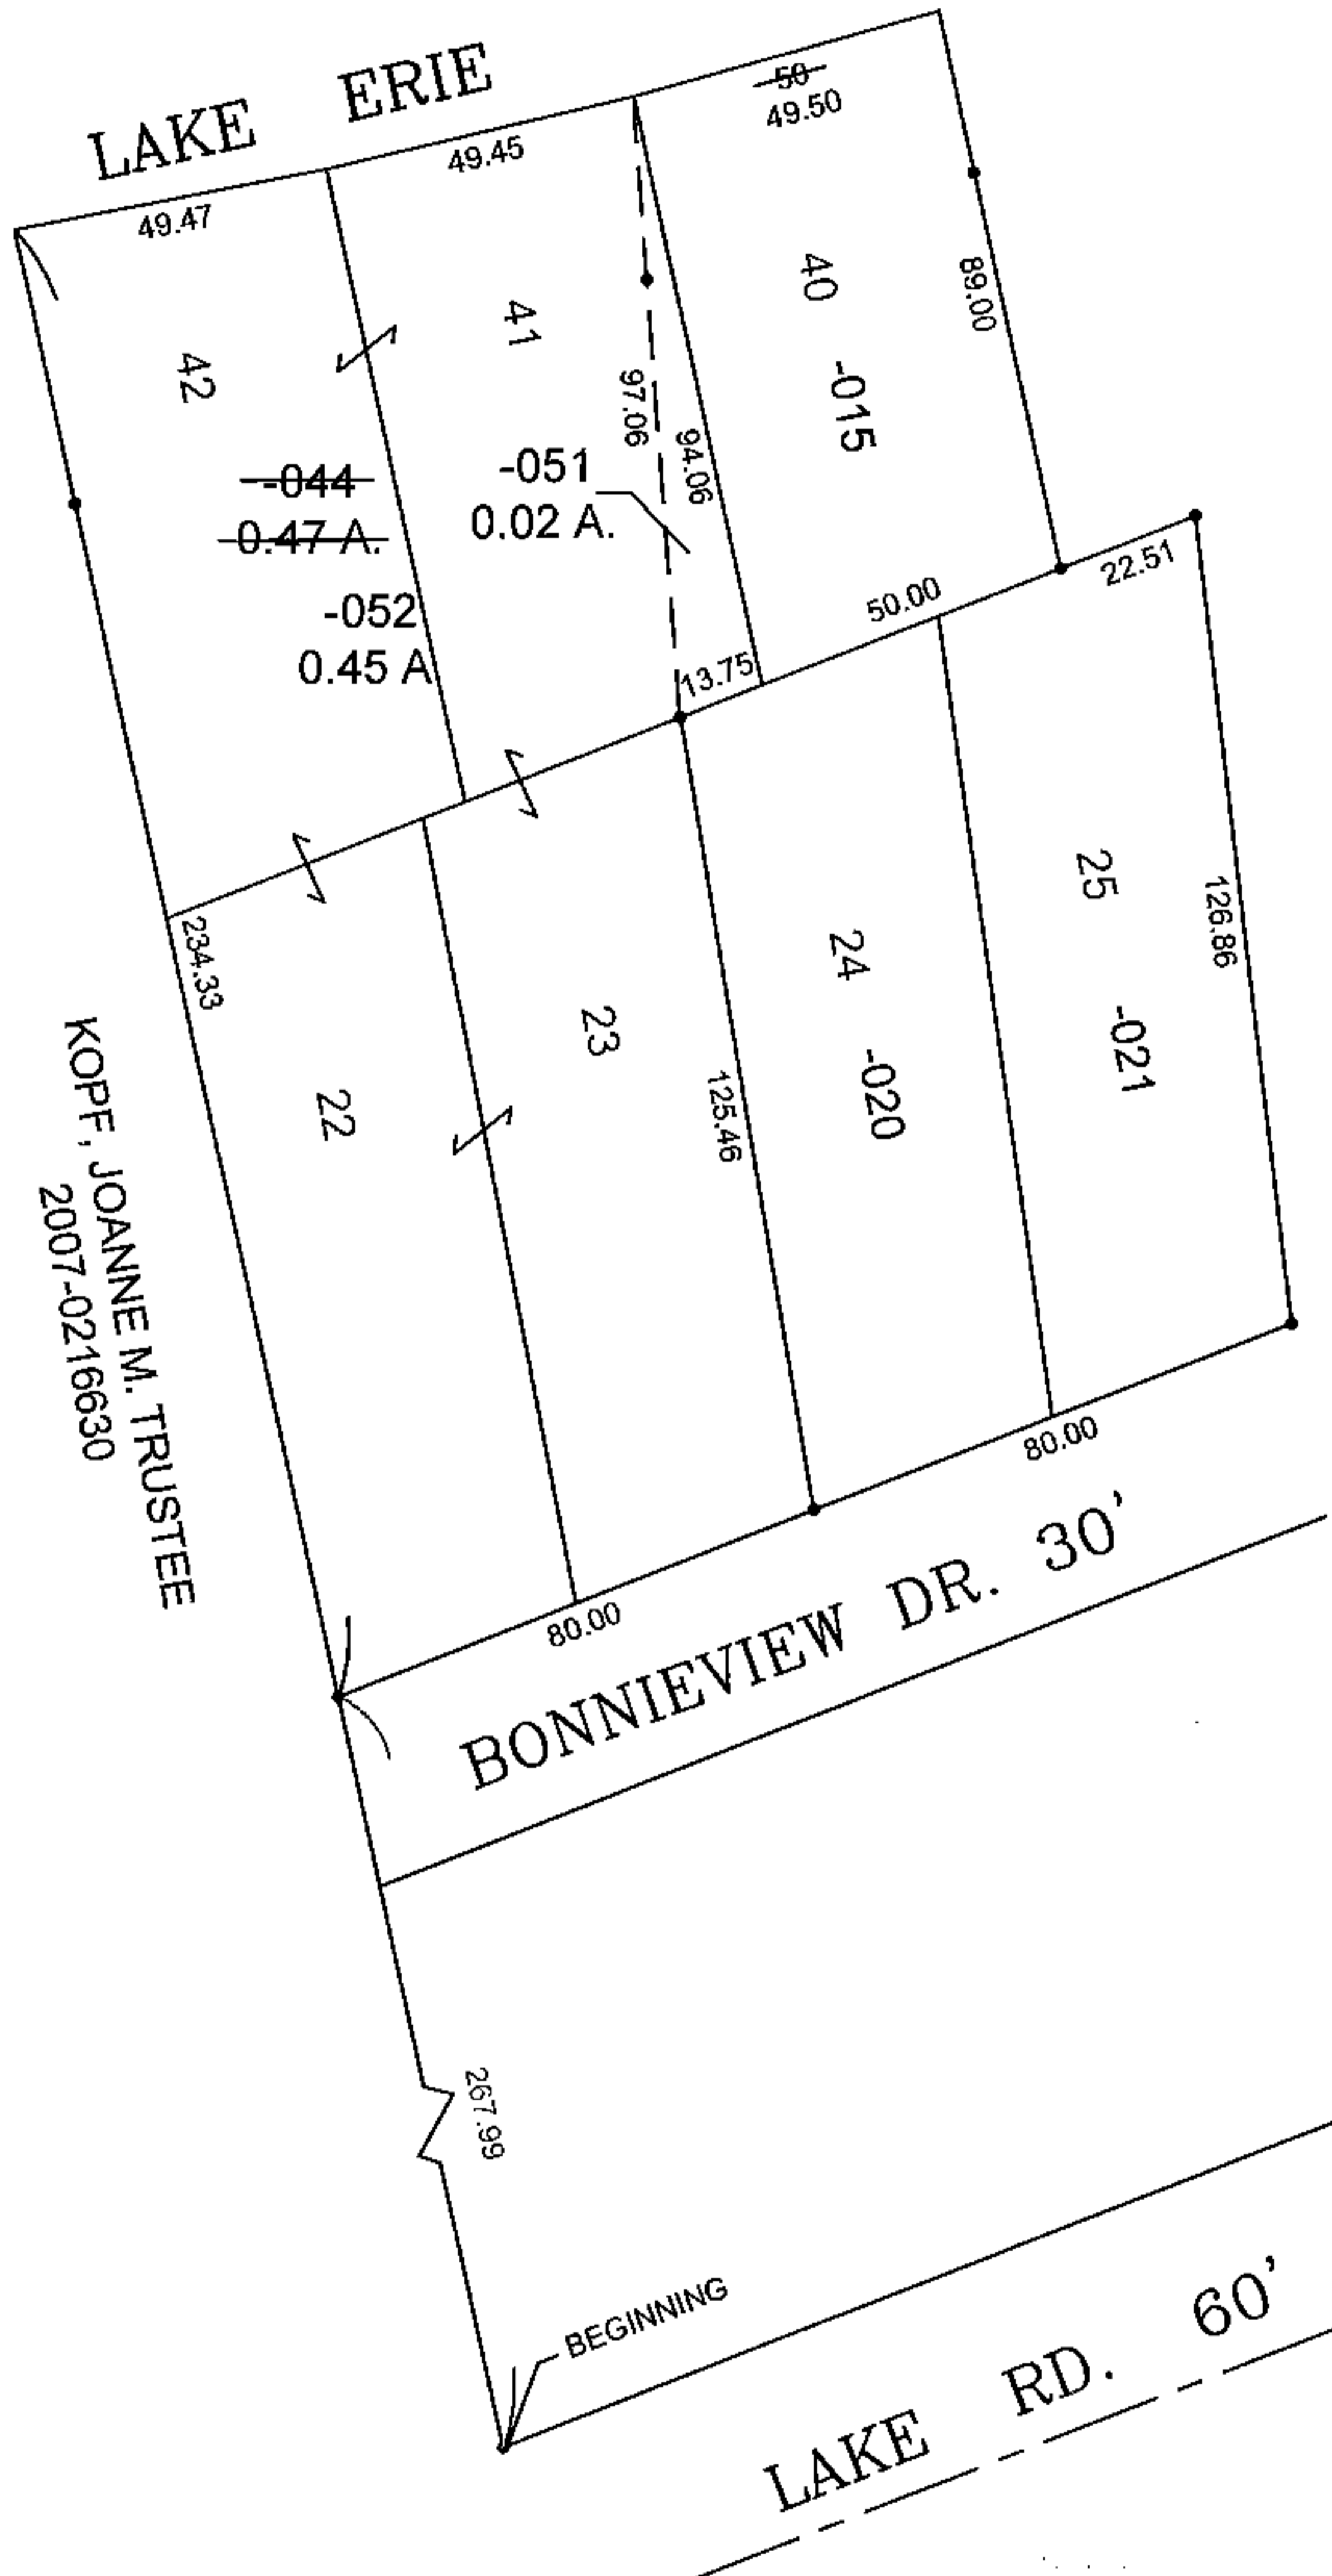

SPLITS/DEEDS PROCESSED
 LORAIN COUNTY TAX MAP DEPARTMENT
 226 MIDDLE AVE. ELYRIA, OHIO

SURVEYED BY: SEAN A. BOLAND
 CLOSURE: 0.01 : 10,000
 MAP PAGE(S): 04-00-007
 APPROVED BY: TJS DATE: 12/14/16
 SCALE: 1"= 50' PRIOR INST.: 2016-0606425